

Summary Lead Appr: WW Clerk: _____ Lead Clerk: _____ Appr: _____ Print Date:

1/23/2024

Acct ID: 541653 MTL: 093E270000200 Date: 2/23/24 Appr: GWK Prop Class: 660 RMV Prop Class: 660
Situs: 13100 GATES HILL RD SE GATES OR 97346 MaSaNh: 01 06 000 Unit: 146408 Year: 2024

Last Date Appraised: 04/11/2022 Appraiser: CLINT LUKE Retag: Y N Tag info: 2024 - NEW CONSTRUCTION (Residence)

Owner: HAMPTON-CAMPBELL,LINDA MARIE ELIZABETH & Roll Type: R

⓪ Cycle Tag Sales Verification Other: _____ Inspection level: 1 2 3 4 LCB TTO INSP AV: 8803

RMV Land: 80590 RMV Imp: 0 RMV Total: 80590 MAV: 0 MSAV: 8803 SAV: 15591

Comment: 22-23: L4 4.11.22 CL

JUST WANT TO GET 24-25 TAGS -
TAG 5-1-25 FOR FOLLOW UP ON REPLANT
FROM BC WILDFIRE

Notations

RP/MS	Code	Description
RP	STF	SMALL TRACT FORESTLAND

OSDs

No OSD data available.

Land

Site: 1 Code Area: 56490 Size: 80.00 Acres Use Code: 005 Zone: REST SAV Use: 011 Exception: 0
 Class: STFC Value Source: Small Tract Forest land Description: SMALL TRACT FORESTLAND C RMV: 80590 Exception: Y N
 Adjustment(s): TCVVT Fire Patrol: SA004 Description: FIRE PATROL
 Comments: Liability year - 1978, STF - 2004 / 22-23: Cycle, N/C
 03-04: REAPPRAISAL //04-05: STF APPROVED_

Improvements - Residence / Manufactured Structures

No residence or manufactured structure improvement data available.

Improvements - Accessory Buildings


No improvement data available for all other stat class types.

SKETCH/AREA TABLE ADDENDUM

SUBJECT INFO

File No.: 541653 Parcel No.: 093E270000200
 Property Address: 13100 GATES HILL ROAD
 City: GATES County: MARION State: OR ZipCode: 97346
 Owner:
 Client: Client Address:
 Appraiser Name: Inspection Date:

SKETCH

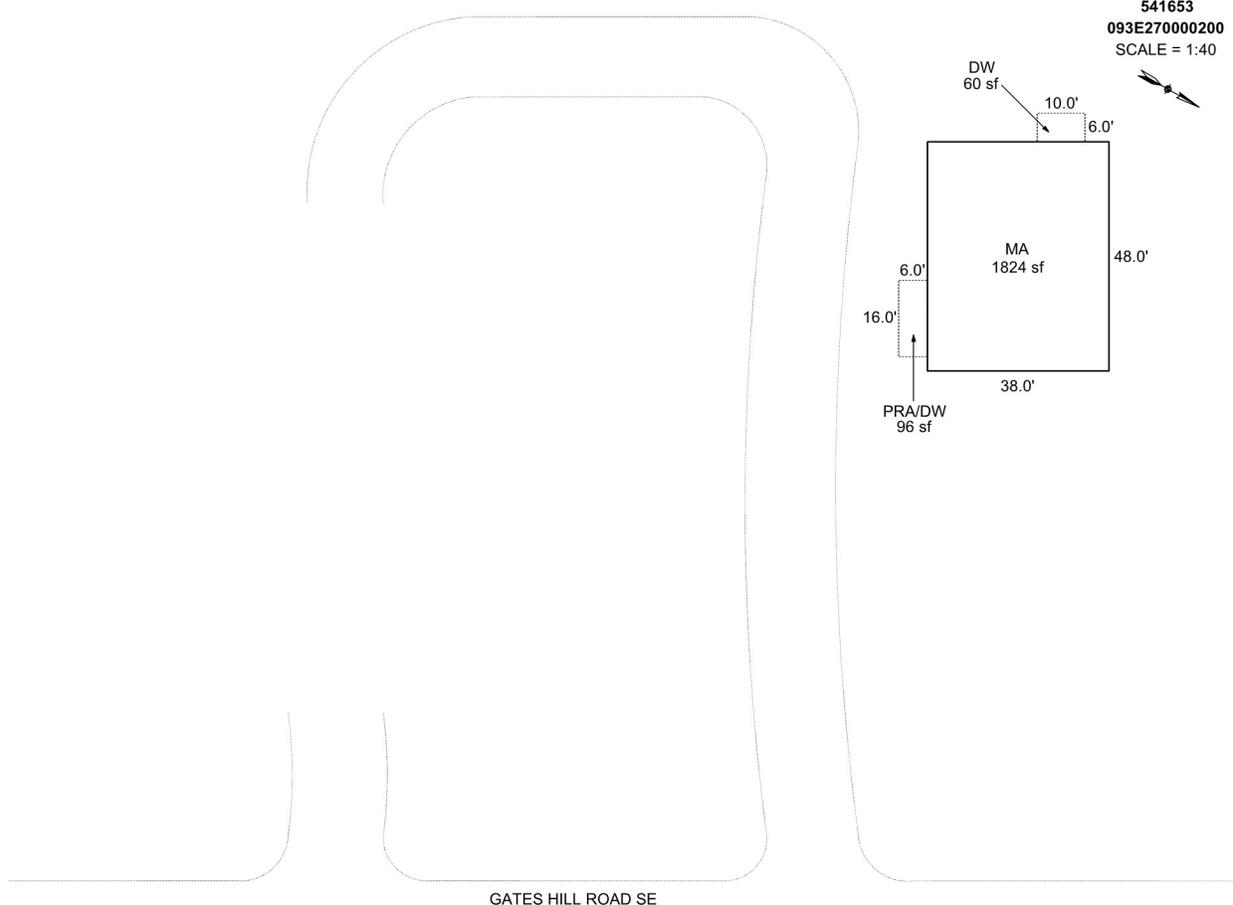

Sketch by Apex Sketch

AREA CALCULATIONS SUMMARY

Code	Description	Factor	Net Size	Perimeter	Net Totals
GLA1	MA	1.0	1824.0	172.0	1824.0
P/P	DW	1.0	60.0	32.0	
	PRA/DW	1.0	96.0	44.0	156.0

COMMENT TABLE 1

APEX BY CJURAN 01/09/2023 555-22-008832
 UPDATED BY CJURAN 11/02/2023

COMMENT TABLE 2

CL 10/05/2023

COMMENT TABLE 3

TAGS L2

Net LIVABLE cnt 1 (rounded) 1,824