

Summary Lead Appr: WW Clerk: _____ Lead Clerk: _____ Appr: MDL Print Date: 3/25/2024

Acct ID: 128196 MTL: 082W10C000900P1 Date: 4/1/24 Appr: MDL Prop Class: 049 RMV Prop Class: 049

Situs: 6606 JOSEPH ST SE SALEM, OR 97317 MaSaNh: 07 06 000 Unit: 148142 Year: 2024

Last Date Appraised: _____ Appraiser: MATT LORD Retag: Y N Tag info: 2024 - Tags/Permit (Fire)

Owner: TAYLOR, SHAUN S Roll Type: MS

Cycle Tag Sales Verification Other: _____ Inspection level: 1 2 3 4 LCB TTO INSP AV: 12830

RMV Land: 0 RMV Imp: 19550 RMV Total: 19550 MAV: 12830 MSAV: 0 SAV: 0

Comment: MFD STRUCT SERIAL # WAFL1A836641292, X # X00146504 ON REAL ACCT 082W10C 00900, REAL MS

Notations 24-25 M3 fire

No notation data available.

OSDs

No OSD data available.

Land

No land data available.

Improvements - Residence / Manufactured Structures **CHG TO NV**

Bldg: 1 Code Area: 05410 Stat Class: 454 Year Blt: 1977 Eff Year Blt: 1977 Sq.Ft: 924 % Complete: 100
Desc: MANUF STRUCT, CLASS 5, 14' WIDE SINGLE Dimensions: 66x14 RMV: 19550
Func Obsc: 100 Econ %: 100 Other %: 100 Exception: 0 Adjust: Adjust RMV: 0

Floors

Type	Class	Display Group	Floor Size	Beds	Baths	Yr Blt	Eff Yr Blt	Inventory	Exception: Y N
First Floor	5	Finished	924	3	FB-1	1977	1977	SKIRT, ROOF+, BATH - 1, HVAC+, KIT-	Y N


Accessories

Description	Class	Size SqFt	Eff Yr Blt	RMV	Quantity
No accessory data available					

Improvements - Accessory Buildings

No improvement data available for all other stat class types.

R29652
082W10C 00900
SCALE=1:20

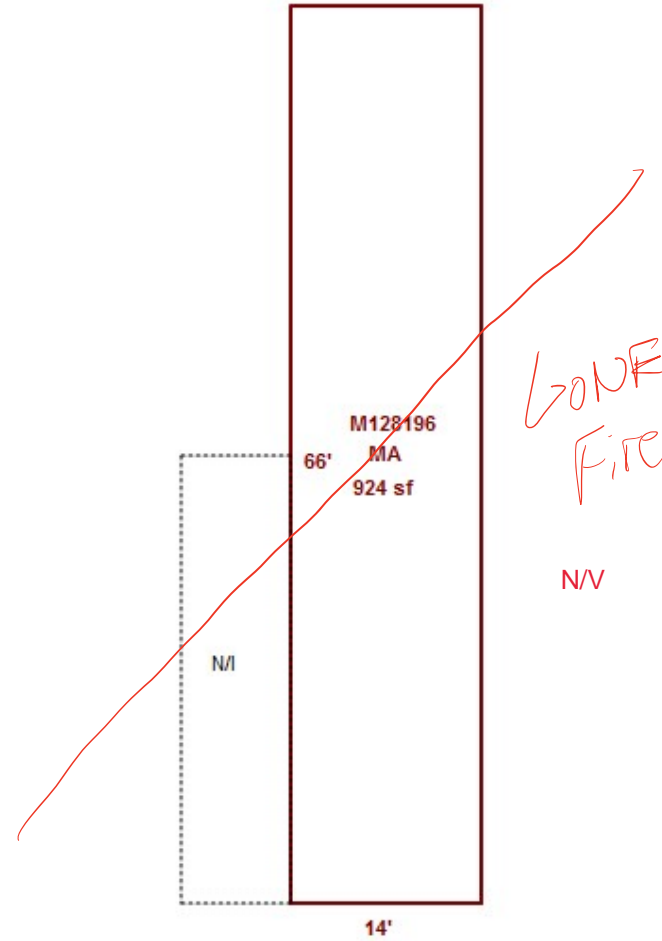



4/1/24

