

Acct ID: 556295 MTL: 106E22AD01100 Date: **1-4-24** Appr: **CLINT** Prop Class: 459 RMV Prop Class: 459
 Situs: 49870 NORTH SANTIAM HWY SE IDANHA OR 97350 MaSaNh: 01 06 000 Unit: 109495 Year: 2024
 Last Date Appraised: 03/27/2019 Appraiser: CLINT LUKE Retag: **Y** **INPUT 1-24-24 ENCL** Tag info: 2024 - Tags/Permit (Addition)
 Owner: FRASER, PHILLIP JOHN Roll Type: R
 Cycle: **Tag** Sales Verification Other: Inspection level: **1 2 3 4** LCB TTO INSP AV: 87880
 RMV Land: 198120 RMV Imp: 72800 RMV Total: 270920 MAV: 87880 MSAV: 0 SAV: 0
 Comment:

ADD ADDN e 70% RETAG

Notations

RP/MS	Code	Description
MS	PERM	PERMANENTLY DISQUALIFIED FROM FARM/FOREST
RP	PERM	PERMANENTLY DISQUALIFIED FROM FARM/FOREST

OSDs

Count	Code	Description	RMV	Code Area	Exception
1	MKTN	OSD - NO LANDSCAPE	30000	56520	0

Land

Site: 1 Code Area: 56520 Size: 1.34 Acres Use Code: 005 Zone: REST SAV Use: Exception: 0
 Class: Value Source: Permanently Disqualified Description: RMV: 168120 Exception: Y N
 Adjustment(s): H2OGR Fire Patrol: SA004 Description: FIRE PATROL
 Comments: 99-2000; M/H SET UP COMPL. ADD DF,PR, ADD OSD, PULL FROM MAINT_ . 2003-04 REAPPRAISAL.

Improvements - Residence / Manufactured Structures

Bldg: 1 Code Area: 56520 Stat Class: 467 + Year Blt: 1998 Eff Year Blt: 1998 Sq.Ft: 1040 % Complete: 100
 Desc: MANUF STRUCT, CLASS 6, 26' THROUGH 28' WIDE DOUBLE Dimensions: RMV: 57770
 Func Obsc: 100 Econ %: 100 Other %: 100 Exception: 0 Adjust: Adjust RMV: 0

Floors

Type	Class	Display Group	Floor Size	Beds	Baths	Yr Blt	Eff Yr Blt	Inventory	Exception
First Floor	6 +	Finished	1040	3	FB-2	1998	1998	SKRT+, HVAC+, KIT-, FP, ROOF, BATH - 2	Y N

Accessories

Description	Class	Size SqFt	Eff Yr Blt	RMV	Quantity
No accessory data available					

Bldg: 2 Code Area: 56520 Stat Class: 108 Year Blt: 1998 Eff Year Blt: 1998 Sq.Ft: 0 % Complete: 100
 Desc: Residential Other Improvements Dimensions: RMV: 15030
 Func Obsc: 100 Econ %: 100 Other %: 100 Exception: 0 Adjust: Adjust RMV: 0

Floors

Type	Class	Display Group	Floor Size	Beds	Baths	Yr Blt	Eff Yr Blt	Inventory
No floor data available								

Accessories

Description	Class	Size SqFt	Eff Yr Blt	RMV	Quantity
DECK	1	208	1998	4027	1
DECK	1	294	1998	5692	1
ROOF EXTENSION OR PATIO COVER	1	208	1998	5308	1

Improvements - Accessory Buildings

No improvement data available for all other stat class types.

Converted to MANUF
w/ 9' common wall

ACCOUNT # 556295 DATE: 1-4-24 RMV CLASS _____ PROP CLASS _____
MTL _____ APPR Gene TAG 0 N _____

COMMENTS: Per plans 2 BED 1 BATH + LAUNDRY COMBO

RESIDENCE / MANUFACTURED STRUCTURES

ACCESSORY IMPROVEMENTS / OUTBUILDINGS

STAT 4 QLTY + - FLOOR MA
 AREA 641 EFF AREA 641 BED 2
 ROOF + HVAC +
 BATH PKG: 1 BATH BATH + 1/2 BTH
 FIREPLACE: _____
 KITCHEN - + AVE NO KITCHEN
 YR BLT 2023 EFF YR 2023 ECON _____
 % COMP 70 % GOOD _____ FUNC _____
 EXCEPT 0 N LUMP SUM: _____
 MISC: _____
 YI CLASS _____ F G A E
 SKIRT - LIN FT _____
 COMMENT: _____

STAT 3 QLTY 0 - FLOOR ATTF
 AREA 177 EFF AREA 177 BED _____
 ROOF + HVAC +
 BATH PKG: _____ BATH BATH + 1/2 BTH
 FIREPLACE: _____
 KITCHEN - + AVE HEAT
 YR BLT 2023 EFF YR 2023 ECON _____
 % COMP 70 % GOOD _____ FUNC _____
 EXCEPT 0 N LUMP SUM: _____
 MISC: _____
 YI CLASS _____ F G A E
 SKIRT - LIN FT _____
 COMMENT: _____

STAT _____ QLTY + - FLOOR _____
 AREA _____ EFF AREA _____ BED _____
 ROOF + HVAC +
 BATH PKG: _____ BATH BATH + 1/2 BTH
 FIREPLACE: _____
 KITCHEN - +
 YR BLT _____ EFF YR _____ ECON _____
 % COMP _____ % GOOD _____ FUNC _____
 EXCEPT Y N LUMP SUM: _____
 MISC: _____
 YI CLASS _____ F G A E
 SKIRT - LIN FT _____
 COMMENT: _____

TYPE _____
 STAT / CLASS _____
 SIZE _____
 FAIR
 AVERAGE
 GOOD
 EXCELLENT
 BATH _____
 YR BLT _____
 EFF YR _____
 % COMP _____
 EXCEPT Y N
 MISC: _____
 COMMENT: _____

TYPE _____
 STAT / CLASS _____
 SIZE _____
 FAIR
 AVERAGE
 GOOD
 EXCELLENT
 BATH _____
 YR BLT _____
 EFF YR _____
 % COMP _____
 EXCEPT Y N
 MISC: _____
 COMMENT: _____

TYPE _____
 STAT / CLASS _____
 SIZE _____
 FAIR
 AVERAGE
 GOOD
 EXCELLENT
 BATH _____
 YR BLT _____
 EFF YR _____
 % COMP _____
 EXCEPT Y N
 MISC: _____
 COMMENT: _____

TYPE _____
 STAT / CLASS _____
 SIZE _____
 FAIR
 AVERAGE
 GOOD
 EXCELLENT
 BATH _____
 YR BLT _____
 EFF YR _____
 % COMP _____
 EXCEPT Y N
 MISC: _____
 COMMENT: _____

Percent Complete Form

Account #

522 295

Additions

New Homes

Additions		New Homes				
% Item	% Sum		No Basement		Basement	
			% Item	% Sum	% Item	% Sum
3%		Plans/Survey	3%		3%	
2%	0%	Excavation	2%	0%	4%	0%
3%		Foundation	3%		10%	
35%	45%	Framing	14%	20%	16%	35%
8%	50%	Trusses	7%	30%	7%	40%
7%	60%	Roofing	7%	35%	7%	45%
7%	65%	Windows/Ext Doors	7%	45%	6%	55%
5%	70%	Siding	5%	50%	5%	60%
4%	75%	Plumbing Rough-In	4%	55%	3%	65%
3%		Electrical Rough-In	6%		2%	
2%	80%	Heating Rough-In	2%	60%	1%	65%
		Heating Unit	1%		1%	
3%		Insulation	3%		2%	
5%	85%	Drywall (Finished)	5%	65%	4%	70%
2%	90%	Paint Interior	2%	70%	2%	75%
2%		Paint Exterior	2%		2%	
		Cabinets	6%	75%	5%	80%
2%	95%	Electrical Fixtures	3%	85%	2%	85%
2%		Plumbing Fixtures	4%		3%	
3%	100%	Floor Coverings & Countertops	7%	90%	6%	90%
2%		Interior Trim Carpentry	7%		6%	
		Porch/Entry/Stoop	2%		2%	
		Finish Grade	1%	100%	1%	100%

APPR *600* Date *1-4-24* YR For *1-4-24* % COMP *70*
 APPR _____ Date _____ YR For _____ % COMP _____
 APPR _____ Date _____ YR For _____ % COMP _____
 APPR _____ Date _____ YR For _____ % COMP _____

Percent Complete Form

Account # _____

Gut & Remodels

Interior Trim Carpentry	7%	90%
Floor Coverings & Countertops	7%	85%
Plumbing Fixtures	4%	80%
Electrical Fixtures	3%	80%
Cabinets	6%	75%
Drywall (Finished)	5%	70%
Insulation	3%	65%

APPR _____ Date _____ YR For _____ % COMP _____
 APPR _____ Date _____ YR For _____ % COMP _____
 APPR _____ Date _____ YR For _____ % COMP _____
 APPR _____ Date _____ YR For _____ % COMP _____

Outbuilding Type: _____

	% Item	% Sum
Excavation/Foundation	10%	40%
Floor - Concrete/Wood	30%	
Walls - Framing	10%	65%
Walls - Covering/Siding	15%	
Roof - Framing/Trusses	15%	
Roof - Sheathing	5%	95%
Roof - Cover	10%	
Doors & Windows	5%	100%


APPR _____ Date _____ YR For _____ % COMP _____
 APPR _____ Date _____ YR For _____ % COMP _____
 APPR _____ Date _____ YR For _____ % COMP _____
 APPR _____ Date _____ YR For _____ % COMP _____

SKETCH/AREA TABLE ADDENDUM

SUBJECT INFO

File No.: 556295 Parcel No.: 106E22AD01100
 Property Address: 49870 NORTH SANTIAM HY SE
 City: IDANHA County: MARION State: OR ZipCode: 97350
 Owner:
 Client: Client Address:
 Appraiser Name: Inspection Date:

SKETCH

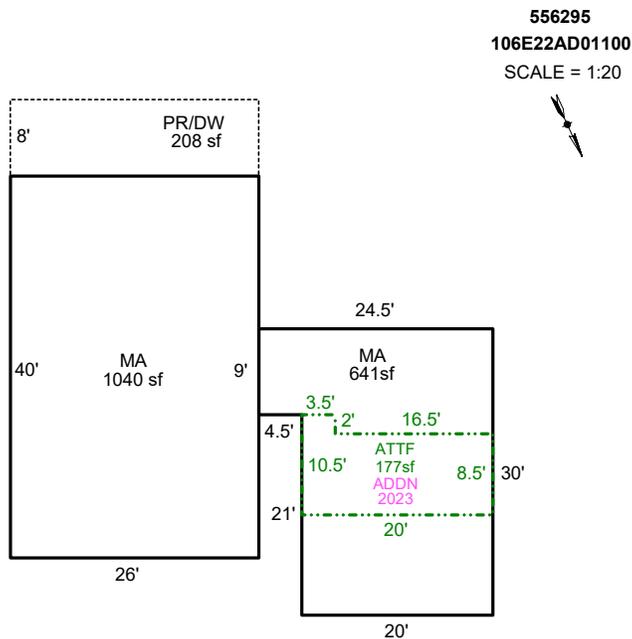

Sketch by Apex Sketch


AREA CALCULATIONS SUMMARY						COMMENT TABLE 1		
Code	Description	Factor	Net Size	Perimeter	Net Totals			
GLA1	MA	1.0	1040.0	132.0		DRAWN BY JRONDEMA 9/6/18 UPDATED BY CJURAN 08/21/2023 555-23-003680 UPDATED BY CJURAN 01/25/2024		
	MA	1.0	640.5	109.0	1680.5			
GLA2	ATTF	1.0	177.0	61.0	177.0			
P/P	PR/DW	1.0	208.0	68.0	208.0			
Net LIVABLE						cnt	3 (rounded)	1,858
						COMMENT TABLE 2	COMMENT TABLE 3	
						CL 01/04/2024	TAGS L2	

SKETCH/AREA TABLE ADDENDUM

SUBJECT INFO

File No.: 556295 Parcel No.: 106E22AD01100
 Property Address: 49870 NORTH SANTIAM HY SE
 City: IDANHA County: MARION State: OR ZipCode: 97350
 Owner:
 Client: Client Address:
 Appraiser Name: Inspection Date:

SKETCH

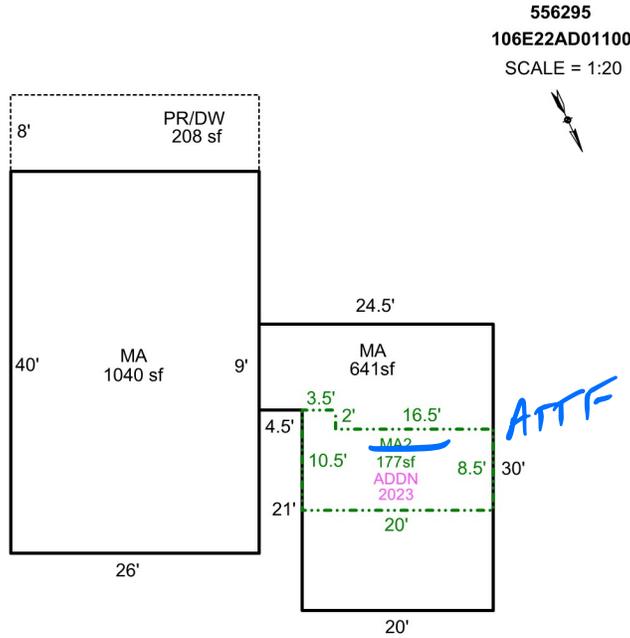

Sketch by Apex Sketch

AREA CALCULATIONS SUMMARY

Code	Description	Factor	Net Size	Perimeter	Net Totals
GLA1	MA	1.0	1040.0	132.0	
	MA	1.0	640.5	109.0	1680.5
GLA2	MA2	1.0	177.0	61.0	177.0
P/P	PR/DW	1.0	208.0	68.0	208.0

COMMENT TABLE 1

DRAWN BY JRONDEMA 9/6/18
 UPDATED BY CJURAN 08/21/2023 555-23-003680

COMMENT TABLE 2

← TABS L2

COMMENT TABLE 3

1424

Net LIVABLE cnt 3 (rounded) 1,858



1/4/24



1/4/24



