

Rural Work Order Cover Sheet

RAM Transaction #: 608653

Year: 24 - 25

Account Numbers Involved: 530004, 530009

Sequence #1: PARTITION PLAT PER MARION COUNTY PLA 22-005 THE EXISTING TAX LOT BOUNDARY MATCHES THE NEW PARCEL BOUNDARY. 530004 N/C

Sequence #2: PARTITION PLAT PER MARION COUNTY PLA 22-005 THE EXISTING TAX LOT BOUNDARY MATCHES THE NEW PARCEL BOUNDARY. 530009 +1.13

	Check For:				Forms Included:	
	Yes	No		Yes	No	✓
Move Building Permits	<input type="checkbox"/>	<input checked="" type="checkbox"/>	Fire Patrol (Email Supervisor)	<input type="checkbox"/>	<input checked="" type="checkbox"/>	<input checked="" type="checkbox"/>
Move Photos	<input type="checkbox"/>	<input checked="" type="checkbox"/>	Multi-Section	<input type="checkbox"/>	<input checked="" type="checkbox"/>	<input checked="" type="checkbox"/>
Update Apex	<input type="checkbox"/>	<input checked="" type="checkbox"/>	Tagged for 2 nd year Reset	<input type="checkbox"/>	<input checked="" type="checkbox"/>	<input checked="" type="checkbox"/>
Update Account Notes	<input checked="" type="checkbox"/>	<input type="checkbox"/>	Exemptions	<input type="checkbox"/>	<input checked="" type="checkbox"/>	<input type="checkbox"/>
PAT LIAB	<input type="checkbox"/>	<input checked="" type="checkbox"/>	Update Tracker	<input checked="" type="checkbox"/>	<input type="checkbox"/>	<input type="checkbox"/>
						<input checked="" type="checkbox"/>

Miscellaneous Notes: No change to 530004

Appraiser: MLH Date: 5/9/24

Appraisal Review: WW Date: 5.14.24

Data Entry: Chris Date: 5/22/24

Tax Year	Account ID	Transaction	Voucher Sequence	Recorded Date	Cartog	Operation	Voucher Notes	Code	+/- Size	Size Type
2024	530004	608653	1	3/6/2024 15:29	CGV	VALIDATION OF UNITS OF LAND	PARTITION PLAT PER MARION COUNTY PLA 22-005 THE EXISTING TAX LOT BOUNDARY MATCHES THE NEW PARCEL BOUNDARY.			
2024	530009	608653	2	3/6/2024 15:29	CGV	VALIDATION OF UNITS OF LAND	PARTITION PLAT PER MARION COUNTY PLA 22-005 THE EXISTING TAX LOT BOUNDARY MATCHES THE NEW PARCEL BOUNDARY.	92590	1.13	A



Rural Work Order Processing Form

One Page Per Account

1&
 Sequence #: 2 of 2 Account Number: 530009 MTL: 082W190000500 RAM Transaction ID: 608653

Type: COM LLA PPT SEG SUB AC R of W Vacate Map Maintenance

Account Details

Ma Sa Nh: 07/06/000 Prop Class: 551 RMV Class: 501

Assigned Appraiser: Matt Lord Part of Unit: Yes or No Fire Patrol: Yes or No

Land Fragment

Account From	Code Area	Liab Yr	Land Class	LUC	Value Source	# of Acres	Zone	Land Adjustments
530009	92590	1982	4HD	005	Farm Use EFU	29.20	REST	
530009	92590	1982	6H	005	Farm Use EFU	4.97	REST	FSOIL
530009	92590	2024	4HD	005	Farm Use EFU	1.13	REST	

Total Acres: 35.30

Improvements


Account From	Code Area	Imp ID	Stat Class	Description	Account From	Code Area	Imp ID	Stat Class	Description
No Change									

Adjustments: _____

Exception

New MAV: _____ Sys Calc No Change to MAV

08 2W 19
SALEM

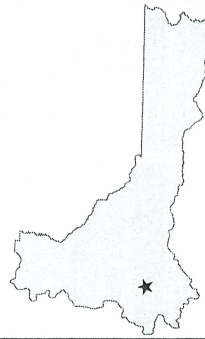

MARION COUNTY, OREGON
SEC 19 T8S R2W W.M.
SCALE 1" = 400'

LEGEND

- LINE TYPES**
- Taxlot Boundary
 - - - Historical Boundary
 - - - Road Right-of-Way
 - - - Easement
 - - - Railroad Right-of-Way
 - - - Railroad Centerline
 - - - Taxcode Line
 - - - Private Road ROW
 - - - Subdivision/Plat Boundary
 - - - Map Boundary
 - - - Waterline - Taxlot Boundary
 - - - Waterline - Non Boundary

- CORNER TYPES**
- + 1/4th Section Cor.
 - ⊕ 1/4 Section Cor.
 - ⊙ D/C Corner
 - ⊕ 16 1/2 Section Corner
 - ⊕ 21 1/2

NUMBERS
Tax Code Number
00000

Acres All areas listed are Net Acres, excluding any portions of the taxlot within public ROW's

NOTES
Tick Marks: A tick mark in the road indicates that the labeled dimension extends into the public ROW



CANCELLED NUMBERS


DISCLAIMER: THIS MAP WAS PREPARED FOR ASSESSMENT PURPOSES ONLY



FOR ADDITIONAL MAPS VISIT OUR WEBSITE AT www.co.marion.or.us

PLOT DATE: 4/10/2024


SALEM
08 2W 19

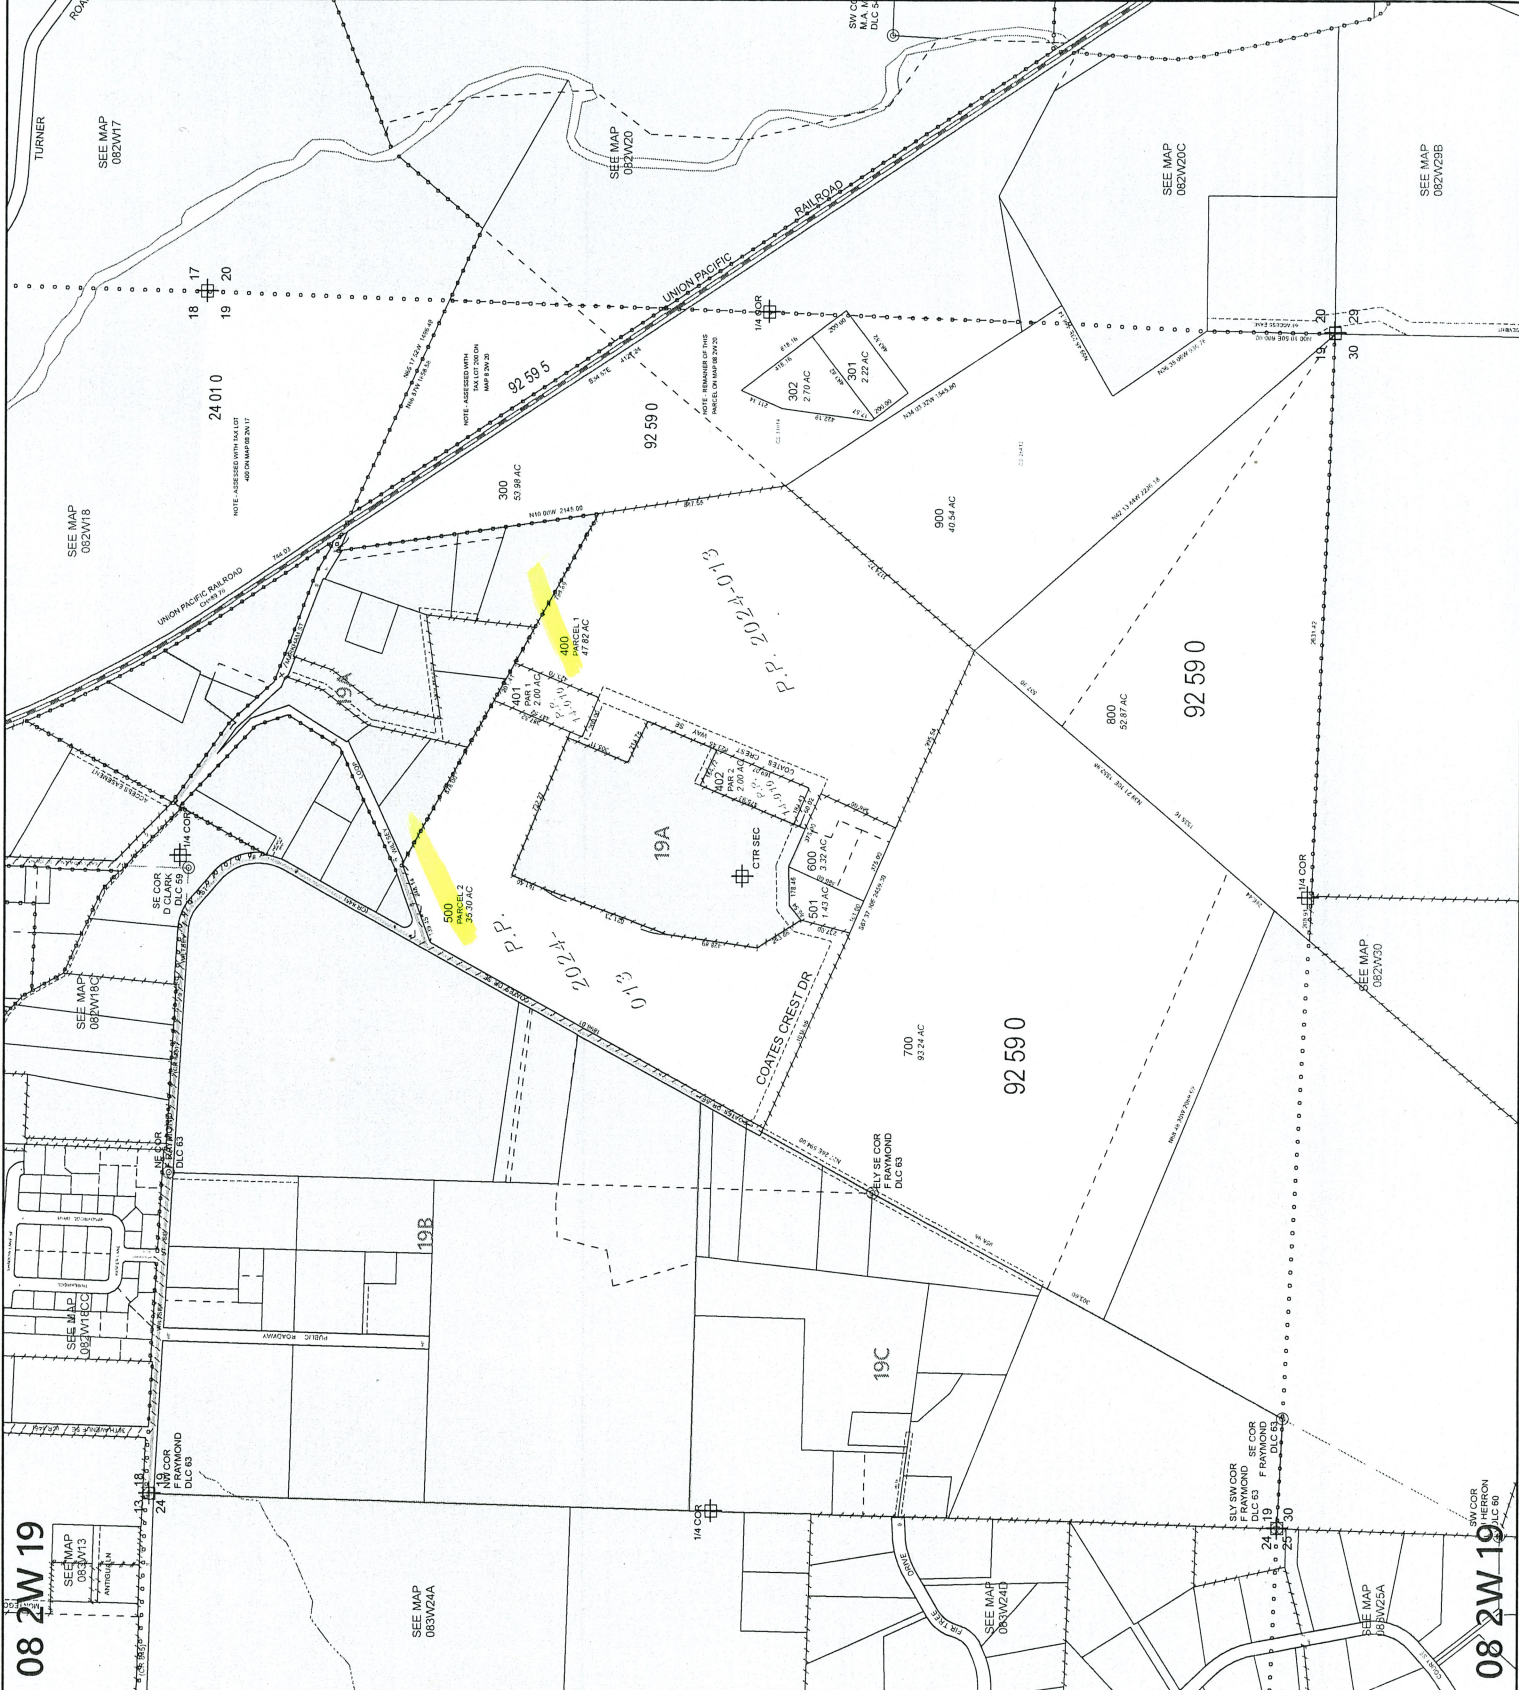

08 2W 19

08 2W 19

08 2W 19
SALEM

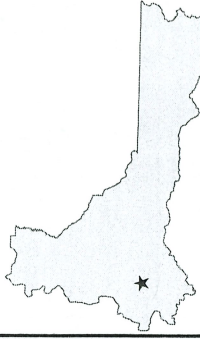

MARION COUNTY, OREGON
SEC 19 T8S R2W W.M.
SCALE 1" = 400'

LEGEND

LINE TYPES

- Taxlot Boundary
- Historical Boundary
- Road Right-of-Way
- Railroad Right-of-Way
- Private Road ROW
- Subdivision/Plat Boundary
- Waterline - Taxlot Boundary
- Waterline - Non Boundary
- Easement
- Railroad Centerline
- Taxcode Line
- Map Boundary

CORNER TYPES

- + 1/16TH Section Cor.
- ⊕ 1/4 Section Cor.
- ⊙ DLC Corner
- ⊕ 15' Section Corner
- ⊕ 21' Section Corner

NUMBERS

- ⊕ Tax Code Number
- 00000

Acresage All acres listed are Net Acres, excluding any portions of the taxlot within public ROWs

NOTES

Tick Marks - A tick mark in the road indicates that the labeled dimension extends into the public ROW




CANCELLED NUMBERS

DISCLAIMER: THIS MAP WAS PREPARED FOR ASSESSMENT PURPOSES ONLY



FOR ADDITIONAL MAPS VISIT OUR WEBSITE AT www.co.marion.or.us

PLOT DATE: 3/18/2021
SALEM
08 2W 19

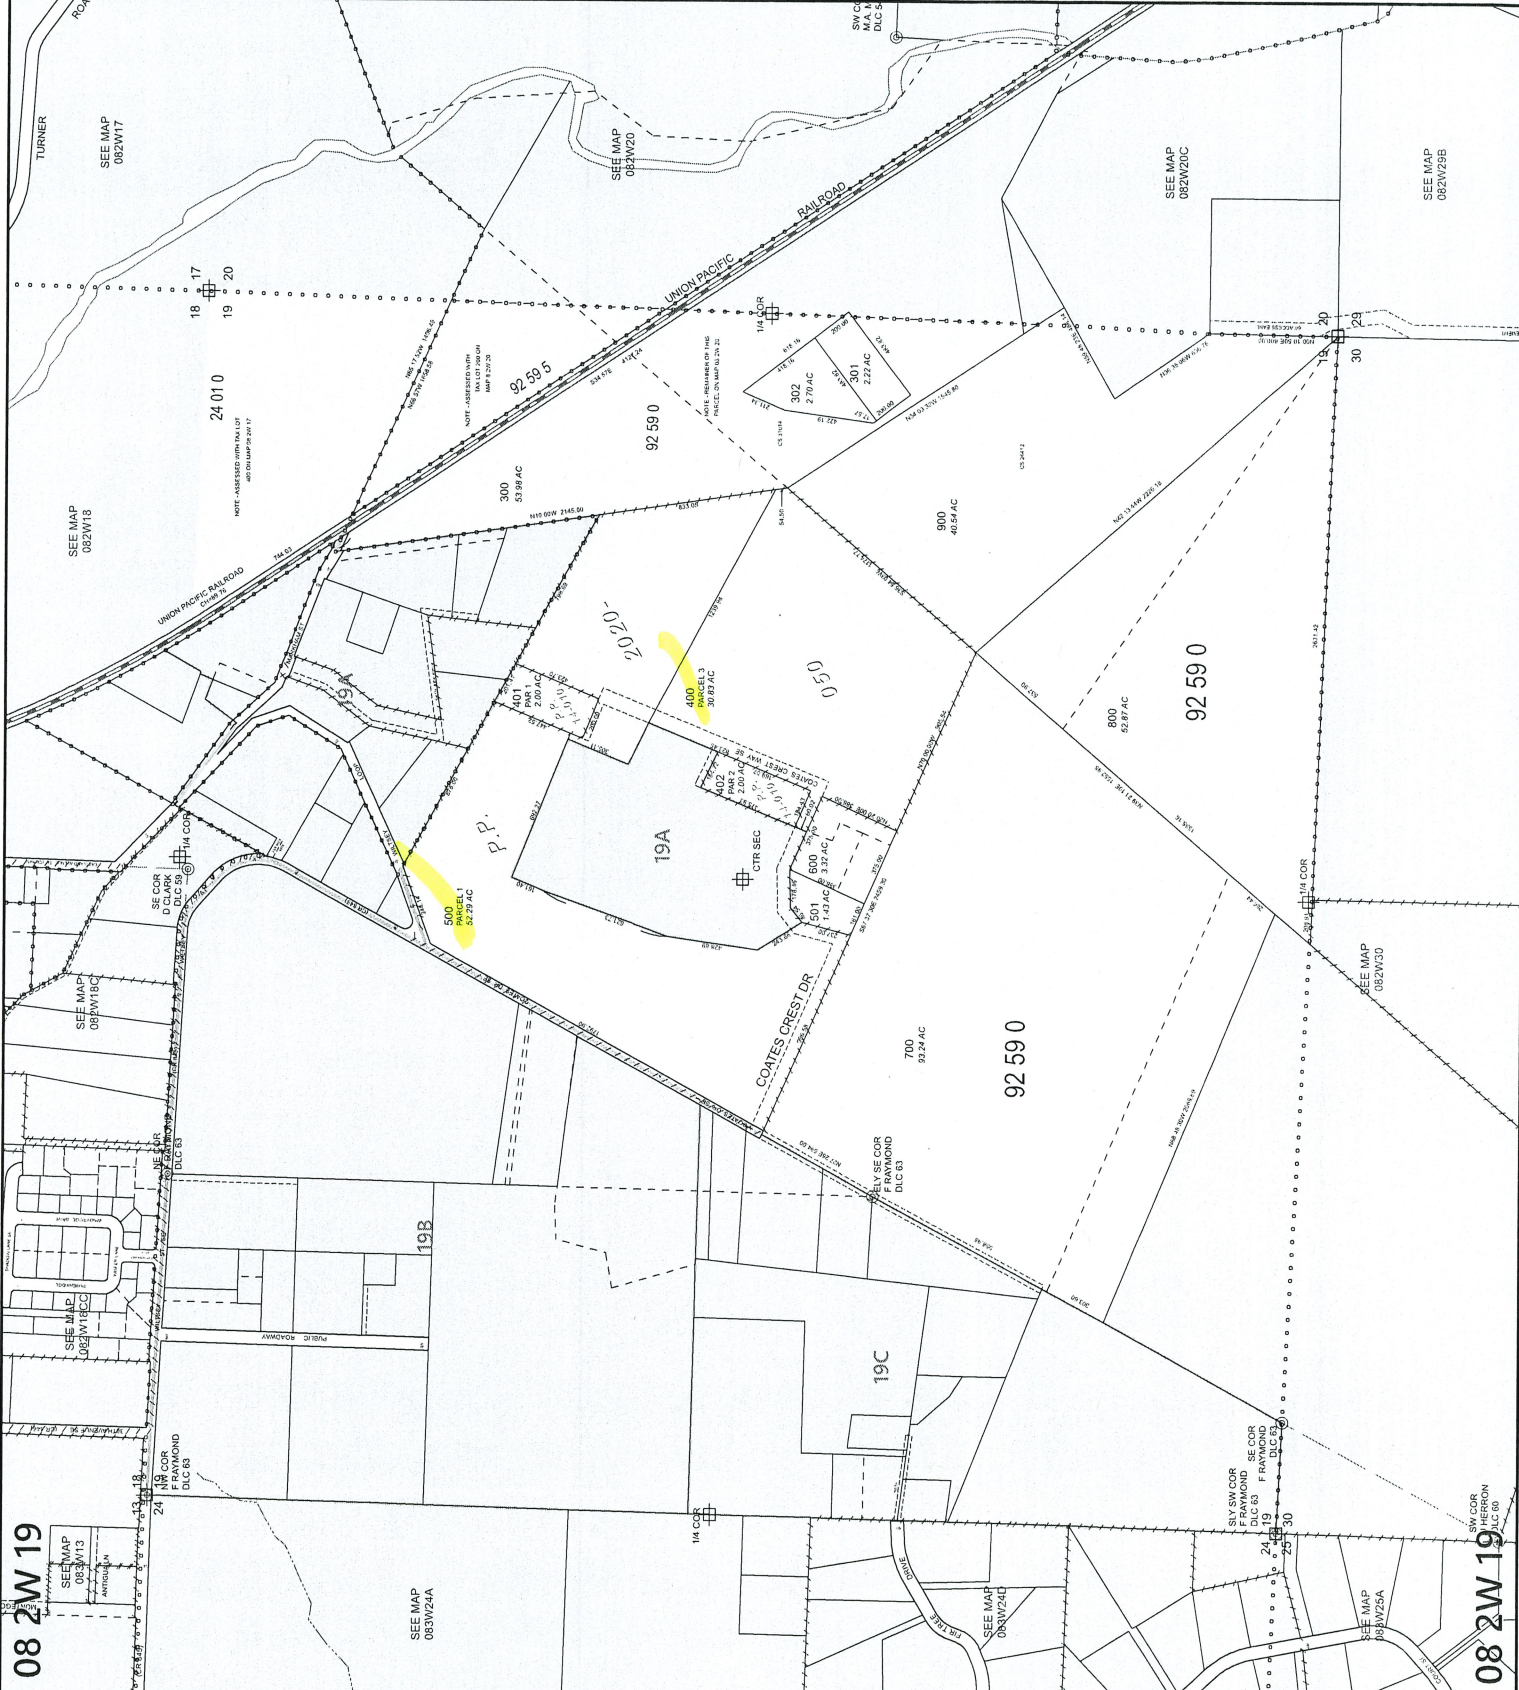

08 2W 19

08 2W 19