

Summary Lead Appr: WW Clerk: _____ Lead Clerk: _____ Appr: GRH Print Date: 4/22/2024

Acct ID: 549425 MTL: 062W14CC00300 Date: 05/10/24 Appr: GRH Prop Class: 550 RMV Prop Class: 550
Situs: _____ MaSaNh: 04 06 000 Unit: 134816 Year: 2024

Last Date Appraised: 04/15/2020 Appraiser: GERARDO RAMIREZ HERNANDEZ Retag: Y N Tag info: _____

Owner: GEORGE FARMS LLC Roll Type: R
Cycle: 1 Tag: _____ Sales Verification: _____ Other: _____ Inspection level: 1 2 3 4 LCB TTO INSP AV: 7247
RMV Land: 96880 RMV Imp: 0 RMV Total: 96880 MSAV: 7247 SAV: 33128
Comment: _____

Add UB @ 100%.

Notations

No notation data available.

Permit-23-002137

No OSD data available.

Land

Site: 1 Code Area: 92410 Size: 1.20 Acres Use Code: 005 Zone: REST SAV Use: 011 Exception: 0
Class: 2BI Value Source: Farm Use - EFU Description: TWO BENCH IRR RMV: 19340 Exception: Y N
Adjustment(s): GSOIL, IRR Fire Patrol: _____ Description: _____
Comments: Liability year - 1976 / 20-21: CYCLE WORK #94 C19 NO CHG// 2400210 06-07: RECALC SETUP, APPR NO 42, 10/10/05

Site: 2 Code Area: 92410 Size: 5.27 Acres Use Code: 005 Zone: REST SAV Use: 011 Exception: 0
Class: 3LL Value Source: Farm Use - EFU Description: THREE LAKE LABISH LAND RMV: 77540 Exception: Y N
Adjustment(s): GSOIL, IRR Fire Patrol: _____ Description: _____
Comments: Liability year - 1976 / 2400210

Improvements - Residence / Manufactured Structures

No residence or manufactured structure improvement data available.

Improvements - Accessory Buildings

No improvement data available for all other stat class types.



UB



UB

ACCOUNT # 549425 DATE: 5/10/24 RMV CLASS 551 PROP CLASS 551
 MTL 062W14CC00300 APPR GRH TAG Y N 0

RESIDENCE / MANUFACTURED STRUCTURES

ACCESSORY IMPROVEMENTS / OUTBUILDINGS

STAT _____ QLTY + - FLOOR _____
 AREA _____ EFF AREA _____ BED _____
 ROOF + HVAC +
 BATH PKG: _____ BATH _____ BATH + _____ 1/2 BTH
 FIREPLACE: _____
 KITCHEN - +
 YR BLT _____ EFF YR _____ ECON _____
 % COMP _____ % GOOD _____ FUNC _____
 EXCEPT Y N LUMP SUM: _____
 MISC: _____
 YI CLASS _____ F G A E
 SKIRT + LIN FT _____
 COMMENT: _____

TYPE UB
 STAT / CLASS S
 SIZE 72X100
 FAIR
AVERAGE
 GOOD
 EXCELLENT
 BATH _____
 YR BLT 2023
 EFF YR 2023
 % COMP 100
 EXCEPT Y N
 MISC: _____
 COMMENT: _____

TYPE _____
 STAT / CLASS _____
 SIZE _____
 FAIR
 AVERAGE
 GOOD
 EXCELLENT
 BATH _____
 YR BLT _____
 EFF YR _____
 % COMP _____
 EXCEPT Y N
 MISC: _____
 COMMENT: _____

TYPE _____
 STAT / CLASS _____
 SIZE _____
 FAIR
 AVERAGE
 GOOD
 EXCELLENT
 BATH _____
 YR BLT _____
 EFF YR _____
 % COMP _____
 EXCEPT Y N
 MISC: _____
 COMMENT: _____


TYPE _____
 STAT / CLASS _____
 SIZE _____
 FAIR
 AVERAGE
 GOOD
 EXCELLENT
 BATH _____
 YR BLT _____
 EFF YR _____
 % COMP _____
 EXCEPT Y N
 MISC: _____
 COMMENT: _____

SKETCH/AREA TABLE ADDENDUM

SUBJECT INFO

File No.: R49425 Parcel No.: 062W14CC00300
 Property Address:
 City: County: State: OR ZipCode:
 Owner:
 Client: Client Address:
 Appraiser Name: Inspection Date:

SKETCH

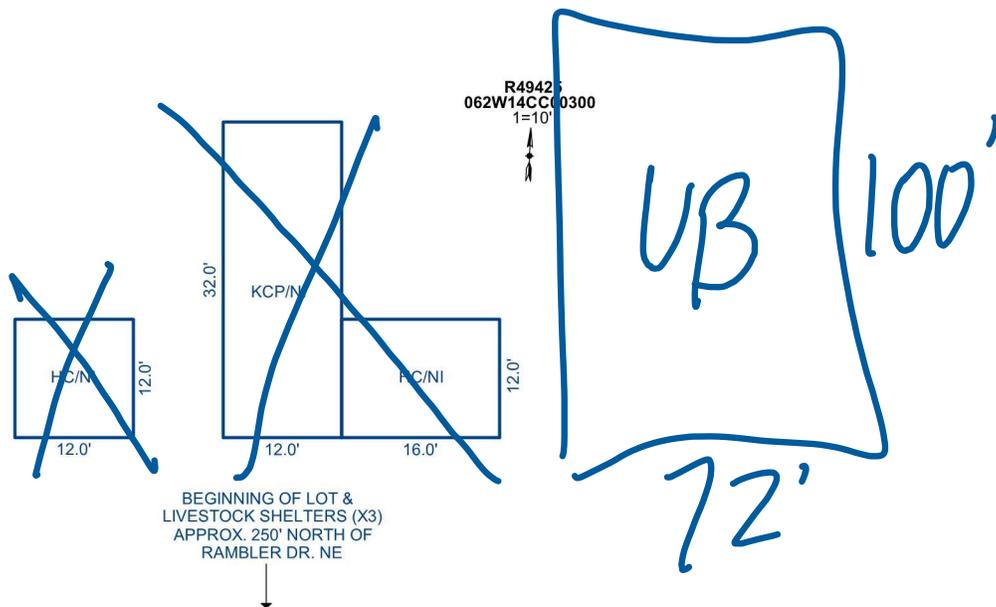

Sketch by Apex Sketch

AREA CALCULATIONS SUMMARY						COMMENT TABLE 1	
Code	Description	Factor	Net Size	Perimeter	Net Totals		
						APEX BY CJURAN 12/03/2020	
						COMMENT TABLE 2	COMMENT TABLE 3
						04/15/2020 S.R. #94	CYCLE;
						5/10/24 cycle	L3