

Acct ID: 536574 MTL: 093W30D000100 Date: 7/9/24 Appr: MDL Prop Class: 559 RMV Prop Class: 559
 Situs: 13539 MYERS LN S JEFFERSON OR 97352 MaSaNh: 07 06 000 Unit: 25164 Year: 2024

Last Date Appraised: 04/03/2009 Appraiser: MATT LORD Retag: Y N Tag info: _____
 Owner: DOUGHTON TR & Roll Type: R
 Cycle Tag Sales Verification Other: _____ Inspection level: 1 2 3 4 LCB TTO INSP AV: 43304
 RMV Land: 286600 RMV Imp: 10430 RMV Total: 297030 MAV: 5800 MSAV: 37504 SAV: 93219
 Comment: _____

Notations

24-25 cycle (NO Exception For LTH's Added)

RP/MS	Code	Description
MS	ZONED	FARM EFU ZONED

OSDs

Count	Code	Description	RMV	Code Area	Exception
1	SAA	SA OSD - AVERAGE	45000	14530	0

Land

Site: 2	Code Area: 14530	Size: 1.00 Acres	Use Code: 005	Zone: REST	SAV Use: 011	Exception: 0
Class:	Value Source: Farm Homesite	Description:			RMV: 73470	Exception: Y N
Adjustment(s):	GSOIL, IRR		Fire Patrol:	Description:		
Comments:	Liability year - 2009 / 81400130					
Site: 3	Code Area: 14530	Size: 1.99 Acres	Use Code: 005	Zone: REST	SAV Use: 011	Exception: 0
Class: 2BISS	Value Source: Farm Use - EFU	Description: TWO BENCH IRR SOUTH SPECIAL			RMV: 168130	Exception: Y N
Adjustment(s):	GSOIL, IRR		Fire Patrol:	Description:		
Comments:	Liability year - 1985 / 81400130 //04-05: CHG OF LAND SCHEDULE PER #29					

Improvements - Residence / Manufactured Structures

No residence or manufactured structure improvement data available.

Improvements - Accessory Buildings

Bldg: 1	Code Area: 14530	Stat Class: 351	Year Blt: 1970	Eff Year Blt: 1970	Sq.Ft: 864	% Complete: 100
Desc: General Purpose Building (GB)					Dimensions: 36x24	RMV: 3980
Func Obsc: 100	Econ %: 100	Other %: 100	Exception: 0	Adjust:	Adjust RMV: 0	

Floors

Type	Class	Display Group	Floor Size	Beds	Baths	Yr Blt	Eff Yr Blt	Inventory	Exception: Y N
General Purpose Bldg	5	Finished	864	0	0	1970	1970	FAIR	Exception: Y N

Accessories

Description	Class	Size SqFt	Eff Yr Blt	RMV	Quantity
No accessory data available					

Bldg: 2	Code Area: 14530	Stat Class: 351	Year Blt: 1970	Eff Year Blt: 1970	Sq.Ft: 576	% Complete: 100
Desc: General Purpose Building (GB)					Dimensions: 24x24	RMV: 2340
Func Obsc: 100	Econ %: 100	Other %: 100	Exception: 0	Adjust:	Adjust RMV: 0	

Floors

Type	Class	Display Group	Floor Size	Beds	Baths	Yr Blt	Eff Yr Blt	Inventory	Exception: Y N
General Purpose Bldg	5	Finished	576	0	0	1970	1970		Exception: Y N

Accessories

Description	Class	Size SqFt	Eff Yr Blt	RMV	Quantity
No accessory data available					

Bldg: 3	Code Area: 14530	Stat Class: 341	Year Blt: 2008	Eff Year Blt: 2008	Sq.Ft: 280	% Complete: 100
Desc: Multi Purpose Shed (MP)					Dimensions: 14x20	RMV: 4110
Func Obsc: 100	Econ %: 100	Other %: 100	Exception: 0	Adjust:	Adjust RMV: 0	

Floors

Type	Class	Display Group	Floor Size	Beds	Baths	Yr Blt	Eff Yr Blt	Inventory	Exception: Y N
Multi-Purpose Bldg	5	Finished	280	0	0	2008	2008		Exception: Y N

Accessories


Description	Class	Size SqFt	Eff Yr Blt	RMV	Quantity
No accessory data available					

36 *35*


093W30D 00100

R36574



SCALE=1:30

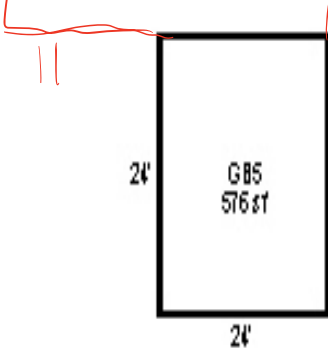

APEX UPDATED

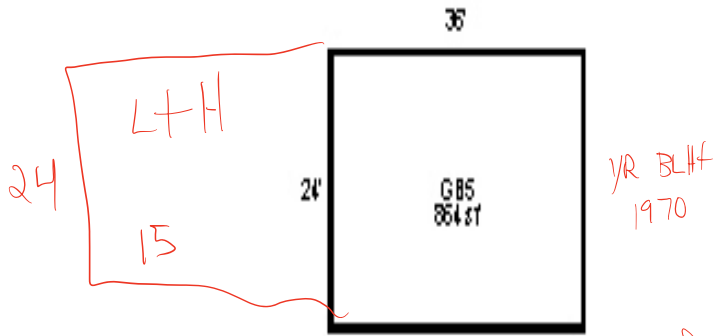

→ PART of MFH

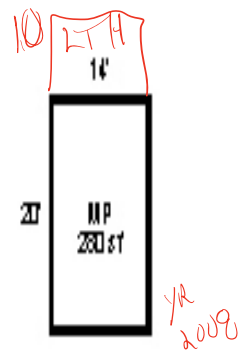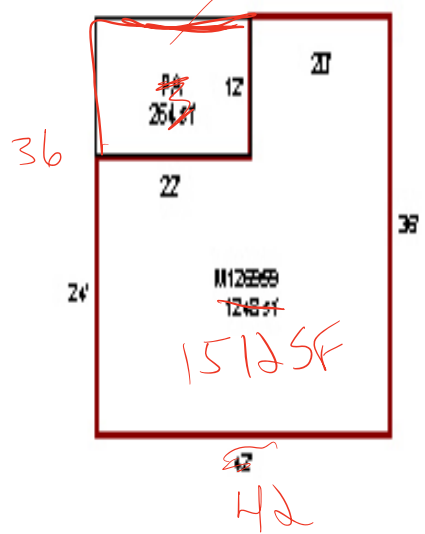

MYERS LN S

MDE 7/9/24
L3 cycle





