

Summary Lead Appr: **WW** Clerk: Lead Clerk: Appr: **GRH** Print Date:

1/25/2024

Acct ID: 519895 MTL: 063W24A000500 Date: **6/14/24** Appr: **GRH** Prop Class: **451** RMV Prop Class: 450  
Situs: 3275 QUINABY RD NE SALEM OR 97303 MaSaNh: 04 06 002 Unit: 56435 Year: 2024

Last Date Appraised: 01/23/2012 Appraiser: GERARDO RAMIREZ HERNANDEZ Retag: Y **N** Tag info:

Owner: **B**LOMGREN, JOANNE MARIE

Roll Type: R

Cycle Tag Sales Verification Other: Inspection level: 1 2 3 4 **LCB** **TTC** INSP

AV: 37230

RMV Land: 137160 RMV Imp: 0 RMV Total: 137160 MA: 37230 **MSAV**: 0

SAV: 0

Comment: **per owner no pictures**

**Notations**

No notation data available.

**Add new mp  
new mp shown in Aerial**

**OSDs**

Count	Code	Description	RMV	Code Area	Exception
1	MKTF	OSD - FAIR	35000	01410	0

**Land**

Site: 1 Code Area: 01410 Size: 19602 Sqft Use Code: 005 Zone: REST SAV Use: Exception: 0  
Class: Value Source: Rural Restrictive Description: RMV: 102160 Exception: Y N  
Adjustment(s): Fire Patrol: Description:  
Comments: 2012-13: ALL IMPS GONE//08-09:Cycle Work #19: UPDATE OF INVENTORY// BLDG SPREADING DUE TO NO FOUNDATION 06-07:  
RECALC SETUP;#10 10-19-05

**Improvements - Residence / Manufactured Structures**

No residence or manufactured structure improvement data available.

**Improvements - Accessory Buildings**

No improvement data available for all other stat class types.

ACCOUNT # 519895 DATE: 6/14/24 RMV CLASS 451 PROP CLASS 451  
 MTL \_\_\_\_\_ APPR \_\_\_\_\_ TAG Y N \_\_\_\_\_  
 COMMENTS: \_\_\_\_\_

RESIDENCE / MANUFACTURED STRUCTURES

ACCESSORY IMPROVEMENTS / OUTBUILDINGS

STAT \_\_\_\_\_ QLTY + - FLOOR \_\_\_\_\_  
 AREA \_\_\_\_\_ EFF AREA \_\_\_\_\_ BED \_\_\_\_\_  
 ROOF + HVAC +  
 BATH PKG: \_\_\_\_\_ BATH \_\_\_\_\_ BATH + \_\_\_\_\_ 1/2 BTH  
 FIREPLACE: \_\_\_\_\_  
 KITCHEN - +  
 YR BLT \_\_\_\_\_ EFF YR \_\_\_\_\_ ECON \_\_\_\_\_  
 % COMP \_\_\_\_\_ % GOOD \_\_\_\_\_ FUNC \_\_\_\_\_  
 EXCEPT Y N LUMP SUM: \_\_\_\_\_  
 MISC: \_\_\_\_\_  
 YI CLASS \_\_\_\_\_ F G A E  
 SKIRT + LIN FT \_\_\_\_\_  
 COMMENT: \_\_\_\_\_


TYPE MP  
 STAT / CLASS 5  
 SIZE 14x28  
 FAIR  
AVERAGE  
 GOOD  
 EXCELLENT  
 BATH \_\_\_\_\_  
 YR BLT 2021  
 EFF YR 2021  
 % COMP 100  
 EXCEPT Y N  
 MISC: \_\_\_\_\_  
 COMMENT: \_\_\_\_\_

TYPE \_\_\_\_\_  
 STAT / CLASS \_\_\_\_\_  
 SIZE \_\_\_\_\_  
 FAIR  
 AVERAGE  
 GOOD  
 EXCELLENT  
 BATH \_\_\_\_\_  
 YR BLT \_\_\_\_\_  
 EFF YR \_\_\_\_\_  
 % COMP \_\_\_\_\_  
 EXCEPT Y N  
 MISC: \_\_\_\_\_  
 COMMENT: \_\_\_\_\_

063W24A 00500  
R19895  
SCALE=1:25

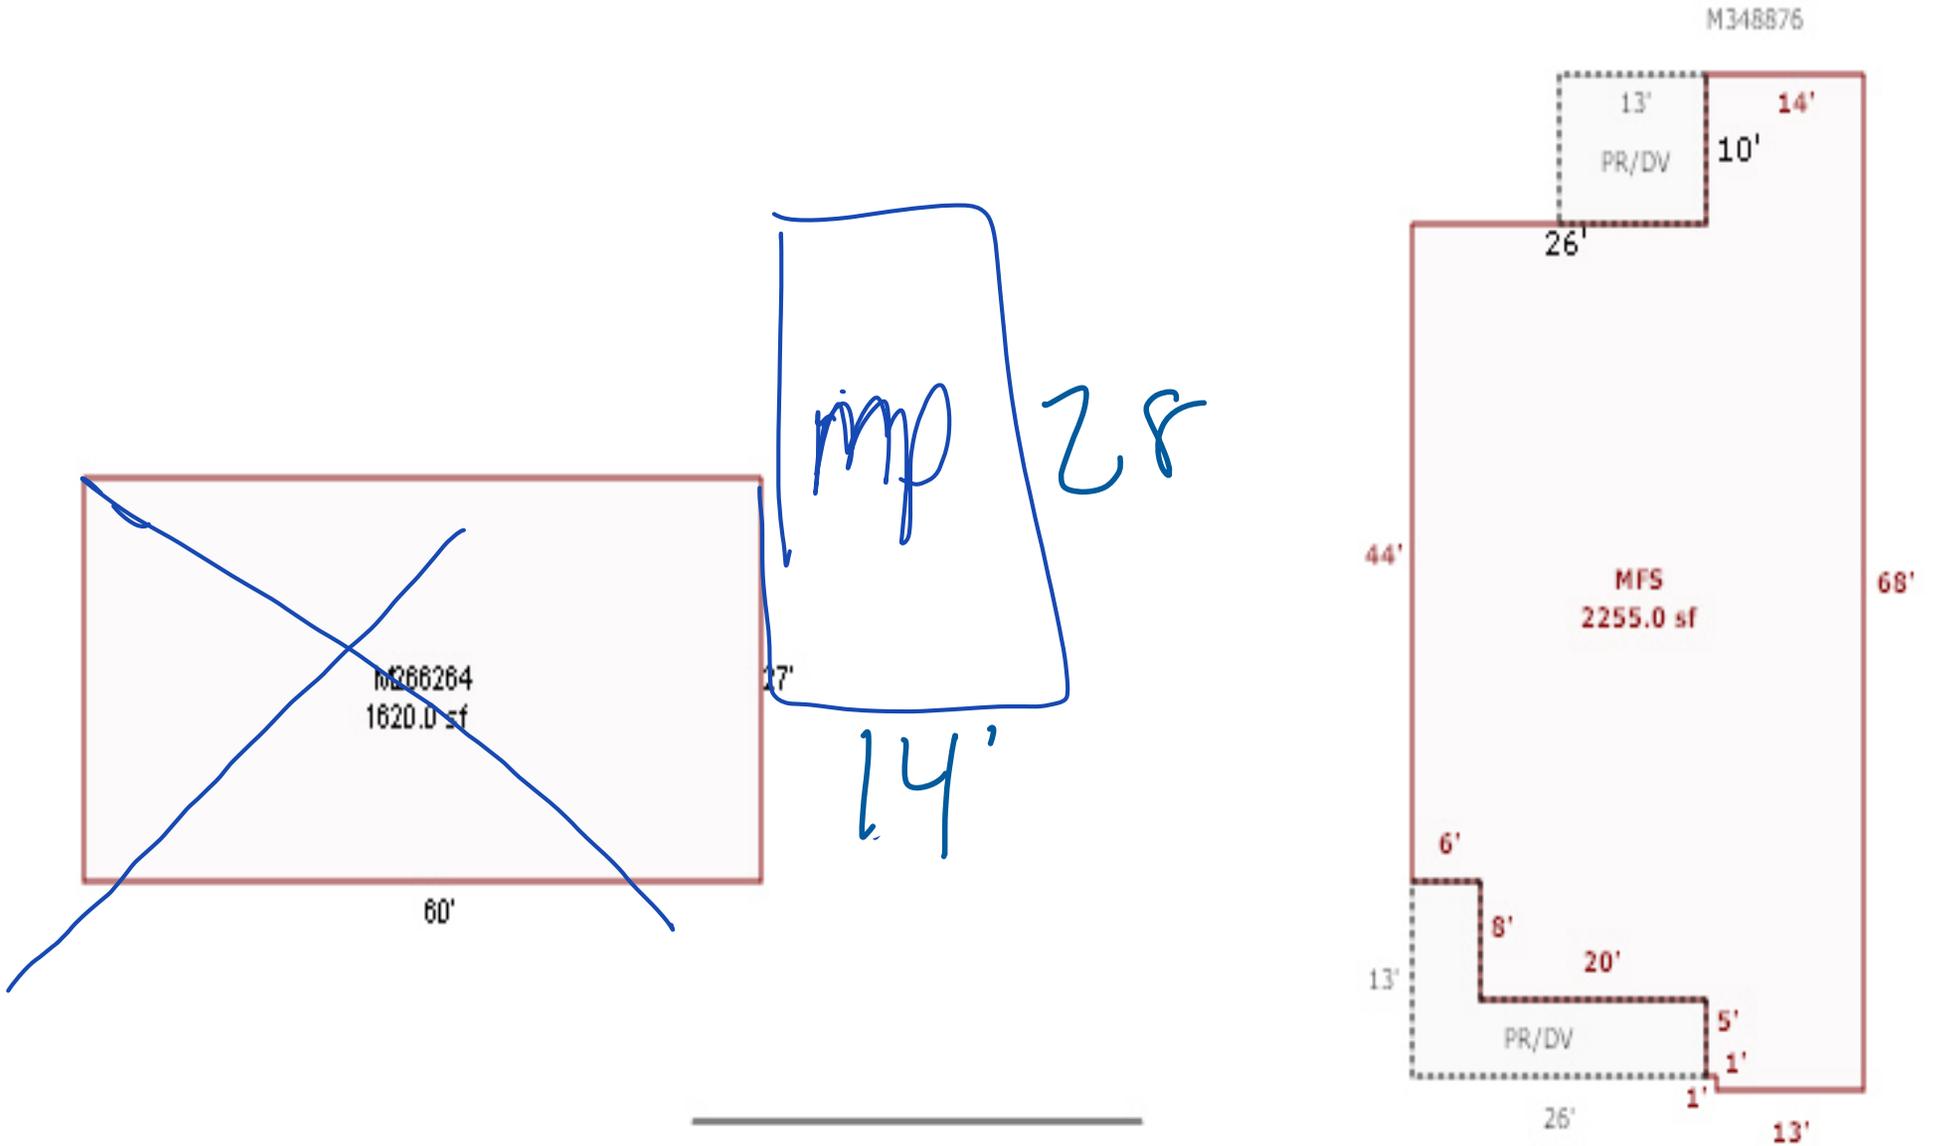

QUINABY ROAD

GRH 6/14/24  
c de L3