

**Summary**    Lead Appr: WW    Clerk: \_\_\_\_\_    Lead Clerk: \_\_\_\_\_    Appr: MLH 6/20/24    Print Date:

1/25/2024

Acct ID: 538841    MTL: 071E20000100    Date: 6/18/24    Appr: MLH    Prop Class: 661    RMV Prop Class: 501  
 Situs: \_\_\_\_\_    MaSaNh: 03 06 000    Unit: 78824    Year: 2024

Last Date Appraised: 08/31/2011    Appraiser: MATTHEW HAMILTON    Retag: Y N    Tag info:

Owner: HUPP FAMILY LLC

Roll Type: R

Cycle Tag    Sales Verification    Other: \_\_\_\_\_    Inspection level: 1 2 3 4    LCB    TTO    INSP

AV: 6368

RMV Land: 705920    RMV Imp: 6590    RMV Total: 712510    MAV: 0    MSAV: 6368    SAV: 11279

Comment:

**Notations**

[Update Inventory](#)

[Input MLH 6/18/24](#)

No notation data available.

**OSDs**

No OSD data available.

**Land**

Site: 1    Code Area: 04480    Size: 5.00 Acres    Use Code: 005    Zone: REST    SAV Use: 011    Exception: 0  
 Class: STFC    Value Source: Small Tract Forest land    Description: SMALL TRACT FORESTLAND C    RMV: 60980    Exception: Y N  
 Adjustment(s):    Fire Patrol: SA004    Description: FIRE PATROL  
 Comments: Liability year - 1976, STF - 2004 / 00400088//00-01: F99-1293 CREATION OF FP ACCT R323857 from R38841 STF APPROVED./05-06: RECALC SETUP: APPR RR 17; 05-21-04.

Site: 2    Code Area: 04480    Size: 52.88 Acres    Use Code: 005    Zone: REST    SAV Use: 011    Exception: 0  
 Class: STFC    Value Source: Small Tract Forest land    Description: SMALL TRACT FORESTLAND C    RMV: 644940    Exception: Y N  
 Adjustment(s):    Fire Patrol: SA004    Description: FIRE PATROL  
 Comments: Liability year - 1992, STF - 2004 / 16-17: COMB LIKE SEGS // 09-10: CORRECTED PART TOTALS/ 00400088//00-01: F99-1293 CREATION OF FP ACCT R323857 from R38841//04-05: STF APPROVED./05-06: RECALC SETUP: APPR RR 17; 05- 21-04. 05-06: PART TOTALS UPDATED

**Improvements - Residence / Manufactured Structures**

No residence or manufactured structure improvement data available.

**Improvements - Accessory Buildings**

Bldg: 1    Code Area: 04480    Stat Class: 353    Year Blt: 1974    Eff Year Blt: 1974    Sq.Ft: 1920    % Complete: 100  
 Desc: Machine Shed (MS)    Dimensions: 40x48    RMV: 6590  
 Func Obsc: 100    Econ %: 100    Other %: 100    Exception: 0    Adjust:    Adjust RMV: 0

[I/O](#)


**Floors**

Type	Class	Display Group	Floor Size	Beds	Baths	Yr Blt	Eff Yr Blt	Inventory		
Machine Shed	5	6	Finished	1920	0	0	1974	1974	Fair Pkg	Exception: Y N

**Accessories**

Description	Class	Size SqFt	Eff Yr Blt	RMV	Quantity
No accessory data available					

R38841  
071E 20 00100  
N

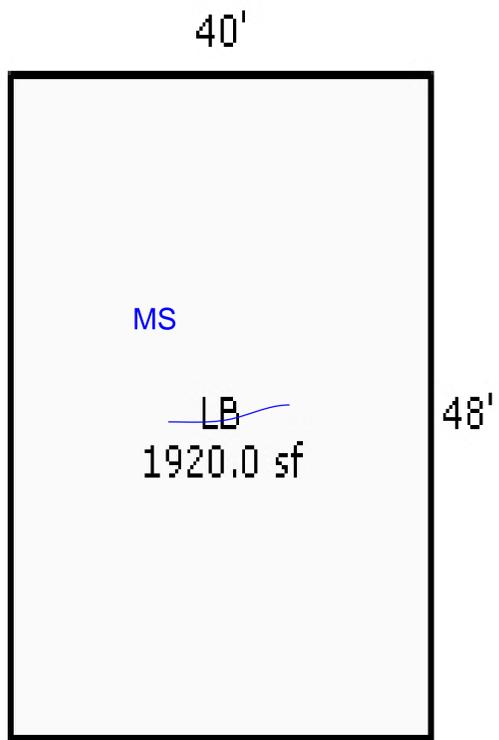

530 Yards of  
Gravel Lane

Silver Falls Dr

6/18/24 MLH CYCLE L4

MFS on Tax lot #102



