


# SKETCH/AREA TABLE ADDENDUM

## SUBJECT INFO

File No.: 108491 Parcel No.: 051W07DC08100  
 Property Address: 399 HARRISON ST  
 City: WOODBURN County: State: OR ZipCode: 97071  
 Owner:  
 Client: Client Address:  
 Appraiser Name: Inspection Date:

## SKETCH

**KNIGHTS OF COLUMBUS HALL**  
**108491**  
**051W07DC08100**

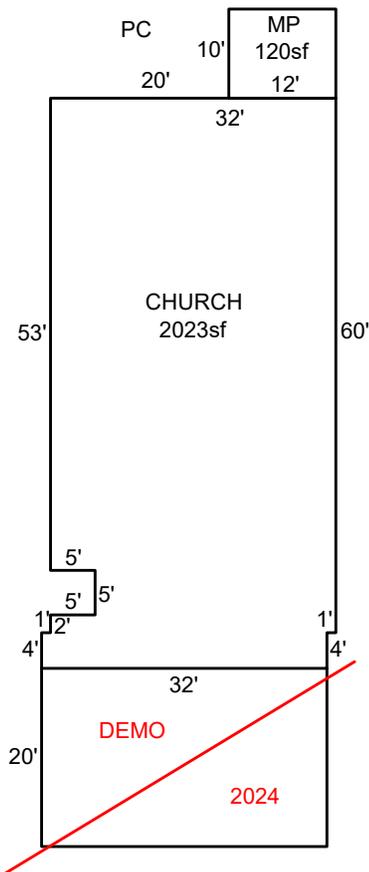

Sketch by ApexSketch

### AREA CALCULATIONS SUMMARY

Code	Description	Factor	Net Size	Perimeter	Net Totals
GBA	MP	1.0	120.0	44.0	120.0
GLA1	CHURCH	1.0	2023.0	204.0	2023.0

### COMMENT TABLE 1

DRAWN BY PST 11/23/09  
 Updated by AE 8.27.24

### COMMENT TABLE 2

### COMMENT TABLE 3

Net LIVABLE	cnt	1	(rounded)	2,023
Net BUILDING	cnt	1	(rounded)	120