

Acct ID: 533488 MTL: 083W36BC00300 Date: 7/24/24 Appr: JS/MDL Prop Class: 911 RMV Prop Class: 401
 Situs: 8360 DAVID LN SE TURNER OR 97392 MaSaNh: 07 06 000 Unit: 43300 Year: 2024

Last Date Appraised: 03/01/2011 Appraiser: MATT LORD Retag: Y (N) Tag info: _____
 Owner: WAT BUDDHA OREGON Roll Type: R
 Cycle Tag Sales Verification Other: _____ Inspection level: 1 2 3 4 LCB TTO INSP AV: 0
 RMV Land: 237330 RMV Imp: 1408710 RMV Total: 1646040 MAV: 0 MSAV: 0 SAV: 0
 Comment: _____

EMAIL BRADLI

Notations 24-25 M/s Church Property
 No notation data available.

OSDs

Count	Code	Description	RMV	Code Area	Exception
1	MKTA	OSD - AVERAGE	40000	92590	0

2 OSDA

Land

Site: 1 Code Area: 92590 Size: 2.45 Acres Use Code: 004 Zone: NREST SAV Use: _____ Exception: 0
 Class: Value Source: Rural at MKT Description: _____ RMV: 197330 Exception: Y N
 Adjustment(s): _____ Fire Patrol: _____ Description: _____
 Comments: 2010-11: #42- REMOVE TRAFFIC ADJUSTMENT// 00-01; REAPPRAISAL

Improvements - Residence / Manufactured Structures

Bldg: 1 Code Area: 92590 Stat Class: 108 Year Blt: 1999 Eff Year Blt: 1999 Sq.Ft: 0 % Complete: 100
 Desc: Residential Other Improvements Dimensions: _____ RMV: 12880
 Func Obsc: 100 Econ %: 100 Other %: 100 Exception: 0 Adjust: _____ Adjust RMV: 0

Floors

Type	Class	Display Group	Floor Size	Beds	Baths	Yr Blt	Eff Yr Blt	Inventory
No floor data available								

ADD to Church

Accessories

Description	Class	Size SqFt	Eff Yr Blt	RMV	Quantity
ASPHALT DRIVEWAY	1	4000	1999	10560	1

Exception: Y N

Bldg: 2 Code Area: 92590 Stat Class: 148 Year Blt: 2000 Eff Year Blt: 2000 Sq.Ft: 0 % Complete: 100
 Desc: Res other improvements Dimensions: _____ RMV: 169700
 Func Obsc: 100 Econ %: 100 Other %: 100 Exception: 0 Adjust: _____ Adjust RMV: 0

Floors

Type	Class	Display Group	Floor Size	Beds	Baths	Yr Blt	Eff Yr Blt	Inventory
Garage Oversized Detached	4	Finished	2400	0	0	2000	2000	ROOF

Exception: Y N

Accessories

Description	Class	Size SqFt	Eff Yr Blt	RMV	Quantity
No accessory data available					

Bldg: 3 Code Area: 92590 Stat Class: 468 Year Blt: 1998 Eff Year Blt: 1999 Sq.Ft: 1946 % Complete: 100
 Desc: MANUF STRUCT, CLASS 6, 36' WIDE TRIPLE/QUAD Dimensions: _____ RMV: 123770
 Func Obsc: 100 Econ %: 100 Other %: 100 Exception: 0 Adjust: _____ Adjust RMV: 0

Floors

Type	Class	Display Group	Floor Size	Beds	Baths	Yr Blt	Eff Yr Blt	Inventory
First Floor	6	Finished	1946	3	FB-2	1998	1999	BATH - 2, KIT, HVAC+, ROOF, SKRT+

Exception: Y N

Accessories

Description	Class	Size SqFt	Eff Yr Blt	RMV	Quantity
DECK	6	70	1998	662	1
PATIO	6	975	1998	2306	0
PATIO	6	2520	1998	5960	1
ROOF EXTENSION OR PATIO COVER	6	70	1998	873	0
ROOF EXTENSION OR PATIO COVER	6	70	1998	873	1

Exception: Y N

Exception: Y N

Bldg: 5 Code Area: 92590 Stat Class: 108 Year Blt: 2001 Eff Year Blt: 2001 Sq.Ft: 0 % Complete: 100
 Desc: Residential Other Improvements Dimensions: _____ RMV: 98080
 Func Obsc: 100 Econ %: 100 Other %: 100 Exception: 0 Adjust: _____ Adjust RMV: 0

Floors

YI

YI

Type	Class	Display Group	Floor Size	Beds	Baths	Yr Blt	Eff Yr Blt	Inventory
No floor data available								
Accessories								
Description	Class	Display Group	Floor Size	Beds	Baths	Yr Blt	Eff Yr Blt	Inventory
DECK	1		384			2001	2001	7519
DECK	1		400			2001	2001	7832
ROOF EXTENSION OR PATIO COVER	1		2520			2001	2001	65041

Improvements - Accessory Buildings

Bldg: 4	Code Area: 92590	Stat Class: 901	Year Blt: 2009	Eff Year Blt: 2009	Sq.Ft: 4057 3856	% Complete: 100
Desc: PARSONAGE			Dimensions:		RMV: 968150	
Func Obsc: 100	Econ %: 100	Other %: 100	Exception: 0	Adjust:	Adjust RMV: 0	

Floors

Type	Class	Display Group	Floor Size	Beds	Baths	Yr Blt	Eff Yr Blt	Inventory
First Floor	2	Finished	4057	0	0	0	0	Exception: Y N

Accessories

Description	Class	Size SqFt	Eff Yr Blt	RMV	Quantity
No accessory data available					

Bldg: 6	Code Area: 92590	Stat Class: 321	Year Blt: 2009	Eff Year Blt: 2009	Sq.Ft: 240	% Complete: 100
Desc: Hay Cover (HC)			Dimensions: 10x24		RMV: 1130	
Func Obsc: 100	Econ %: 100	Other %: 100	Exception: 0	Adjust:	Adjust RMV: 0	

Floors

Type	Class	Display Group	Floor Size	Beds	Baths	Yr Blt	Eff Yr Blt	Inventory
Hay Cover	4	Finished	240	0	0	2009	2009	Exception: Y N

Accessories

Description	Class	Size SqFt	Eff Yr Blt	RMV	Quantity
No accessory data available					

Bldg: 7	Code Area: 92590	Stat Class: 301	Year Blt: 2010	Eff Year Blt: 2010	Sq.Ft: 0	% Complete: 100
Desc: Accessory Improvements & Misc.			Dimensions:		RMV: 35000	
Func Obsc: 100	Econ %: 100	Other %: 100	Exception: 0	Adjust:	Adjust RMV: 0	

Floors



Type	Class	Display Group	Floor Size	Beds	Baths	Yr Blt	Eff Yr Blt	Inventory
Building Structure	0	Finished	0	0	0	2010	2010	Exception: Y N

WELDED steel & FIRE SUPPRESSION SYSTEM
?





WATER STORAGE TANK FLAT 35000

Accessories

Description	Class	Size SqFt	Eff Yr Blt	RMV	Quantity
No accessory data available					

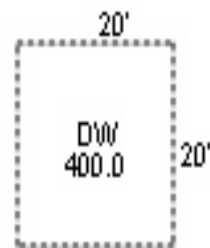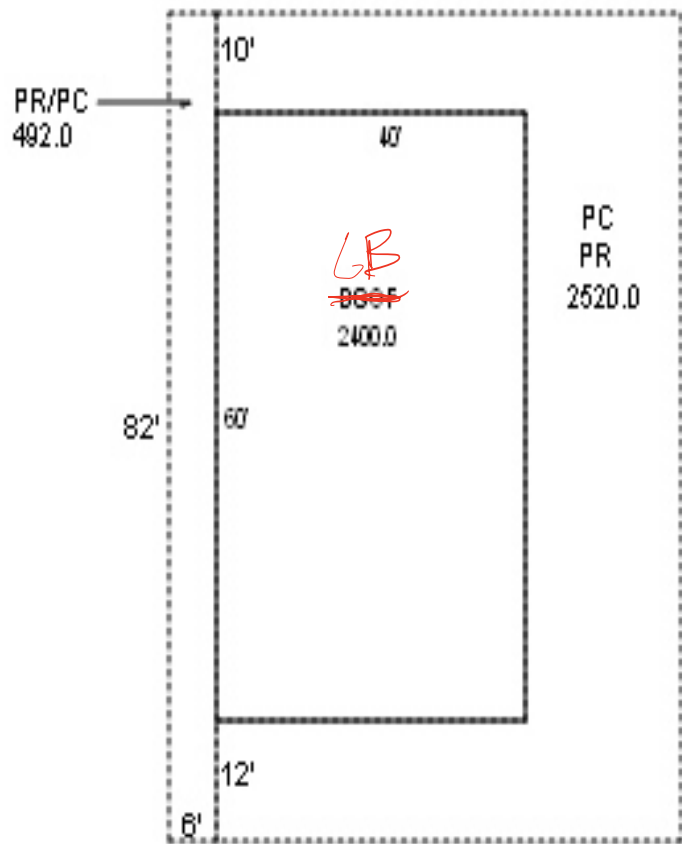



R33488
 083W/36B 00403
 Page 1 of 2
 Scale: 1-35'

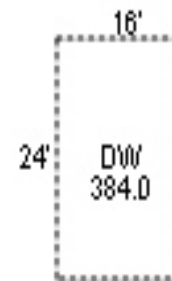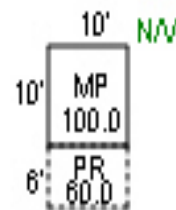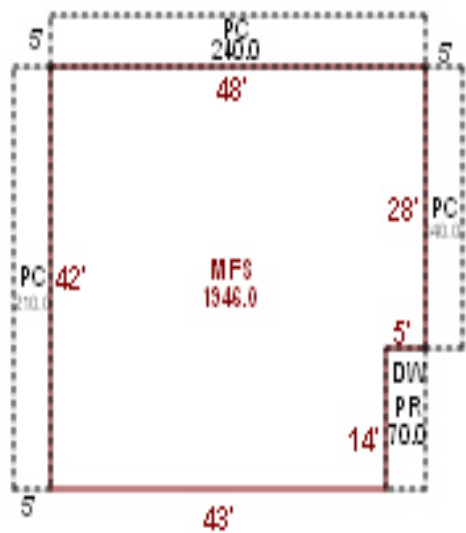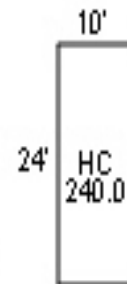

See Page 2 for Temple



R33488
083W36B 00403
Page 2 of 2
See Page 1 for balance
of Structures

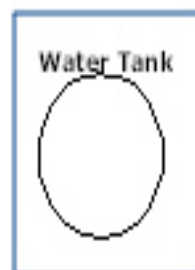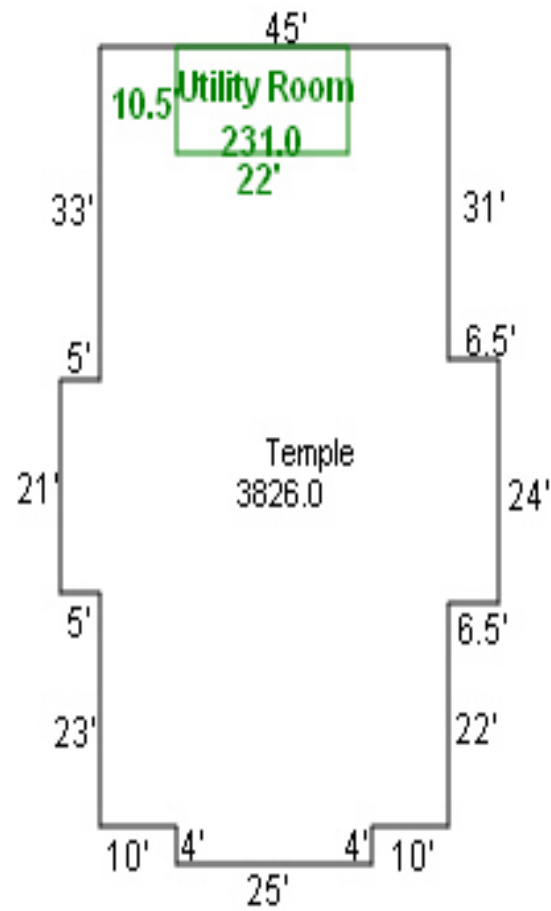



NO SMOKING

HOUSE





BUKTI BANGSA
KEMERDEKAAN





7/24/24