

Type	Class	Display Group	Floor Size	Beds	Baths	Yr Blt	Eff Yr Blt	Inventory	
Machine Shed	4	Finished	1620	0	0	1973	1990	Fair	Exception: Y N

Accessories

Description	Class	Size SqFt	Eff Yr Blt	RMV	Quantity
No accessory data available					

Bldg: 4 Code Area: 92410 Stat Class: 321 Year Blt: 2010 Eff Year Blt: 2010 Sq.Ft: 504 % Complete: 100
 Desc: Hay Cover (HC) Dimensions: 36x14 RMV: 2820
 Func Obsc: 100 Econ %: 100 Other %: 100 Exception: 0 Adjust: Adjust RMV: 0

I/O

Floors

Type	Class	Display Group	Floor Size	Beds	Baths	Yr Blt	Eff Yr Blt	Inventory	
Hay Cover	5	Finished	504	0	0	2010	2010	Fair	Exception: Y N

Accessories

Description	Class	Size SqFt	Eff Yr Blt	RMV	Quantity
No accessory data available					

Bldg: 5 Code Area: 92410 Stat Class: 357 Year Blt: 2010 Eff Year Blt: 2010 Sq.Ft: 960 % Complete: 100
 Desc: Frost Control Dimensions: 48x20 RMV: 2282
 Func Obsc: 100 Econ %: 100 Other %: 100 Exception: 0 Adjust: Adjust RMV: 0

N/C

Floors

Type	Class	Display Group	Floor Size	Beds	Baths	Yr Blt	Eff Yr Blt	Inventory	
Frost Control	4	Finished	960	0	0	2010	2010		Exception: Y N

Accessories

Description	Class	Size SqFt	Eff Yr Blt	RMV	Quantity
No accessory data available					

Bldg: 6 Code Area: 92410 Stat Class: 357 Year Blt: Eff Year Blt: 2010 Sq.Ft: 1920 % Complete: 100
 Desc: Frost Control Dimensions: RMV: 4565
 Func Obsc: 100 Econ %: 100 Other %: 100 Exception: 0 Adjust: Adjust RMV: 0

N/C

Floors

Type	Class	Display Group	Floor Size	Beds	Baths	Yr Blt	Eff Yr Blt	Inventory	
Frost Control	4	Finished	1920	0	0	2010	2010		Exception: Y N

Accessories

Description	Class	Size SqFt	Eff Yr Blt	RMV	Quantity
No accessory data available					

Bldg: 7 Code Area: 92410 Stat Class: 357 Year Blt: Eff Year Blt: 2010 Sq.Ft: 1360 % Complete: 100
 Desc: Frost Control Dimensions: RMV: 3233
 Func Obsc: 100 Econ %: 100 Other %: 100 Exception: 0 Adjust: Adjust RMV: 0

N/C

Floors

Type	Class	Display Group	Floor Size	Beds	Baths	Yr Blt	Eff Yr Blt	Inventory	
Frost Control	4	Finished	1360	0	0	2010	2010		Exception: Y N

Accessories

Description	Class	Size SqFt	Eff Yr Blt	RMV	Quantity
No accessory data available					

Bldg: 8 Code Area: 92410 Stat Class: 357 Year Blt: Eff Year Blt: 2010 Sq.Ft: 720 % Complete: 100
 Desc: Frost Control Dimensions: RMV: 1712
 Func Obsc: 100 Econ %: 100 Other %: 100 Exception: 0 Adjust: Adjust RMV: 0

N/C

Floors

Type	Class	Display Group	Floor Size	Beds	Baths	Yr Blt	Eff Yr Blt	Inventory	
Frost Control	4	Finished	720	0	0	2010	2010		Exception: Y N

Accessories

Description	Class	Size SqFt	Eff Yr Blt	RMV	Quantity
No accessory data available					

SKETCH/AREA TABLE ADDENDUM

SUBJECT INFO

File No.: R19549 Parcel No.: 063W15 01900
 Property Address: 8723 RAVENA DR N
 City: SALEM County: State: OR ZipCode: 97303
 Owner:
 Client: Client Address:
 Appraiser Name: Inspection Date:

SKETCH


R19549

063W15 01900

SCALE=1:20



See Page 1 for All Bldgs

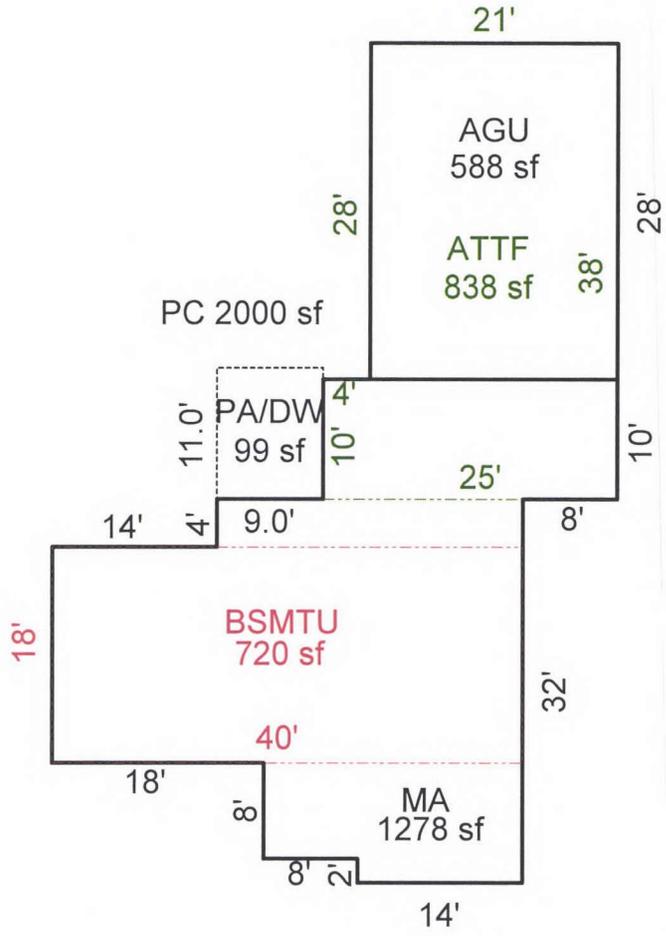

Sketch by Apex Sketch

AREA CALCULATIONS SUMMARY

COMMENT TABLE 1

Code	Description	Factor	Net Size	Perimeter	Net Totals
GLA1	MA	1	1278	180	1278
GLA2	ATTF	1	838	126	838
AGF	AGU	1	588	98	588
BSMT	BSMTU	1	720	116	720
P/P	PA/DW	1	99	40	99

APEX BY CE 9/27/10
 UPD BY PHU 07.21.20

COMMENT TABLE 2

COMMENT TABLE 3

04.23.20 JS #29: CYCLE;

GPH 6/6/24

Cycle L3


Net LIVABLE cnt 2 (rounded) 2,116

SKETCH/AREA TABLE ADDENDUM

SUBJECT INFO

File No.: R19549 Parcel No.: 063W15 01900
 Property Address: 8723 RAVENA DR N
 City: SALEM County: State: OR ZipCode: 97303
 Owner:
 Client: Client Address:
 Appraiser Name: Inspection Date:

SKETCH

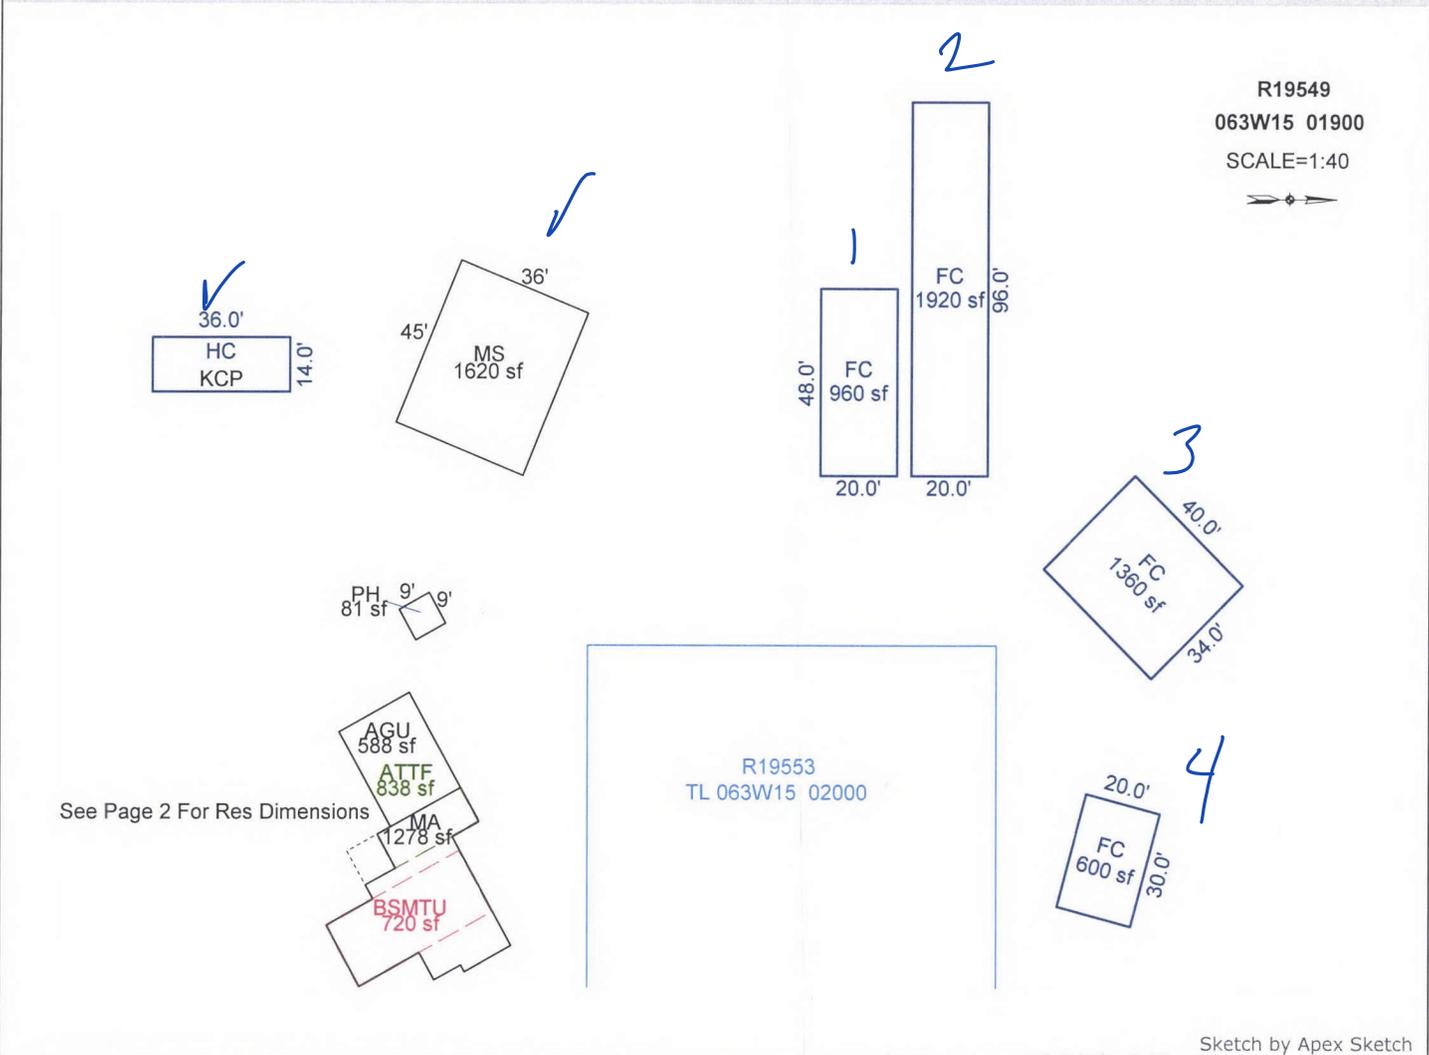

Sketch by Apex Sketch

AREA CALCULATIONS SUMMARY

COMMENT TABLE 1

Code	Description	Factor	Net Size	Perimeter	Net Totals
GBA1	PH	1	81	36	
	MS	1	1620	162	
	HC	1	504	100	
	FC	1	960	136	
	FC	1	1920	232	
	FC	1	1360	148	
	FC	1	600	100	7045
GLA1	MA	1	1278	180	1278
GLA2	ATTF	1	838	126	838
AGF	AGU	1	588	98	588
BSMT	BSMTU	1	720	116	720
P/P	DF	1	90	38	90
	Net LIVABLE	cnt	2 (rounded)		2,116
	Net BUILDING	cnt	7 (rounded)		7,045

APEX BY CE 9/27/10
 UPD BY PHU 07.21.20

COMMENT TABLE 2

COMMENT TABLE 3

04.23.20 JS #29; CYCLE;

GRH 6/6/24

Cycle L3