

Acct ID: 128913 MTL: 091W04C001500P1 Date: *1/27/25* Appr: *SH* Prop Class: 019 RMV Prop Class: 019

Situs: 9874 GOLF CLUB RD SE # 57 STAYTON, OR 97383 MaSaNh: 17 05 000 Unit: 141637 Year: 2025

Last Date Appraised: 07/23/2015 Appraiser: THERESA SWEARINGEN Retag: Y N Tag info:

Owner: DAVIDSON, JAMES RICHARD & Roll Type: MS

Cycle Tag Sales Verification Other: _____ Inspection level: 1 2 3 4 LCB TTO INSP AV: 11850

RMV Land: 0 RMV Imp: 34220 RMV Total: 34220 MAV: 11850 MSAV: 0 SAV: 0

Comment: OAK ESTATES M.H.P., SPACE #57, MS SERIAL # 9930, X # X00161246, PERSONAL MS

update inventory

Notations

No notation data available.

OSDs

No OSD data available.

Land

No land data available.

Improvements - Residence / Manufactured Structures

Bldg: 1 Code Area: 29040 Stat Class: 454 Year Blt: 1981 Eff Year Blt: 1983 Sq.Ft: 910 % Complete: 100
 Desc: MANUF STRUCT, CLASS 5, 14' WIDE SINGLE Dimensions: 65x14 RMV: 34220
 Func Obsc: 100 Econ %: 100 Other %: 100 Exception: 0 Adjust: Adjust RMV: 0

Floors

Type	Class	Display Group	Floor Size	Beds	Baths	Yr Blt	Eff Yr Blt	Inventory	Exception: Y N
First Floor	5	Finished	910	3	FB-1/ HB-1	1981	1983	BATH - 1, BTH - 1, KIT-, HVAC+, ROOF+, SKIRT	Y <u>N</u>


917 - Apex

Accessories

Description	Class	Size SqFt	Eff Yr Blt	RMV	Quantity	Exception: Y N
DECK	5	36	1983	269	0	Exception: Y N
ROOF EXTENSION OR PATIO COVER	5	36	1983	355	0	Exception: Y N

Improvements - Accessory Buildings

No improvement data available for all other stat class types.

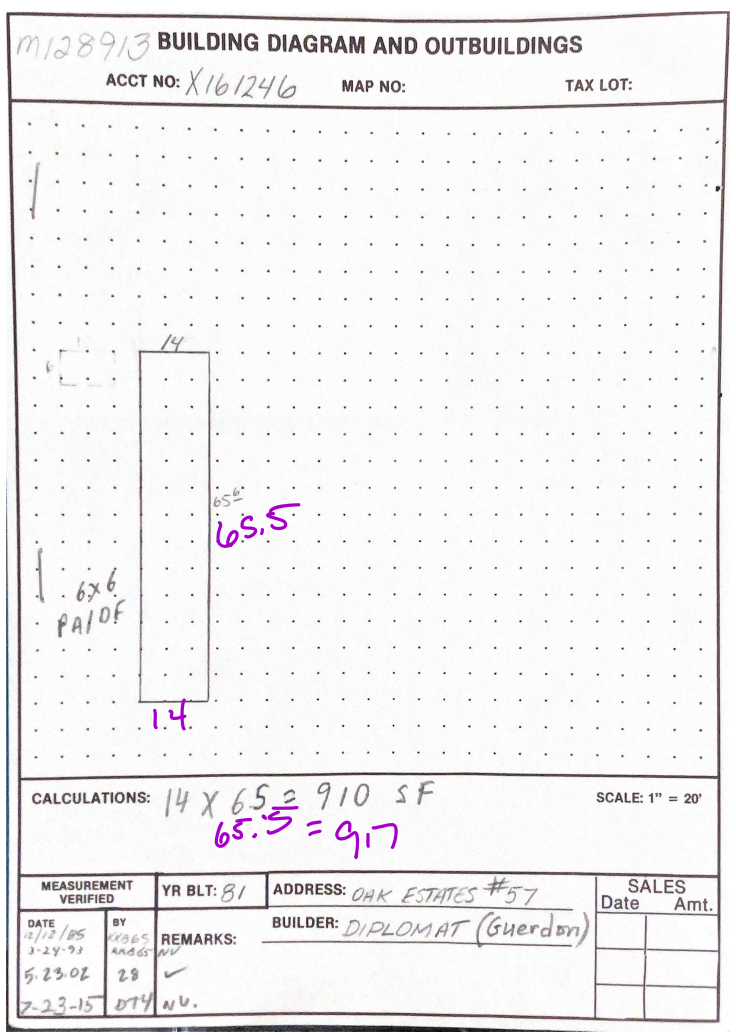

DW rotten was HP