

Apey

lak 1.31.25

Lead Appr: _____ Clerk: _____ Lead Clerk: _____ Appr: *SA 2/10/25*

Print Date: 1/17/2025

Acct ID: 128977 MTL: 091W04C001500P1 Date: *1/27/25* Appr: *SA* Prop Class: 019 RMV Prop Class: 019

Situs: 9874 GOLF CLUB RD SE # 31 STAYTON, OR 97383 MaSaNh: 17 05 000 Unit: 128977 Year: 2025

Last Date Appraised: 10/30/2018 Appraiser: THERESA SWEARINGEN Retag: Y N Tag info:

Owner: CURREY, KAY L & CURREY, RONALD R

Roll Type: MS

Cycle Tag Sales Verification Other: _____ Inspection level: 1 2 3 4 LCB TTO INSP

AV: 28440

RMV Land: 0 RMV Imp: 44380 RMV Total: 44380 MAV: 28440 MSAV: 0

SAV: 0

Comment: OAK ESTATES M.H.P., SPACE #31, MS SERIAL # 5774UX, X # X00162769, PERSONAL MS

update inventory.

Notations

No notation data available.

OSDs

No OSD data available.

Land

No land data available.

Improvements - Residence / Manufactured Structures

Bldg: 1 Code Area: 29040 Stat Class: 456 Year Blt: 1979 Eff Year Blt: 1985 Sq.Ft: 1104 % Complete: 100

Desc: MANUF STRUCT, CLASS 5, 24' WIDE DOUBLE

Dimensions: 48x23 RMV: 44380

Func Obsc: 100 Econ %: 100 Other %: 100

Exception: 0

Adjust: Adjust RMV: 0

Floors

Type Class Display Group Floor Size Beds Baths Yr Blt Eff Yr Blt Inventory


First Floor 5 Finished 1104 2 FB-2 1979 1985 BATH - 2, KIT-, HVAC+, ROOF+, SKIRT Exception: Y N

Accessories

Description	Class	Size SqFt	Eff Yr Blt	RMV	Quantity	Exception: Y N
DECK	5	280	1985	2156	0	Exception: Y N
ROOF EXTENSION OR PATIO COVER	5	24	1985	244	0	Exception: Y N
ROOF EXTENSION OR PATIO COVER	5	330	1985	3350	0	Exception: Y N

Improvements - Accessory Buildings

No improvement data available for all other stat class types.

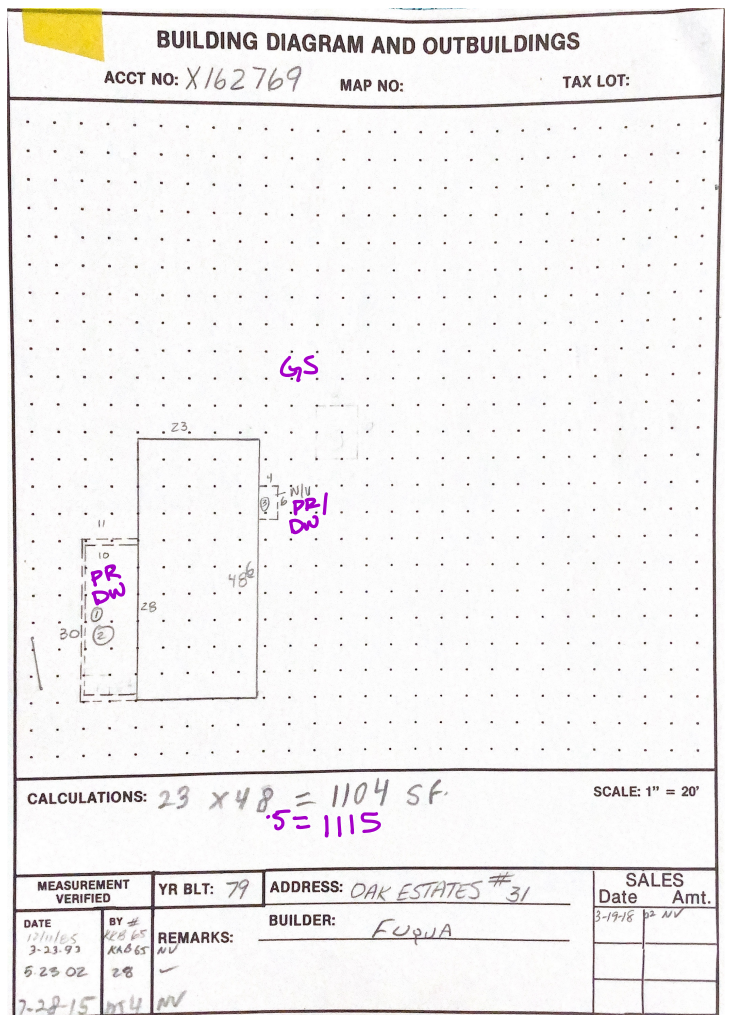

mossy roof