

Acct ID: 521343 MTL: 071W11A000800 Date: 12/4/24 Appr: MLH Prop Class: 509 RMV Prop Class: 509
 Situs: 3871 VICTOR POINT RD NE SILVERTON OR 97381 MaSaNh: 03 06 000 Unit: 28920 Year: 2024
 Last Date Appraised: 01/29/2024 Appraiser: MATTHEW HAMILTON Retag: Y N Tag info: 2025 - Tags/Permit (MS PLACEMENT)
 Owner: COOKE, MARLENE T & COOKE, MICHAEL B Roll Type: R
 Cycle Tag Sales Verification Other: _____ Inspection level: 1 2 3 4 LCB TTO INSP AV: 292810
 RMV Land: 525970 RMV Imp: 20620 RMV Total: 546590 MAV: 292810 MSAV: 0 SAV: 0
 Comment: 24-25: L4 1.29.24 MLH

*NEW M 608507 on site but not set up 80%
 Retag for '26*

Notations No notation data available. Input MLH 2/4/25

OSDs

Count	Code	Description	RMV	Code Area	Exception
2	MKTA	OSD - AVERAGE	45000	04500	0

Land

Site: 2	Code Area: 04500	Size: 19.32 Acres	Use Code: 005	Zone: REST	SAV Use:	Exception: 0
Class: 6B	Value Source: Rural Restrictive	Description: SIX BENCH	RMV: 438230	Exception: Y	N	
Adjustment(s): FSOIL	Fire Patrol: SA004	Description: FIRE PATROL				
Comments: 00400028						
Site: 3	Code Area: 04500	Size: 1.79 Acres	Use Code: 005	Zone: REST	SAV Use:	Exception: 0
Class: 4BD	Value Source: Rural Restrictive	Description: FOUR BENCH DRY	RMV: 42740	Exception: Y	N	
Adjustment(s): FSOIL	Fire Patrol: SA004	Description: FIRE PATROL				
Comments: 400008 // 06-07: RECALC SETUP;#36 08-10-05//06-22-06 (GW39): switching from woodlot to woodlot-m to properly reflect market value.						
//06-07: DISQ FARMUSE						

Improvements - Residence / Manufactured Structures

Bldg: 5	Code Area: 04500	Stat Class: 107	Year Blt: 1970	Eff Year Blt: 1970	Sq.Ft: 0	% Complete: 100
Desc: Yard Improvements	Dimensions:	RMV: 3360				
Func Obsc: 100	Econ %: 100	Other %: 100	Exception: 0	Adjust:	Adjust RMV: 0	

Floors

Type	Class	Display Group	Floor Size	Beds	Baths	Yr Blt	Eff Yr Blt	Inventory
No floor data available								

Accessories

Description	Class	Size SqFt	Eff Yr Blt	RMV	Quantity
YARD IMPROVEMENTS FAIR	2	0	1970	2753	1
					Exception: Y N

Improvements - Accessory Buildings

Bldg: 1	Code Area: 04500	Stat Class: 341	Year Blt:	Eff Year Blt:	Sq.Ft: 48	% Complete: 100		
Desc: Multi Purpose Shed (MP)	Dimensions:	RMV: 0						
Func Obsc: 0	Econ %: 100	Other %: 100	Exception: 0	Adjust:	Adjust RMV: 0			
<i>N/C</i>								
Floors								
Type	Class	Display Group	Floor Size	Beds	Baths	Yr Blt	Eff Yr Blt	Inventory
Multi-Purpose Bldg	4	Finished	48	0	0	0	0	Exception: Y N

Accessories

Description	Class	Size SqFt	Eff Yr Blt	RMV	Quantity
No accessory data available					

Bldg: 2	Code Area: 04500	Stat Class: 351	Year Blt: 1986	Eff Year Blt: 1986	Sq.Ft: 2400	% Complete: 100		
Desc: General Purpose Building (GB)	Dimensions: 80x30	RMV: 12740						
Func Obsc: 100	Econ %: 100	Other %: 100	Exception: 0	Adjust:	Adjust RMV: 0			
<i>N/C</i>								
Floors								
Type	Class	Display Group	Floor Size	Beds	Baths	Yr Blt	Eff Yr Blt	Inventory
General Purpose Bldg	5	Finished	2400	0	0	1986	1986	FAIR
								Exception: Y N

Accessories

Description	Class	Size SqFt	Eff Yr Blt	RMV	Quantity
No accessory data available					

Bldg: 4	Code Area: 04500	Stat Class: 321	Year Blt: 1989	Eff Year Blt: 1983	Sq.Ft: 1536	% Complete: 100
---------	------------------	-----------------	----------------	--------------------	-------------	-----------------

Desc: Hay Cover (HC)

Dimensions: 64x24

RMV: 2430

n/c

Func Obsc: 100

Econ %: 100

Other %: 100

Exception: 0

Adjust:

Adjust RMV: 0

Floors

Type	Class	Display Group	Floor Size	Beds	Baths	Yr Blt	Eff Yr Blt	Inventory	Exception: Y N
Hay Cover	4	Finished	1536	0	0	1989	1983	FAIR	

Accessories

Description	Class	Size SqFt	Eff Yr Blt	RMV	Quantity
No accessory data available					

Bldg: 6 Code Area: 04500 Stat Class: 321 Year Blt: 2005 Eff Year Blt: 1983 Sq.Ft: 868 % Complete: 100

Desc: Hay Cover (HC)

Dimensions: 62x14

RMV: 1370

n/c

Func Obsc: 100

Econ %: 100

Other %: 100

Exception: 0

Adjust:

Adjust RMV: 0

Floors

Type	Class	Display Group	Floor Size	Beds	Baths	Yr Blt	Eff Yr Blt	Inventory	Exception: Y N
Hay Cover	4	Finished	868	0	0	2005	1983	FAIR	

Accessories

Description	Class	Size SqFt	Eff Yr Blt	RMV	Quantity
No accessory data available					

Bldg: 7 Code Area: 04500 Stat Class: 357 Year Blt: Eff Year Blt: 1983 Sq.Ft: 1120 % Complete: 100

Desc: Frost Control

Dimensions:

RMV: 720

n/c

Func Obsc: 100

Econ %: 100

Other %: 100

Exception: 0

Adjust:

Adjust RMV: 0

Floors

Type	Class	Display Group	Floor Size	Beds	Baths	Yr Blt	Eff Yr Blt	Inventory	Exception: Y N
Frost Control	4	Finished	1120	0	0	0	1983		

Accessories

Description	Class	Size SqFt	Eff Yr Blt	RMV	Quantity
No accessory data available					




SKETCH/AREA TABLE ADDENDUM

SUBJECT INFO

File No.: 521343 Parcel No.: 071W11A 00800
 Property Address: 3871 VICTOR POINT RD NE
 City: Salem County: Marion State: OR ZipCode: 97381
 Owner:
 Client: Client Address:
 Appraiser Name: Inspection Date:

SKETCH

521343
071W11A 00800
SCALE = 1:40

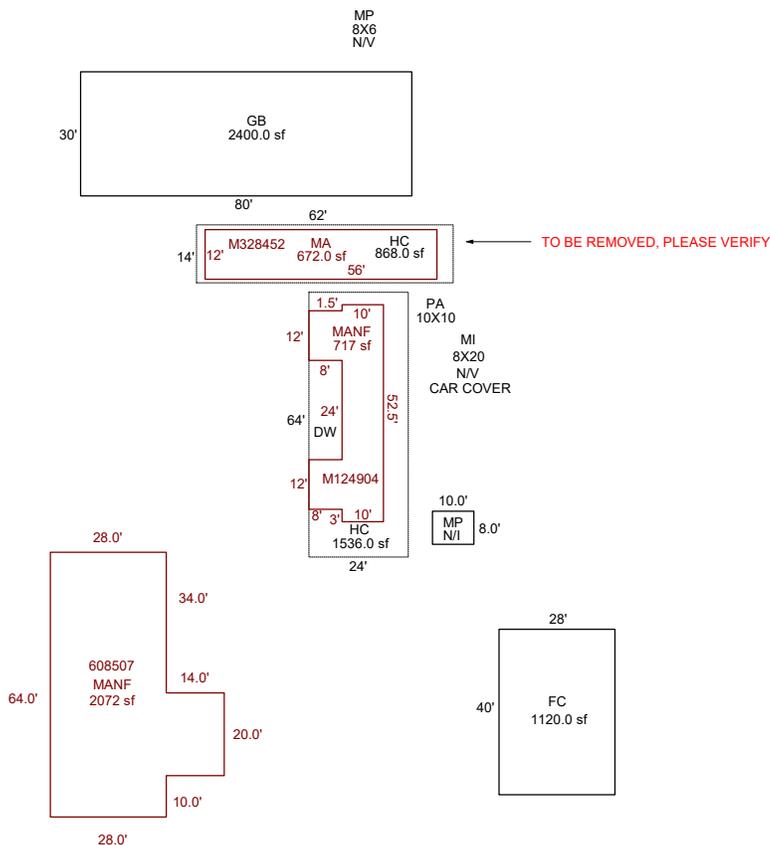

Sketch by ApexSketch

AREA CALCULATIONS SUMMARY

Code	Description	Factor	Net Size	Perimeter	Net Totals
GBA1	GB	1.0	2400.0	220.0	
	FC	1.0	1120.0	136.0	
	MP	1.0	80.0	36.0	3600.0
GLA	MANF	1.0	717.0	157.0	717.0
GLA1	MA	1.0	672.0	136.0	672.0
MANF	MANF	1.0	2072.0	212.0	2072.0
P/P	HC	1.0	1536.0	176.0	
	HC	1.0	868.0	152.0	2404.0
	Net LIVABLE	cnt	2 (rounded)		3,461
	Net BUILDING	cnt	3 (rounded)		3,600

COMMENT TABLE 1

DRAWN BY SRAGSDALE 9/30/13
 UPDATED BY CJURAN 01/31/2024
 UPDATED BY CLOBERG 10/09/24 23-007517 MANF
 UPDATED BY CLOBERG 12/16/24

COMMENT TABLE 2

MLH 01/29/2024
 MLH 12/04/24

COMMENT TABLE 3


TAGS L4
 TAGS L1

SKETCH/AREA TABLE ADDENDUM

SUBJECT INFO

File No.: 521343 Parcel No.: 071W11A 00800
 Property Address: 3871 VICTOR POINT RD NE
 City: SILVERTON County: MARION State: OR ZipCode: 97381
 Owner:
 Client: Client Address:
 Appraiser Name: Inspection Date:

SKETCH

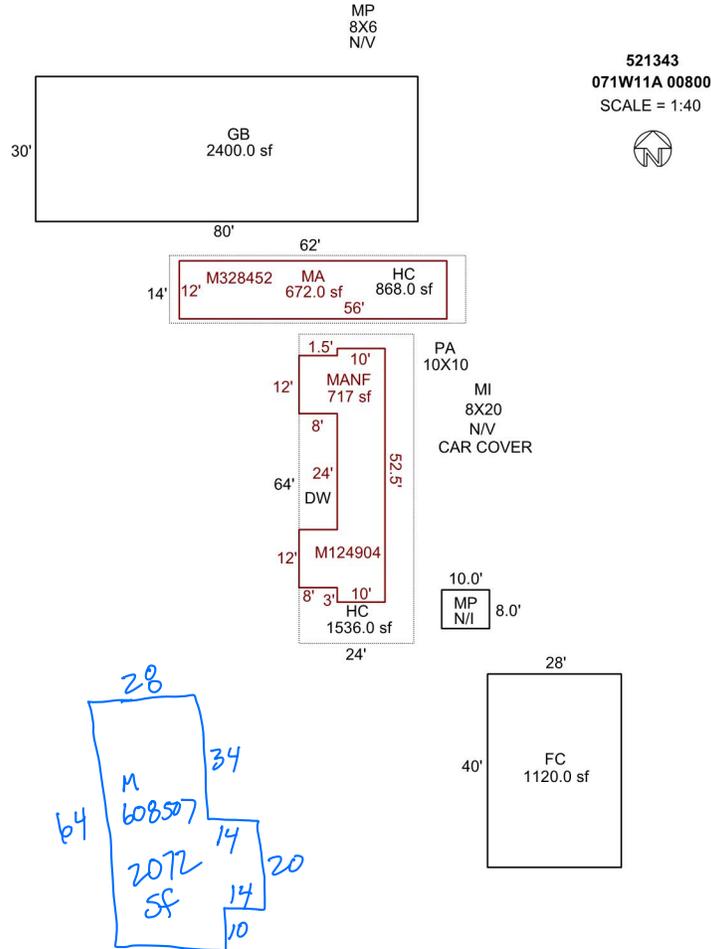

Sketch by Apex Sketch

AREA CALCULATIONS SUMMARY

Code	Description	Factor	Net Size	Perimeter	Net Totals
GBA1	GB	1.0	2400.0	220.0	
	FC	1.0	1120.0	136.0	
	MP	1.0	80.0	36.0	3600.0
GLA	MANF	1.0	717.0	157.0	717.0
GLA1	MA	1.0	672.0	136.0	672.0
P/P	HC	1.0	1536.0	176.0	
	HC	1.0	868.0	152.0	2404.0

COMMENT TABLE 1

DRAWN BY SRAGSDALE 9/30/13
 UPDATED BY CJURAN 01/31/2024

COMMENT TABLE 2

MLH 01/29/2024

COMMENT TABLE 3

TAGS L4

MLH 12/4/24

TAGS L1

Net LIVABLE	cnt	2	(rounded)		1,389
Net BUILDING	cnt	3	(rounded)		3,600



