

Acct ID: 536227 MTL: 093W090000800 Date: 11/16/25 Appr: GRH Prop Class: 401 RMV Prop Class: 401  
 Situs: 67 ANKENY HILL RD SE JEFFERSON OR 97352 MaSaNh: 06 06 000 Unit: 76871 Year: 2025  
 Last Date Appraised: 09/04/2018 Appraiser: GERARDO RAMIREZ HERNANDEZ Retag: Y N Tag info:  
 Owner: SLOAN, JAMES & SLOAN, KAREN Roll Type: R  
 Cycle: Tag Sales Verification Other: \_\_\_\_\_ Inspection level: 1 2 3 4 LCB TTO INSP AV: 345300  
 RMV Land: 284070 RMV Imp: 561800 RMV Total: 845870 MAV: 345300 MSAV: 0 SAV: 0  
 Comment:

**CONVERSION TO MA 70%, UPDATE INV**

**Notations**

No notation data available.

**OSDs**

Count	Code	Description	RMV	Code Area	Exception
1	MKTA	OSD - AVERAGE	50000	14530	0

**Land**

Site: 1 Code Area: 14530 Size: 1.93 Acres Use Code: 004 Zone: NREST SAV Use: Exception: 0  
 Class: Value Source: Rural at MKT Description: RMV: 234070 Exception: Y N  
 Adjustment(s): VWAR Fire Patrol: Description:  
 Comments: 81400130 . 2003-04 REAPPRAISAL.

**Improvements - Residence / Manufactured Structures**

Bldg: 4 Code Area: 14530 Stat Class: 142 + Year Blt: 2006 Eff Year Blt: 2006 Sq.Ft: 2976 % Complete: 100  
 Desc: Multi Story above grade Dimensions: RMV: 493180  
 Func Obsc: 100 Econ %: 100 Other %: 100 Exception: 0 Adjust: Adjust RMV: 0

**Floors**

Type	Class	Display Group	Floor Size	Beds	Baths	Yr Blt	Eff Yr Blt	Inventory	Exception
First Floor	4 +	Finished	1868	1	FB-1/ HB-1	2006	2006	ROOF, HVAC+, BATH+, KIT, BTH - 1, BATH - 1	Y N
Second Floor	4 +	Finished	1108	2	FB-1	2006	2006	HVAC+, BATH - 1	Y N
Garage Attached	4	Finished	553	1	1 Bath F.i.B	2006	2006	ROOF <u>Hvac 70%</u>	<u>Y</u> N

**Accessories**

Description	Class	Size SqFt	Eff Yr Blt	RMV	Quantity
No accessory data available					

Bldg: 5 Code Area: 14530 Stat Class: 107 Year Blt: Eff Year Blt: Sq.Ft: 0 % Complete: 100  
 Desc: Yard Improvements Dimensions: RMV: 9630  
 Func Obsc: 100 Econ %: 100 Other %: 100 Exception: 0 Adjust: Adjust RMV: 0

**Floors**

Type	Class	Display Group	Floor Size	Beds	Baths	Yr Blt	Eff Yr Blt	Inventory	Exception
No floor data available									

**Accessories**

Description	Class	Size SqFt	Eff Yr Blt	RMV	Quantity
YARD IMPROVEMENTS AVERAGE	4	1	0	9630	1
Exception: Y N					

**Improvements - Accessory Buildings**

Bldg: 1 Code Area: 14530 Stat Class: 351 Year Blt: 1995 Eff Year Blt: 1995 Sq.Ft: 1140 % Complete: 100  
 Desc: General Purpose Building (GB) Dimensions: 30x38 RMV: 10320  
 Func Obsc: 100 Econ %: 100 Other %: 100 Exception: 0 Adjust: Adjust RMV: 0

**Floors**

Type	Class	Display Group	Floor Size	Beds	Baths	Yr Blt	Eff Yr Blt	Inventory	Exception
General Purpose Bldg	5	Finished	1140	0	0	1995	1995	FAIR	Y N

**Accessories**

Description	Class	Size SqFt	Eff Yr Blt	RMV	Quantity
No accessory data available					

Bldg: 2 Code Area: 14530 Stat Class: 316 Year Blt: 2001 Eff Year Blt: 2001 Sq.Ft: 5760 % Complete: 100  
 Desc: Arenas (HA) Dimensions: 60x96 RMV: 44550  
 Func Obsc: 100 Econ %: 100 Other %: 100 Exception: 0 Adjust: Adjust RMV: 0

<b>Floors</b>									
Type	Class	Display Group	Floor Size	Beds	Baths	Yr Blt	Eff Yr Blt	Inventory	
Horse Arena	4	Finished	5760	0	0	2001	2001	FAIR	
									Exception: Y N

<b>Accessories</b>									
Description	Class	Size SqFt	Eff Yr Blt	RMV	Quantity				
No accessory data available									

Bldg: 3 Code Area: 14530 Stat Class: 341 Year Blt: 2001 Eff Year Blt: 1991 Sq.Ft: 80 % Complete: 100  
 Desc: Multi Purpose Shed (MP) Dimensions: 10x8 RMV: 0  
 Func Obsc: 100 Econ %: 100 Other %: 100 Exception: 0 Adjust: Adjust RMV: 0

*N/C*

<b>Floors</b>									
Type	Class	Display Group	Floor Size	Beds	Baths	Yr Blt	Eff Yr Blt	Inventory	
Multi-Purpose Bldg	5	Finished	80	0	0	2001	1991		
									Exception: Y N

<b>Accessories</b>									
Description	Class	Size SqFt	Eff Yr Blt	RMV	Quantity				
No accessory data available									

Bldg: 6 Code Area: 14530 Stat Class: 341 Year Blt: 1992 Eff Year Blt: 1992 Sq.Ft: 160 % Complete: 100  
 Desc: Multi Purpose Shed (MP) Dimensions: 10x16 RMV: 1330  
 Func Obsc: 100 Econ %: 100 Other %: 100 Exception: 0 Adjust: Adjust RMV: 0

*I/O*

<b>Floors</b>									
Type	Class	Display Group	Floor Size	Beds	Baths	Yr Blt	Eff Yr Blt	Inventory	
Multi-Purpose Bldg	5	Finished	160	0	0	1992	1992	<i>Avg</i>	
									Exception: Y N

<b>Accessories</b>									
Description	Class	Size SqFt	Eff Yr Blt	RMV	Quantity				
No accessory data available									

Bldg: 7 Code Area: 14530 Stat Class: 354 Year Blt: 1990 Eff Year Blt: 1990 Sq.Ft: 128 % Complete: 100  
 Desc: Lean-to Light (LTL) Dimensions: RMV: 170  
 Func Obsc: 100 Econ %: 100 Other %: 100 Exception: 0 Adjust: Adjust RMV: 0

*N/C*

<b>Floors</b>									
Type	Class	Display Group	Floor Size	Beds	Baths	Yr Blt	Eff Yr Blt	Inventory	
Lean-to Light Duty	5	Finished	128	0	0	1990	1990		
									Exception: Y N

<b>Accessories</b>									
Description	Class	Size SqFt	Eff Yr Blt	RMV	Quantity				
No accessory data available									

Bldg: 8 Code Area: 14530 Stat Class: 355 Year Blt: 2001 Eff Year Blt: 2001 Sq.Ft: 720 % Complete: 100  
 Desc: Lean-to Heavy (LTH) Dimensions: RMV: 2620  
 Func Obsc: 100 Econ %: 100 Other %: 100 Exception: 0 Adjust: Adjust RMV: 0

*N/C*

<b>Floors</b>									
Type	Class	Display Group	Floor Size	Beds	Baths	Yr Blt	Eff Yr Blt	Inventory	
Lean-to Heavy Duty	4	Finished	720	0	0	2001	2001		
									Exception: Y N

<b>Accessories</b>									
Description	Class	Size SqFt	Eff Yr Blt	RMV	Quantity				
No accessory data available									

ACCOUNT # 536227 DATE: 1/16/25 RMV CLASS \_\_\_\_\_ PROP CLASS \_\_\_\_\_  
 MTL \_\_\_\_\_ APPR GRH TAG Y N \_\_\_\_\_  
 COMMENTS: \_\_\_\_\_

RESIDENCE / MANUFACTURED STRUCTURES

ACCESSORY IMPROVEMENTS / OUTBUILDINGS

STAT 142 QLTY + - FLOOR MA  
 AREA 553 EFF AREA 553 BED 1  
 ROOF + HVAC +  
 BATH PKG: 1 BATH \_\_\_\_\_ BATH + \_\_\_\_\_ 1/2 BTH  
 FIREPLACE: \_\_\_\_\_  
 KITCHEN - +  
 YR BLT 2024 EFF YR 2024 ECON \_\_\_\_\_  
 % COMP 70 % GOOD \_\_\_\_\_ FUNC \_\_\_\_\_  
 EXCEPT Y N LUMP SUM: \_\_\_\_\_  
 MISC: \_\_\_\_\_  
 YI CLASS \_\_\_\_\_ F G A E  
 SKIRT + LIN FT \_\_\_\_\_  
 COMMENT: conversion AG to living space

STAT \_\_\_\_\_ QLTY + - FLOOR \_\_\_\_\_  
 AREA \_\_\_\_\_ EFF AREA \_\_\_\_\_ BED \_\_\_\_\_  
 ROOF + HVAC +  
 BATH PKG: \_\_\_\_\_ BATH \_\_\_\_\_ BATH + \_\_\_\_\_ 1/2 BTH  
 FIREPLACE: \_\_\_\_\_  
 KITCHEN - +  
 YR BLT \_\_\_\_\_ EFF YR \_\_\_\_\_ ECON \_\_\_\_\_  
 % COMP \_\_\_\_\_ % GOOD \_\_\_\_\_ FUNC \_\_\_\_\_  
 EXCEPT Y N LUMP SUM: \_\_\_\_\_  
 MISC: \_\_\_\_\_  
 YI CLASS \_\_\_\_\_ F G A E  
 SKIRT + LIN FT \_\_\_\_\_  
 COMMENT: \_\_\_\_\_

STAT \_\_\_\_\_ QLTY + - FLOOR \_\_\_\_\_  
 AREA \_\_\_\_\_ EFF AREA \_\_\_\_\_ BED \_\_\_\_\_  
 ROOF + HVAC +  
 BATH PKG: \_\_\_\_\_ BATH \_\_\_\_\_ BATH + \_\_\_\_\_ 1/2 BTH  
 FIREPLACE: \_\_\_\_\_  
 KITCHEN - +  
 YR BLT \_\_\_\_\_ EFF YR \_\_\_\_\_ ECON \_\_\_\_\_  
 % COMP \_\_\_\_\_ % GOOD \_\_\_\_\_ FUNC \_\_\_\_\_  
 EXCEPT Y N LUMP SUM: \_\_\_\_\_  
 MISC: \_\_\_\_\_  
 YI CLASS \_\_\_\_\_ F G A E  
 SKIRT + LIN FT \_\_\_\_\_  
 COMMENT: \_\_\_\_\_

TYPE \_\_\_\_\_  
 STAT / CLASS \_\_\_\_\_  
 SIZE \_\_\_\_\_  
 FAIR  
 AVERAGE  
 GOOD  
 EXCELLENT  
 BATH \_\_\_\_\_  
 YR BLT \_\_\_\_\_  
 EFF YR \_\_\_\_\_  
 % COMP \_\_\_\_\_  
 EXCEPT Y N  
 MISC: \_\_\_\_\_  
 COMMENT: \_\_\_\_\_


TYPE \_\_\_\_\_  
 STAT / CLASS \_\_\_\_\_  
 SIZE \_\_\_\_\_  
 FAIR  
 AVERAGE  
 GOOD  
 EXCELLENT  
 BATH \_\_\_\_\_  
 YR BLT \_\_\_\_\_  
 EFF YR \_\_\_\_\_  
 % COMP \_\_\_\_\_  
 EXCEPT Y N  
 MISC: \_\_\_\_\_  
 COMMENT: \_\_\_\_\_

# SKETCH/AREA TABLE ADDENDUM

## SUBJECT INFO

File No.: 536227 Parcel No.: 093W09 00800  
 Property Address: 67 ANKENY HILL RD SE  
 City: JEFFERSON County: MARION State: OR ZipCode: 97352  
 Owner:  
 Client: Client Address:  
 Appraiser Name: Inspection Date:

## SKETCH

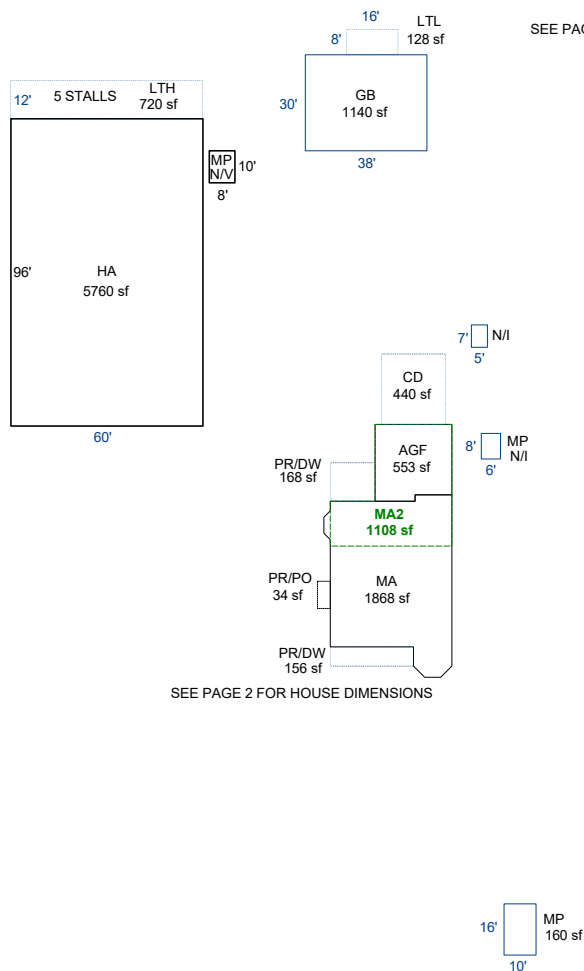

536227  
 093W09 00800  
 SCALE=1:60



Sketch by ApexSketch


AREA CALCULATIONS SUMMARY						COMMENT TABLE 1					
Code	Description	Factor	Net Size	Perimeter	Net Totals						
GBA1	HA	1.0	5760.0	312.0		UPDATED BY JRONDEMA 9/7/18 UPDATED BY CLOBERG 12/02/24 24-006916 AGF CONV					
	LTH	1.0	720.0	144.0							
	MP	1.0	80.0	36.0							
	LTL	1.0	128.0	48.0							
	GB	1.0	1140.0	136.0							
	MP	1.0	160.0	52.0	7988.0						
GLA1	MA	1.0	1867.8	187.6	1867.8						
GLA2	MA2	1.0	1108.0	152.0	1108.0						
GAR	AGF	1.0	553.0	96.0	553.0						
P/P	PR/DW	1.0	156.0	64.0		<table border="1" style="width: 100%; border-collapse: collapse;"> <thead> <tr style="background-color: #cccccc;"> <th style="width: 50%;">COMMENT TABLE 2</th> <th style="width: 50%;">COMMENT TABLE 3</th> </tr> </thead> <tbody> <tr> <td style="font-size: 1.2em; color: blue; vertical-align: top;">GRH 11/16/25</td> <td style="font-size: 1.2em; color: blue; vertical-align: top;">TAGS L3</td> </tr> </tbody> </table>		COMMENT TABLE 2	COMMENT TABLE 3	GRH 11/16/25	TAGS L3
	COMMENT TABLE 2	COMMENT TABLE 3									
	GRH 11/16/25	TAGS L3									
	PR/PO	1.0	34.0	25.0							
	CD	1.0	440.0	84.0							
PR/DW	1.0	168.0	52.0	798.0							
	Net LIVABLE	cnt	0 (rounded)		2,976						
	Net BUILDING	cnt	6 (rounded)		7,988						

# SKETCH/AREA TABLE ADDENDUM

## SUBJECT INFO

File No.: 536227 Parcel No.: 093W09 00800  
 Property Address: 67 ANKENY HILL RD SE  
 City: JEFFERSON County: MARION State: OR ZipCode: 97352  
 Owner:  
 Client: Client Address:  
 Appraiser Name: Inspection Date:

## SKETCH

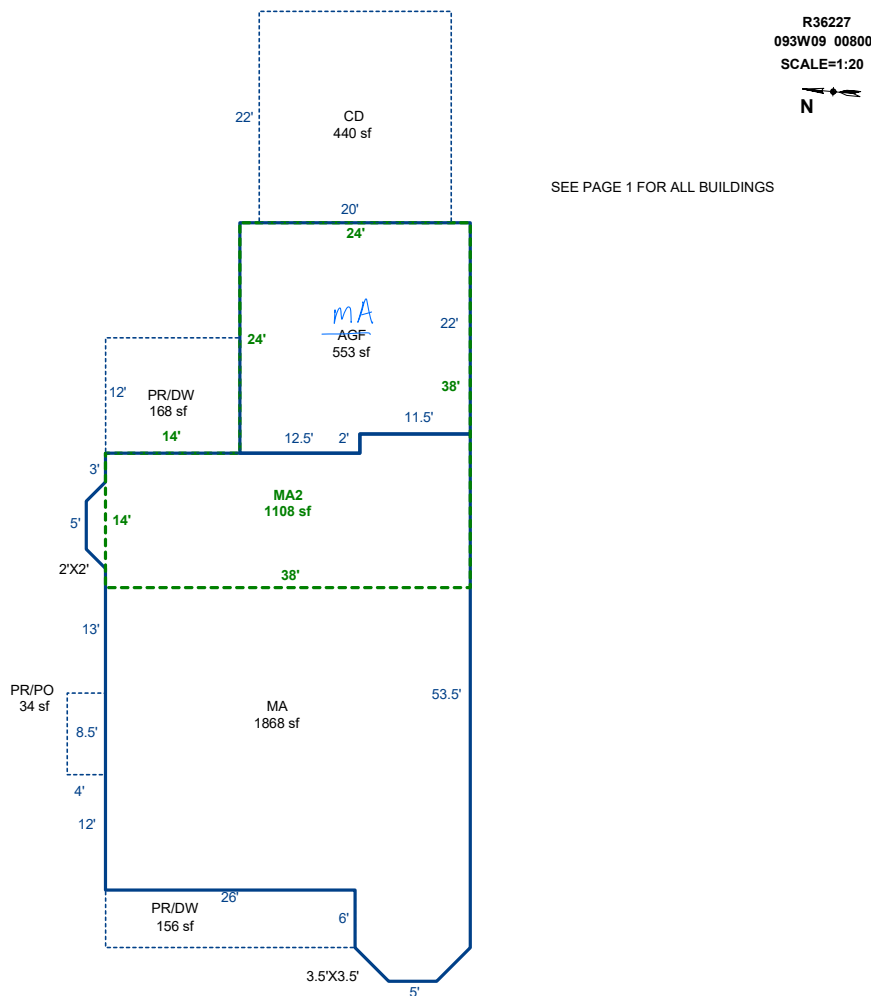

Sketch by ApexSketch

### AREA CALCULATIONS SUMMARY

Code	Description	Factor	Net Size	Perimeter	Net Totals
GLA1	MA	1.0	1867.8	187.6	1867.8
GLA2	MA2	1.0	1108.0	152.0	1108.0
GAR	AGF	1.0	553.0	96.0	553.0
P/P	PR/DW	1.0	156.0	64.0	
	PR/PO	1.0	34.0	25.0	
	CD	1.0	440.0	84.0	
	PR/DW	1.0	168.0	52.0	798.0

### COMMENT TABLE 1

UPDATED BY JRONDEMA 9/7/18  
 UPDATED BY CLOBERG 12/02/24 24-006916 AGF CONV

### COMMENT TABLE 2

GPH 1/16/25

### COMMENT TABLE 3

TAGS L3

Net LIVABLE                      cnt                      0      (rounded)                      2,976