

lak 4.16.25

Summary

Lead Appr: _____ Clerk: _____ Lead Clerk: _____ Appr: _____

Print Date: 3/10/2025

Acct ID: 132112

MTL: 083W09DC00200P1

Date: 4/3/25

Appr: 02

ts 4-23-25

Prop Class: 019

RMV Prop Class: 019

Situs: 205 BOONE RD SE # 61 SALEM, OR 97306

MaSaNh: 16 05 000

Unit: 143024

Year: 2025

Last Date Appraised: 05/11/2016

Appraiser: THERESA SWEARINGEN

Retag: Y N

Tag info:

Owner: PANCOAST, JUDY L

Roll Type: MS

Cycle

Tag

Sales Verification

Other: _____

Inspection level: 1 2 3 4

LCB

TTO

INSP

AV: 59060

RMV Land: 0

RMV Imp: 59060

RMV Total: 59060

MAV: 59680

MSAV: 0

SAV: 0

Comment: BRISTOL PARK, SPACE #61, MS SERIAL # ORFLM48AB137800G, X # X00216192, PERSONAL MS

Notations

No notation data available.

update FNU F/O

OSDs

No OSD data available.

Land

No land data available.

Improvements - Residence / Manufactured Structures

Bldg: 1

Code Area: 24010

Stat Class: 457

Year Blt: 1992

Eff Year Blt: 1992

Sq.Ft: 1512

% Complete: 100

Desc: MANUF STRUCT, CLASS 5, 26' THROUGH 28' WIDE DOUBLE

Dimensions: RMV: 59060

Func Obsc: 100

Econ %: 100


Other %: 100</

BUILDING DIAGRAM AND OUTBUILDINGS

ACCT NO: X216192

MAP NO: 083W-09DC

TAX LOT:

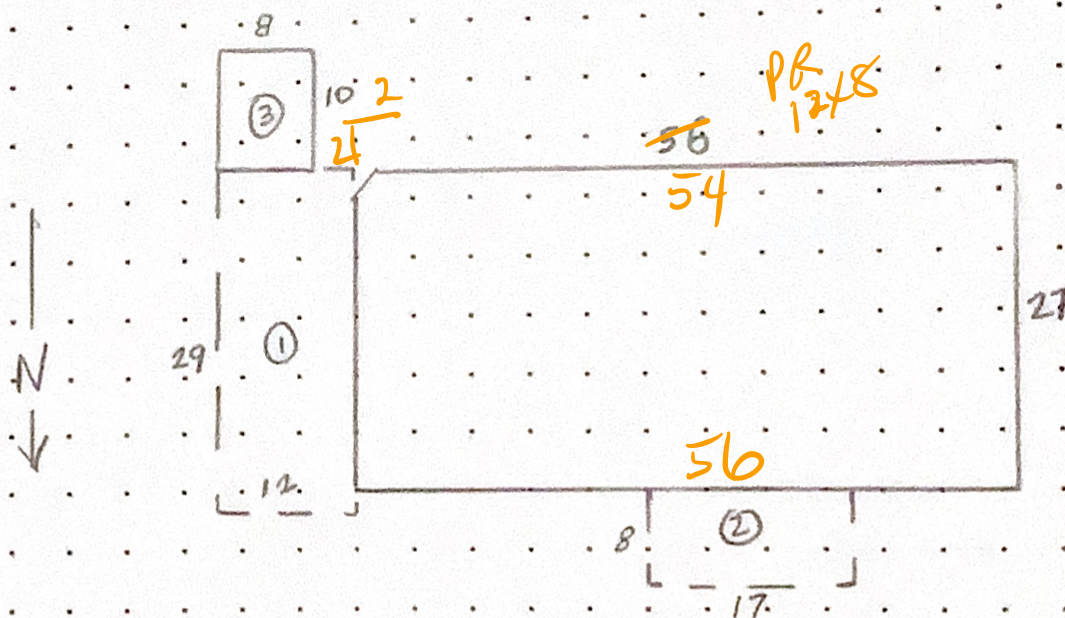

CALCULATIONS: $27 \times 56 = 1512 \text{ SF}$

SCALE: 1" = 20'

MEASUREMENT VERIFIED		YR BLT: 91	ADDRESS: BRISTOL PK-SP. 61	SALES	
DATE	BY	REMARKS:	BUILDER: FLEETWOOD OAK GROVE	Date	Amt.
8-19-92	DT/4				
1-27-97	DT/4				
8-4-04	28				