

Summary

Lead Appr: _____ Clerk: _____ Lead Clerk: _____ Appr: _____

Print Date: 3/10/2025

Acct ID: 132108

MTL: 083W09DC00100P1

Date: 4/3/25

Appr: 02

ts 4-23-25

Prop Class: 019

RMV Prop Class: 019

Situs: 205 BOONE RD SE # 10 SALEM, OR 97306

MaSaNh: 16 05 000

Unit: 143021

Year: 2025

Last Date Appraised: 03/10/2022

Appraiser: THERESA SWEARINGEN

Retag: Y N

Tag info:

Owner: WEBSTER, JUDITH ANN

Roll Type: MS

Cycle

Tag

Sales Verification

Other: _____

Inspection level: 1 2 3 4

LCB

TTO

INSP

AV: 47050

RMV Land: 0

RMV Imp: 54770

RMV Total: 54770

MAV: 47050

MSAV: 0

SAV: 0

Comment: 22-23: L2 3.10.22 TS

Notations

No notation data available.

update DM 5/3

OSDs

No OSD data available.

Land

No land data available.

Improvements - Residence / Manufactured Structures

Bldg: 1

Code Area: 24010

Stat Class: 457 -

Year Blt: 1992

Eff Year Blt: 1996

Sq.Ft: 1080

% Complete: 100

Desc: MANUF STRUCT, CLASS 5, 26' THROUGH 28' WIDE DOUBLE

Dimensions: 40x27

RMV: 54770

Func Obsc: 100

Econ %: 100

Other %: 100

Exception: 0

Adjust:

Adjust RMV: 0

Floors


Type	Class	Display Group	Floor Size	Beds	Baths	Yr Blt	Eff Yr Blt	Inventory
First Floor	5 -	Finished	1080	2	FB-2	1992	1996	HVAC+, ROOF+, SKIRT, KIT, BATH - 2
								Exception: Y N

Accessories

Description	Class	Size SqFt	Eff Yr Blt	RMV	Quantity
DECK	5	48	1996	486	0
MULTI-PURPOSE BUILDING	5	80	1996	775 0	0
ROOF EXTENSION OR PATIO COVER	5	408	1996	5443	0

Improvements - Accessory Buildings

No improvement data available for all other stat class types.

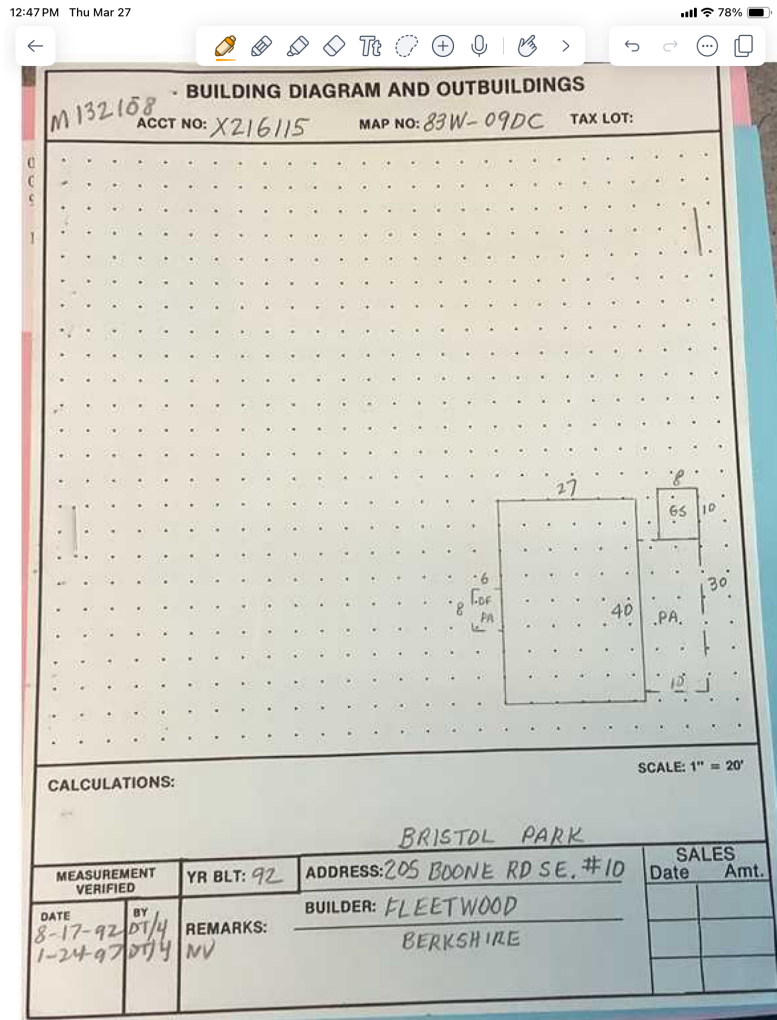

Some siding repair