

lak 4.16.25

Summary

Lead Appr: _____ Clerk: _____ Lead Clerk: _____ Appr: _____

Print Date: 3/10/2025

Acct ID: 132464

MTL: 083W09DC00200P1

Date: 4/3/25 Appr: 02 ts 4-23-25

Prop Class: 019

RMV Prop Class: 019

Situs: 205 BOONE RD SE # 62 SALEM, OR 97306

MaSaNh: 16 05 000

Unit: 132464

Year: 2025

Last Date Appraised: 01/03/2023

Appraiser: THERESA SWEARINGEN

Retag: Y N

Tag info:

Owner: KAZARIAN, APRIL

Roll Type: MS

Cycle

TagSales VerificationOther: _____Inspection level: 1 2, 3 4LCBTTOINSP

AV: 63590

RMV Land: 0

RMV Imp: 85100

RMV Total: 85100

MAV: 63590

MSAV: 0

SAV: 0

Comment: 23-24: L2 01.03.23 TS

Notations

No notation data available.

OSDs

No OSD data available.

Land

No land data available.

Improvements - Residence / Manufactured Structures

Bldg: 1

Code Area: 24010

Stat Class: 457

Year Blt: 1993

Eff Year Blt: 2000

Sq.Ft: 1188

% Complete: 100

Desc: MANUF STRUCT, CLASS 5, 26' THROUGH 28' WIDE DOUBLE

Dimensions: 44x27

RMV: 85100

Func Obsc: 100

Econ %: 100

Other %: 100

Exception: 0

Adjust:

Adjust RMV: 0

Floors


Type	Class	Display Group	Floor Size	Beds	Baths	Yr Blt	Eff Yr Blt	Inventory	
First Floor	5	Finished	1188	2	FB-2	1993	2000	KIT, HVAC+, ROOF+, SKIRT, BATH - 2	Exception: Y N

Accessories

Description	Class	Size SqFt	Eff Yr Blt	RMV	Quantity	
DECK	5	88	2000	1239	0	Exception: Y N
MULTI-PURPOSE BUILDING	4	80	1992	0	0	Exception: Y N
ROOF EXTENSION OR PATIO COVER	5	478	2000	8872	0	Exception: Y N

Improvements - Accessory Buildings

No improvement data available for all other stat class types.

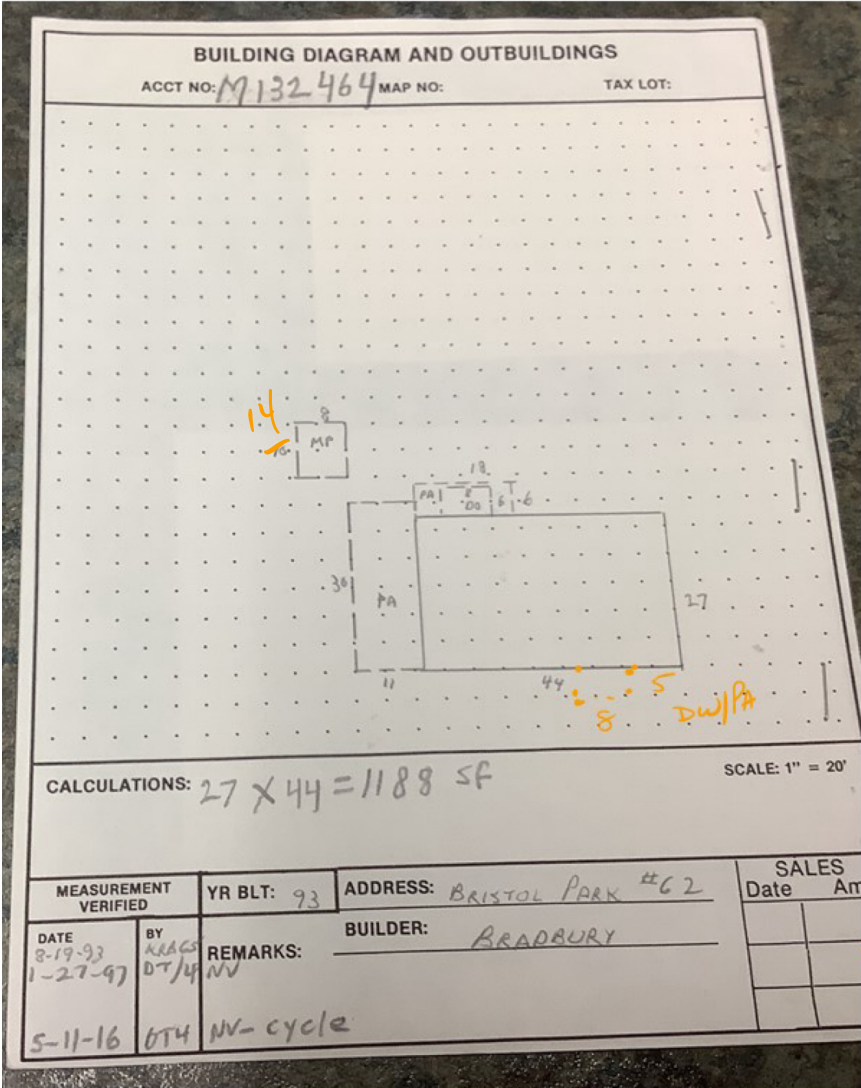

W.M.