

lak 5.23.25

Summary

Lead Appr: _____ Clerk: _____ Lead Clerk: _____ Appr: _____

Print Date: 4/1/2025

Acct ID: 132133

MTL: 062W31D001100P1

Date: 4/30/25

Appr: 02

Prop Class: 019

RMV Prop Class: 019

Situs: 5064 SILVER LOOP NE # 115 SALEM, OR 97305

MaSaNh: 13 05 000

Unit: 143038

Year: 2025

Last Date Appraised: 12/30/2015

Appraiser: THERESA SWEARINGEN

Retag: Y N

Tag info:

Owner: RODRIGUEZ SANDOVAL, MARIA DEL ROSARIO

Roll Type: MS

Cycle

Tag

Sales Verification

Other: _____

Inspection level: 1 2 3 4

LCB

TTO

INSP

AV: 46260

RMV Land: 0

RMV Imp: 53960

RMV Total: 53960

MAV: 46260

MSAV: 0

SAV: 0

Comment: COPPER CREEK ESTATES, SPACE #115, MS SERIAL # 1R910735EAB, X # X00216360, PERSONAL MS

Notations

No notation data available.

N/C

OSDs

No OSD data available.

Land

No land data available.

Improvements - Residence / Manufactured Structures

Bldg: 1	Code Area: 24010	Stat Class: 447 +	Year Blt: 1992	Eff Year Blt: 1992	Sq.Ft: 1340	% Complete: 100
Desc: MANUF STRUCT, CLASS 4, 26' THROUGH 28' WIDE DOUBLE				Dimensions:	RMV: 53960	
Func Obsc: 100	Econ %: 100	Other %: 100	Exception: 0	Adjust:	Adjust RMV: 0	

Floors

Type	Class	Display Group	Floor Size	Beds	Baths	Yr Blt	Eff Yr Blt	Inventory
First Floor	4 +	Finished	1340	3	FB-2	1992	1992	SKIRT, ROOF+, HVAC+, KIT-, BATH - 2
								Exception: Y N

Accessories

Description	Class	Size SqFt	Eff Yr Blt	RMV	Quantity
DECK	4	64	1992	549	0
ROOF EXTENSION OR PATIO COVER	4	64	1992	724	0
ROOF EXTENSION OR PATIO COVER	4	456	1992	5157	0

Improvements - Accessory Buildings

No improvement data available for all other stat class types.



tired food


BUILDING DIAGRAM AND OUTBUILDINGS

M132133

ACCT NO: ~~X216360~~

MAP NO: 62W-31D

TAX LOT:

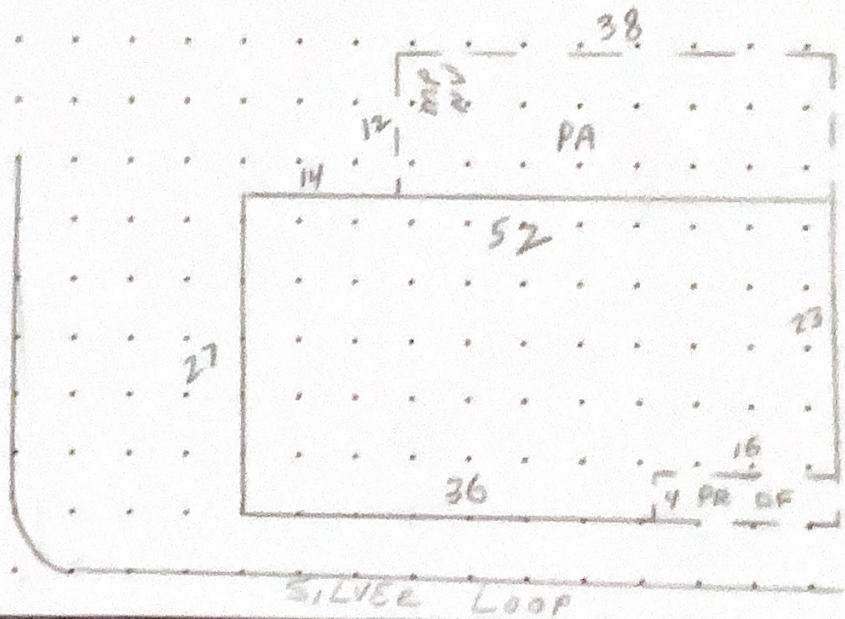

CALCULATIONS: $(27 \times 52) - (4 \times 16) = 1340 \text{ SF}$
 1404 64

SCALE: 1" = 20'

COPPER CREEK EST.

MEASUREMENT VERIFIED		YR BLT: 92	ADDRESS: 5064 SILVER LP NE	SALES	
DATE	BY	REMARKS:	BUILDER: SKYLINE	Date	Amt.
8-12-92	DT/4				
5-10-95	H. W. J.	② NV			
4-20-04	P/32	NV			
7-22-10	DT/4	NV			