

Acct ID: 516262 MTL: 061W16D000600 Date: **5.6.25** Appr: **JJS** Prop Class: 551 RMV Prop Class: 551  
 Situs: 8071 MT ANGEL HWY NE SILVERTON OR 97381 MaSaNh: 02 06 000 Unit: 89003 Year: 2024

Last Date Appraised: 02/26/2009 Appraiser: JORDAN SCHULTZ Retag: Y **N** Tag info: \_\_\_\_\_  
 Owner: HARPOLE, JASON LESTER 50% & \_\_\_\_\_ Roll Type: R

**Cycle** Tag Sales Verification Other: \_\_\_\_\_ Inspection level: 1 2 **3** 4 LCB TTO INSP AV: 97022  
 RMV Land: 330450 RMV Imp: 100260 RMV Total: 430710 MAV: 68560 MSAV: 28462 SAV: 72452

Comment:

**Upd Inv + Apex, LTL you**

Notations

RP/MS	Code	Description
MS	ZONED	FARM EFU ZONED
RP	ZONED	FARM EFU ZONED

OSDs

Count	Code	Description	RMV	Code Area	Exception
1	SAA	SA OSD - AVERAGE	45000	04470	0

Land

Site: 2 Code Area: 04470 Size: 1.00 Acres Use Code: 005 Zone: REST SAV Use: 011 Exception: 0  
 Class: Value Source: Farm Homesite Description: RMV: 33540 Exception: Y N

Adjustment(s): GSOIL, IRR Fire Patrol: Description:  
 Comments: Liability year - 2009 / 00400158

Site: 3 Code Area: 04470 Size: 6.53 Acres Use Code: 005 Zone: REST SAV Use: 011 Exception: 0  
 Class: 2B1 Value Source: Farm Use - EFU Description: TWO BENCH IRR RMV: 251910 Exception: Y N

Adjustment(s): GSOIL, IRR Fire Patrol: Description:  
 Comments: Liability year - 1974 / 00400158

Improvements - Residence / Manufactured Structures

Bldg: 1 Code Area: 04470 Stat Class: 131 - Year Blt: 1973 Eff Year Blt: 1973 Sq.Ft: 720 % Complete: 100  
 Desc: One Story Only Dimensions: RMV: 72260  
 Func Obsc: 100 Econ %: 100 Other %: 100 Exception: 0 Adjust: Adjust RMV: 0

Floors

Type	Class	Display Group	Floor Size	Beds	Baths	Yr Blt	Eff Yr Blt	Inventory	Exception
First Floor	3 -	Finished	720	2	FB-1	1973	1973	KIT-, HVAC, ROOF, BATH - 1	Y N

Accessories

Description	Class	Size SqFt	Eff Yr Blt	RMV	Quantity
<b>Y13F</b> ROOF EXTENSION OR PATIO COVER	3	126	1973	2741	1

Bldg: 2 Code Area: 04470 Stat Class: 138 Year Blt: 1973 Eff Year Blt: 1973 Sq.Ft: 0 % Complete: 100  
 Desc: Res other improvements Dimensions: RMV: 15910  
 Func Obsc: 100 Econ %: 100 Other %: 100 Exception: 0 Adjust: Adjust RMV: 0

Floors

Type	Class	Display Group	Floor Size	Beds	Baths	Yr Blt	Eff Yr Blt	Inventory	Exception
Garage Detached	3	Unfinished	210	0	0	1973	1973	ROOF	Y N

Accessories

Description	Class	Size SqFt	Eff Yr Blt	RMV	Quantity
No accessory data available					

Improvements - Accessory Buildings

Bldg: 3 Code Area: 04470 Stat Class: 353 Year Blt: 1979 Eff Year Blt: 1979 Sq.Ft: 2200 % Complete: 100  
 Desc: Machine Shed (MS) Dimensions: RMV: 3710  
 Func Obsc: 100 Econ %: 100 Other %: 100 Exception: 0 Adjust: Adjust RMV: 0

Floors

Type	Class	Display Group	Floor Size	Beds	Baths	Yr Blt	Eff Yr Blt	Inventory	Exception
Machine Shed	4	Finished	2200	0	0	1979	1979	<b>F</b>	Y N

Accessories

Description	Class	Size SqFt	Eff Yr Blt	RMV	Quantity
No accessory data available					

Bldg: 4	Code Area: 04470	Stat Class: 341	Year Blt: 1983	Eff Year Blt: 1983	Sq.Ft: 260	% Complete: 100			
Desc: Multi Purpose Shed (MP)			Dimensions: 26x10		RMV: 1300				
Func Obsc: 100	Econ %: 100	Other %: 100	Exception: 0	Adjust:	Adjust RMV: 0				
<b>Floors</b>									
<b>Type</b>	<b>Class</b>	<b>Display Group</b>	<b>Floor Size</b>	<b>Beds</b>	<b>Baths</b>	<b>Yr Blt</b>	<b>Eff Yr Blt</b>	<b>Inventory</b>	
Multi-Purpose Bldg	5	Finished	260	0	0	1983	1983	FAIR	Exception: Y N

<b>Accessories</b>						
<b>Description</b>	<b>Class</b>	<b>Size SqFt</b>	<b>Eff Yr Blt</b>	<b>RMV</b>	<b>Quantity</b>	
No accessory data available						

Bldg: 5	Code Area: 04470	Stat Class: 341	Year Blt: 1979	Eff Year Blt: 1979	Sq.Ft: 120	% Complete: 100			
Desc: Multi Purpose Shed (MP)			Dimensions: 12x10		RMV: 690				
Func Obsc: 100	Econ %: 100	Other %: 100	Exception: 0	Adjust:	Adjust RMV: 0				
<b>Floors</b>									
<b>Type</b>	<b>Class</b>	<b>Display Group</b>	<b>Floor Size</b>	<b>Beds</b>	<b>Baths</b>	<b>Yr Blt</b>	<b>Eff Yr Blt</b>	<b>Inventory</b>	
Multi-Purpose Bldg	5	Finished	120	0	0	1979	1979	FAIR	Exception: Y N

<b>Accessories</b>						
<b>Description</b>	<b>Class</b>	<b>Size SqFt</b>	<b>Eff Yr Blt</b>	<b>RMV</b>	<b>Quantity</b>	
No accessory data available						

Bldg: 6	Code Area: 04470	Stat Class: 341	Year Blt: 1972	Eff Year Blt: 1972	Sq.Ft: 312	% Complete: 100			
Desc: Multi Purpose Shed (MP)			Dimensions: 26x12		RMV: 1050				
Func Obsc: 100	Econ %: 100	Other %: 100	Exception: 0	Adjust:	Adjust RMV: 0				
<b>Floors</b>									
<b>Type</b>	<b>Class</b>	<b>Display Group</b>	<b>Floor Size</b>	<b>Beds</b>	<b>Baths</b>	<b>Yr Blt</b>	<b>Eff Yr Blt</b>	<b>Inventory</b>	
Multi-Purpose Bldg	4	Finished	312	0	0	1972	1972	F	Exception: Y N

<b>Accessories</b>						
<b>Description</b>	<b>Class</b>	<b>Size SqFt</b>	<b>Eff Yr Blt</b>	<b>RMV</b>	<b>Quantity</b>	
No accessory data available						

Bldg: 7	Code Area: 04470	Stat Class: 351	Year Blt: 1988	Eff Year Blt: 1988	Sq.Ft: 558	% Complete: 100			
Desc: General Purpose Building (GB)			Dimensions:		RMV: 3400				
Func Obsc: 100	Econ %: 100	Other %: 100	Exception: 0	Adjust:	Adjust RMV: 0				
<b>Floors</b>									
<b>Type</b>	<b>Class</b>	<b>Display Group</b>	<b>Floor Size</b>	<b>Beds</b>	<b>Baths</b>	<b>Yr Blt</b>	<b>Eff Yr Blt</b>	<b>Inventory</b>	
General Purpose Bldg	5	Finished	558	0	0	1988	1988	F	Exception: Y N

<b>Accessories</b>						
<b>Description</b>	<b>Class</b>	<b>Size SqFt</b>	<b>Eff Yr Blt</b>	<b>RMV</b>	<b>Quantity</b>	
No accessory data available						

Bldg: 8	Code Area: 04470	Stat Class: 354	Year Blt:	Eff Year Blt:	Sq.Ft: 320	% Complete: 100			
Desc: Lean-to Light (LTL)			Dimensions: 40x8		RMV: 1300				
Func Obsc: 100	Econ %: 100	Other %: 100	Exception: 0	Adjust:	Adjust RMV: 0				
<b>Floors</b>									
<b>Type</b>	<b>Class</b>	<b>Display Group</b>	<b>Floor Size</b>	<b>Beds</b>	<b>Baths</b>	<b>Yr Blt</b>	<b>Eff Yr Blt</b>	<b>Inventory</b>	
Lean to Light Duty	4	Finished	320	0	0	0	0		Exception: Y N

<b>Accessories</b>						
<b>Description</b>	<b>Class</b>	<b>Size SqFt</b>	<b>Eff Yr Blt</b>	<b>RMV</b>	<b>Quantity</b>	
No accessory data available						

Bldg: 9	Code Area: 04470	Stat Class: 357	Year Blt: 1986	Eff Year Blt: 1986	Sq.Ft: 480	% Complete: 100			
Desc: Frost Control			Dimensions: 40x12		RMV: 400				
Func Obsc: 100	Econ %: 100	Other %: 100	Exception: 0	Adjust:	Adjust RMV: 0				
<b>Floors</b>									
<b>Type</b>	<b>Class</b>	<b>Display Group</b>	<b>Floor Size</b>	<b>Beds</b>	<b>Baths</b>	<b>Yr Blt</b>	<b>Eff Yr Blt</b>	<b>Inventory</b>	
Frost Control	4	Finished	480	0	0	1986	1986		Exception: Y N

<b>Accessories</b>						
<b>Description</b>	<b>Class</b>	<b>Size SqFt</b>	<b>Eff Yr Blt</b>	<b>RMV</b>	<b>Quantity</b>	
No accessory data available						

Bldg: 10	Code Area: 04470	Stat Class: 341	Year Blt:	Eff Year Blt:	Sq.Ft: 100	% Complete: 100
Desc: Multi Purpose Shed (MP)			Dimensions: 10x10		RMV: 0	

Func Obsc: 100

Econ %: 100

Other %: 100

Exception: 0

Adjust:

Adjust RMV: 0

**Floors**

Type	Class	Display Group	Floor Size	Beds	Baths	Yr Blt	Eff Yr Blt	Inventory
Multi-Purpose Bldg	5	Finished	100	0	0	0	0	Exception: Y N

**Accessories**

Description	Class	Size SqFt	Eff Yr Blt	RMV	Quantity
No accessory data available					

Bldg: 11 Code Area: 04470 Stat Class: 357 Year Blt: Eff Year Blt: 1986 Sq.Ft: 288 % Complete: 100

Desc: Frost Control

Dimensions:

RMV: 240

Func Obsc: 100

Econ %: 100

Other %: 100

Exception: 0

Adjust:

Adjust RMV: 0




**Floors**

Type	Class	Display Group	Floor Size	Beds	Baths	Yr Blt	Eff Yr Blt	Inventory
Frost Control	4	Finished	288	0	0	1986	1986	Exception: Y N


**Accessories**

Description	Class	Size SqFt	Eff Yr Blt	RMV	Quantity
No accessory data available					

341 mpS 10x12 Existing 2016 NO VALUE  
 354 LTL 7x26 Existing 2016 NO VALUE

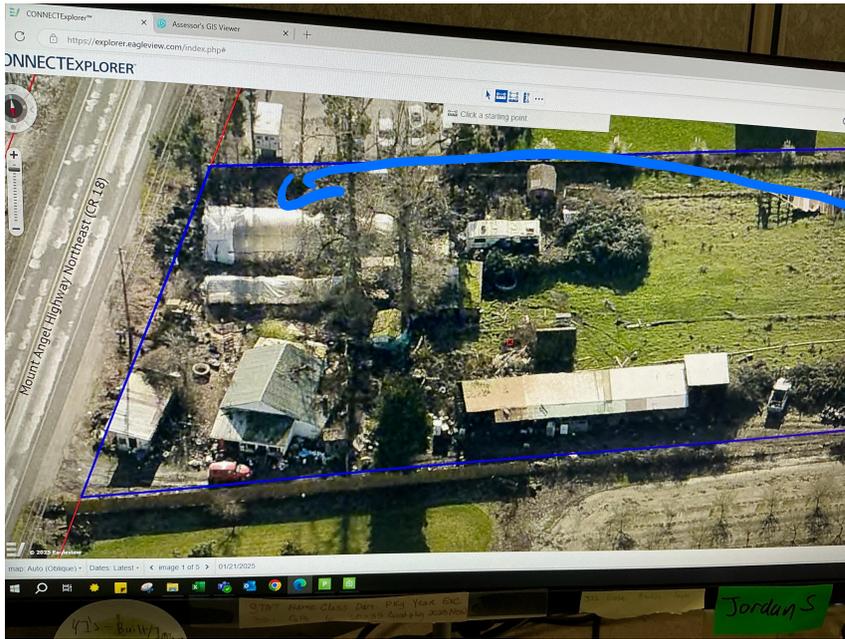

FL moved

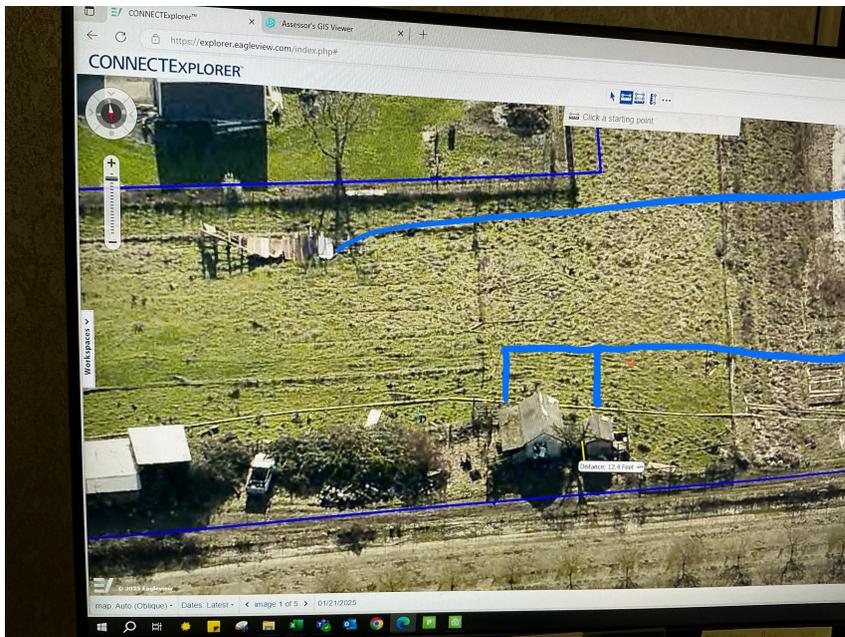

LTL Gone


LTL  
+ MP  
NRV

# SKETCH/AREA TABLE ADDENDUM

## SUBJECT INFO

File No.: 516262 Parcel No.: 061W16D 00600  
 Property Address: 8071 MT ANGEL HY NE  
 City: SILVERTON County: MARION State: OR ZipCode: 97381  
 Owner:  
 Client: Client Address:  
 Appraiser Name: Inspection Date:

## SKETCH

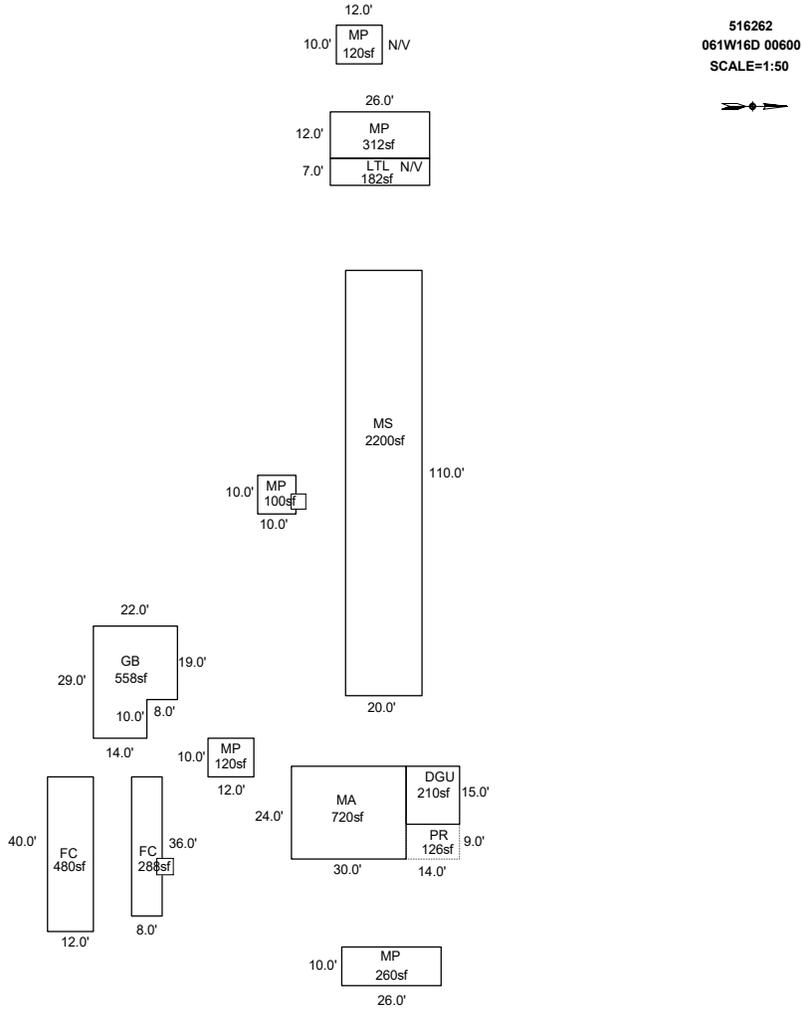

### AREA CALCULATIONS SUMMARY

Code	Description	Factor	Net Size	Perimeter	Net Totals
GBA1	MS	1.0	2200.0	260.0	
	MP	1.0	260.0	72.0	
	MP	1.0	120.0	44.0	
	MP	1.0	312.0	76.0	
	GB	1.0	558.0	102.0	
	FC	1.0	480.0	104.0	
	FC	1.0	288.0	88.0	
	MP	1.0	100.0	40.0	
	LTL	1.0	182.0	66.0	
	MP	1.0	120.0	44.0	4620.0
	GLA1	MA	1.0	720.0	108.0
GAR	DGU	1.0	210.0	58.0	210.0
P/P	PR	1.0	126.0	46.0	126.0
	Net LIVABLE	cnt	0 (rounded)		720
	Net BUILDING	cnt	10 (rounded)		4,620

### COMMENT TABLE 1

DRAWN BY JRONDEMA 9/6/17  
 UPDATED BY CLOBERG 05/13/25

### COMMENT TABLE 2

JIS 05/06/25

### COMMENT TABLE 3

CYCLE L3