

Summary

Lead Appr: _____ Clerk: **lak 5.27.25** Lead Clerk: _____ Appr: _____

Print Date: 4/1/2025

Acct ID: 349711

MTL: 062W31D001100P1

Date: **4/30/25** Appr: **02** Prop Class: 019

ts 6-20-25

RMV Prop Class: 019

Situs: 5123 SILVER LOOP NE SALEM, OR 97305

MaSaNh: 13 05 000

Unit: 349711

Year: 2025

Last Date Appraised: 06/19/2015

Appraiser: THERESA SWEARINGEN

Retag: Y N

Tag info:

Owner: RAMOS ARREDONDO, MARIA A &

Roll Type: MS

Cycle

Tag

Sales Verification

Other: _____

Inspection level: 1 2 **3** 4

LCB

TTO

INSP

AV: 57850

RMV Land: 0

RMV Imp: 133920

RMV Total: 133920

MAV: 57850

MSAV: 0

SAV: 0

Comment: COPPER CREEK ESTATES, SPACE #83, MS SERIAL # FLE210OR1215204AB, Home ID 366009, PERSONAL MS

update inv I/O

Notations

No notation data available.

OSDs

No OSD data available.

Land

No land data available.

Improvements - Residence / Manufactured Structures

Bldg: 1	Code Area: 24010	Stat Class: 457	Year Blt: 2012	Eff Year Blt: 2012	Sq.Ft: 1404	% Complete: 100
Desc: MANUF STRUCT, CLASS 5, 26' THROUGH 28' WIDE DOUBLE					Dimensions: 27x52	RMV: 133920
Func Obsc: 100	Econ %: 100	Other %: 100	Exception: 0	Adjust:	Adjust RMV: 0	

Floors

Type	Class	Display Group	Floor Size	Beds	Baths	Yr Blt	Eff Yr Blt	Inventory	Exception: Y N
First Floor	5	Finished	1404	3	FB-2	2012	2012	KIT-, HVAC, SKIRT, ROOF+, BATH - 2	N
Carport Detached	3	Unfinished	352	0	0	2012	2012	Roof	N

Accessories

Description	Class	Size SqFt	Eff Yr Blt	RMV	Quantity	Exception: Y N
DECK	5	64	2012	1267	0	

Improvements - Accessory Buildings

No improvement data available for all other stat class types.




W.M.

BUILDING DIAGRAM AND OUTBUILDINGS

ACCT NO: **M349711**

MAP NO: **062W31D**

TAX LOT: **01100**

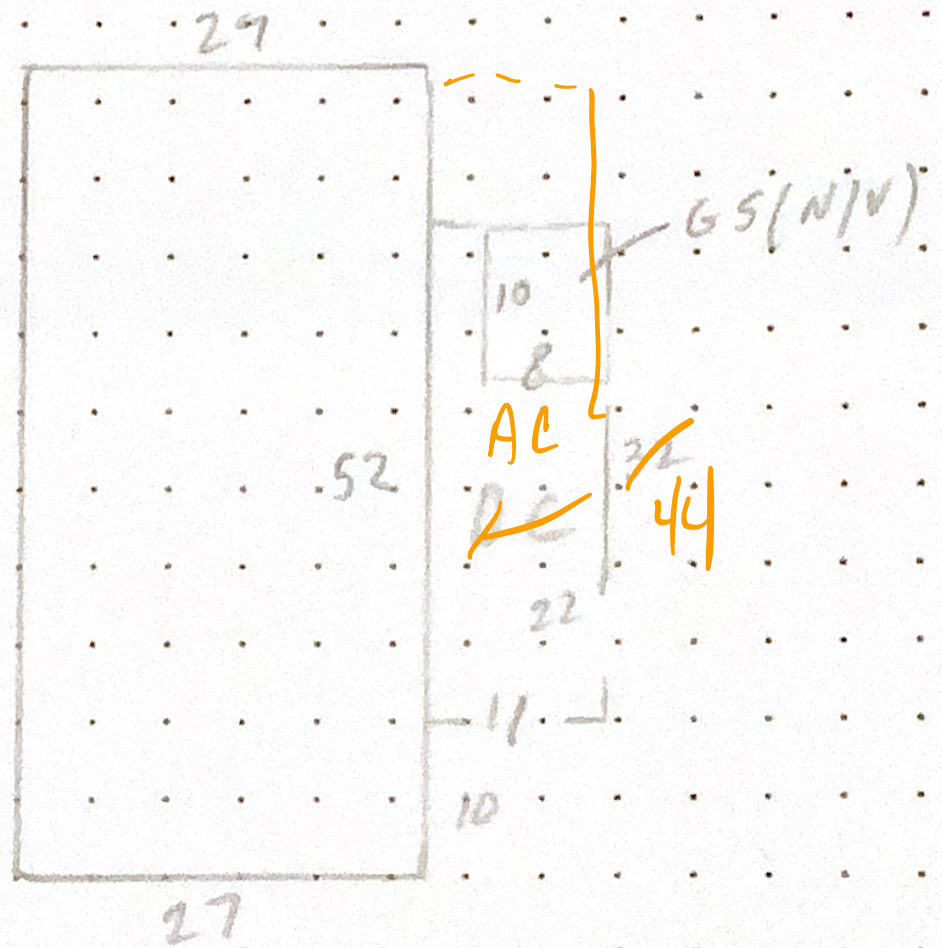

CALCULATIONS: $27 \times 52 = 1404 \text{ SF}$

SCALE: 1" = 20'

MEASUREMENT
VERIFIED

YR BLT: **2012**

ADDRESS: **5123 SILVER LP**

SALES
Date Amt.

DATE

BY

BUILDER: **FLEETWOOD**

REMARKS:

MODEL- **WESTON XTREME**

3-4-13

DT4

Date	Amt.