

Summary

Lead Appr:_____

Clerk:_____

Lead Clerk:_____

Appr:_____

Print Date: 4/1/2025

Acct ID: 351763

MTL: 062W31D001100P1

Date: 4/30/25

Appr: 02

Prop Class: 019

RMV Prop Class: 019

Situs: 5159 SILVER LOOP NE # 128 SALEM, OR 97305

MaSaNh: 13 05 000

Unit: 351763

Year: 2025

Last Date Appraised: 03/04/2015

Appraiser: THERESA SWEARINGEN

Retag: Y N

Tag info:

Owner: PURECO, ARMONDO

Roll Type: MS

Cycle: Tag Sales Verification Other:_____

Inspection level: 1 2 3 4

LCB TTO INSP

AV: 60470

RMV Land: 0

RMV Imp: 145710

RMV Total: 145710

MAV: 60470

MSAV: 0

SAV: 0

Comment: COPPER CREEK ESTATES, SPACE #181, MS SERIAL # FLE2100R1416372AB, Home ID 379678, PERSONAL MS

ts 6-20-25

Notations

No notation data available.

OSDs

No OSD data available.

Land

No land data available.

Improvements - Residence / Manufactured Structures

Bldg: 1

Code Area: 24010

Stat Class: 457 +

Year Blt: 2014

Eff Year Blt: 2014

Sq.Ft: 1404

% Complete: 100

Desc: MANUF STRUCT, CLASS 5, 26' THROUGH 28' WIDE DOUBLE

Dimensions: 52x27

RMV: 145710

Func Obsc: 100

Econ %: 100

Other %: 100

Exception: 0

Adjust:

Adjust RMV: 0

Floors

Type	Class	Display Group	Floor Size	Beds	Baths	Yr Blt	Eff Yr Blt	Inventory	
First Floor	5 +	Finished	1404	3	FB-2	2014	2014	BATH+, ROOF+, SKIRT, HVAC+, KIT-, BATH - 2	Exception: Y N
Carport Attached	3 +	Unfinished	348	0	0	2014	2014		Exception: Y N

Accessories

Description	Class	Size SqFt	Eff Yr Blt	RMV	Quantity
No accessory data available					

Improvements - Accessory Buildings

No improvement data available for all other stat class types.




Original

BUILDING DIAGRAM AND OUTBUILDINGS

ACCT NO: M351763

MAP NO: 062W31D

TAX LOT: 01100

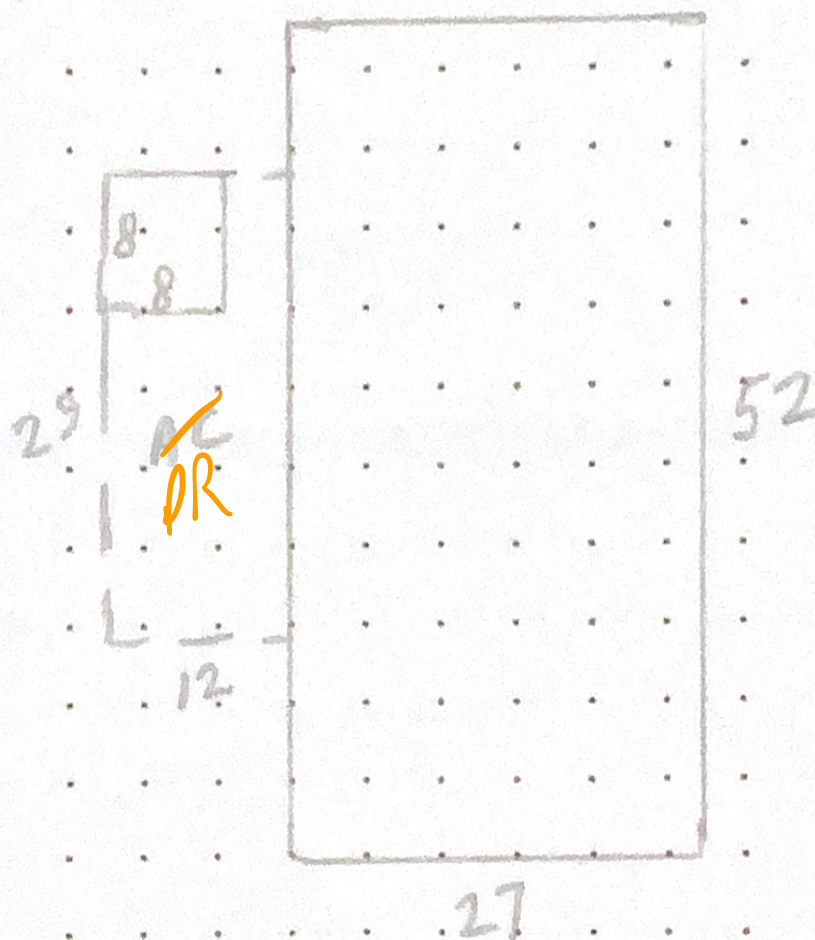

CALCULATIONS: $27 \times 52 = 1,404$

SCALE: 1" = 20'

MEASUREMENT
VERIFIED

YR BLT: 2014

ADDRESS: 5159 Silver Lp NE

SALES
Date Amt.

DATE

BY

BUILDER: Fleetwood

REMARKS:

model: Weston Xtreme

3-4-15

DT4
