

lak 5.28.25

Summary

Lead Appr: _____ Clerk: _____ Lead Clerk: _____ Appr: _____

Print Date: 4/1/2025

Acct ID: 354155

MTL: 062W31D001100P1

Date: 4/30/25

Appr: 02

Prop Class: 019

RMV Prop Class: 019

Situs: 4361 CRYSTAL AVE NE # 201 SALEM, OR 97305

MaSaNh: 13 05 000

Unit: 354155

Year: 2025

Last Date Appraised: 12/08/2017

Appraiser: THERESA SWEARINGEN

Retag: Y N

Tag info:

Owner: ARCHER, REBECCA

Roll Type: MS

Cycle Tag

Sales Verification

Other: _____

Inspection level: 1 2 3 4

LCB

TTO

INSP

AV: 89760

RMV Land: 0

RMV Imp: 152040

RMV Total: 152040

MAV: 89760

MSAV: 0

SAV: 0

Comment: COPPER CREEK ESTATES, SPACE #201, MS SERIAL # FLE210OR1718139AB, Home ID 395679, PERSONAL MS

Notations

No notation data available.

update DW I/O

OSDs

No OSD data available.

Land

No land data available.

Improvements - Residence / Manufactured Structures

Bldg: 1	Code Area: 24010	Stat Class: 457 +	Year Blt: 2017	Eff Year Blt: 2017	Sq.Ft: 1512	% Complete: 100
Desc: MANUF STRUCT, CLASS 5, 26' THROUGH 28' WIDE DOUBLE					Dimensions: 56x27	RMV: 152040
Func Obsc: 100	Econ %: 100	Other %: 100	Exception: 0	Adjust:	Adjust RMV: 0	

Floors

Type	Class	Display Group	Floor Size	Beds	Baths	Yr Blt	Eff Yr Blt	Inventory	Exception: Y N
First Floor	5 +	Finished	1512	4	FB-2	2017	2017	HVAC, SKIRT, KIT+, BATH - 2, ROOF+	Y N
Carport Attached	5 +	Unfinished	72	0	0	2017	2017	N/V	Y N

Accessories

Description	Class	Size SqFt	Eff Yr Blt	RMV	Quantity	Exception: Y N
DECK	5	60	2017	1241	0	Y N
PATIO	5	334	2017	1727	0	Y N
ROOF EXTENSION OR PATIO COVER	5	334	2017	9105	0	Y N

Delite AC roof

Improvements - Accessory Buildings

No improvement data available for all other stat class types.




PR into AC

BUILDING DIAGRAM AND OUTBUILDINGS

ACCT NO: M354155

MAP NO: 062W31D

TAX LOT: 0110d

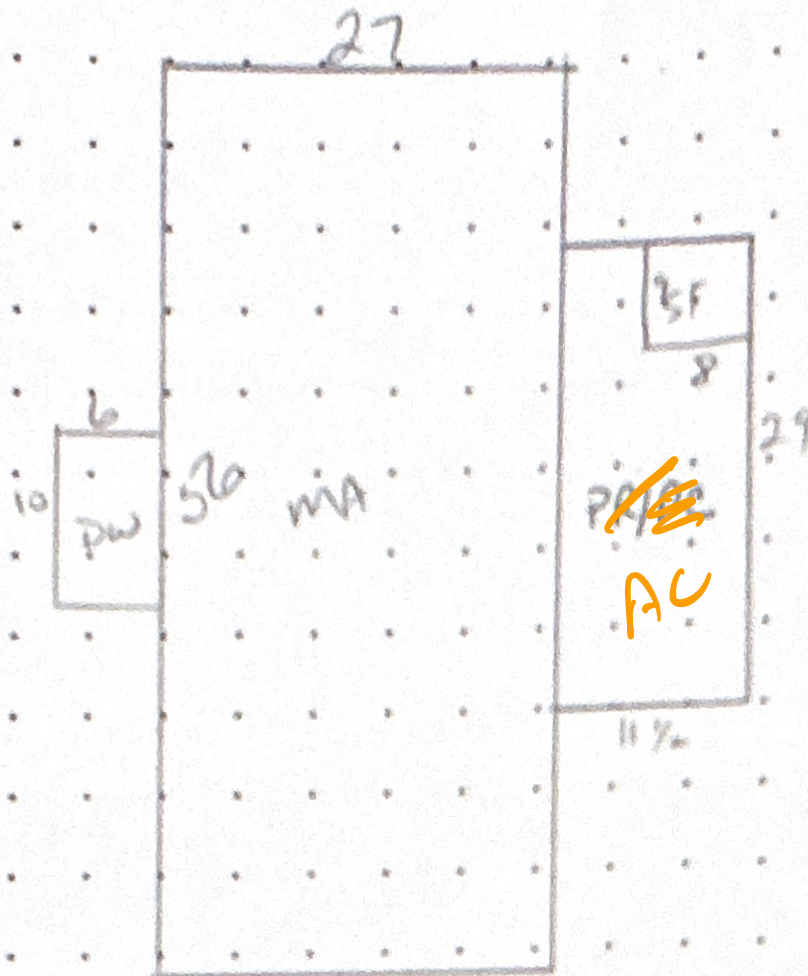

CALCULATIONS:

SCALE: 1" = 20'

MEASUREMENT
VERIFIED

YR BLT: 2017

ADDRESS: 4361 Crystal Ave NE

BUILDER:

REMARKS:

DATE

BY

12-8-17

02