

Summary

Lead Appr: Clerk: Lead Clerk: Appr:

Print Date:

Acct ID: 128558 MTL: 062W31D000500P1 Date: Appr: Prop Class: 019 RMV Prop Class: 019

Situs: 5422 PORTLAND RD NE # 88 SALEM, OR 97305 MaSaNh: 13 05 003 Unit: 141500 Year: 2025

Last Date Appraised: 04/19/2016 Appraiser: THERESA SWEARINGEN Retag: Y N Tag info:

Owner: GREENWOOD, DONNA J Roll Type: MS

Cycle Tag Sales Verification Other: Inspection level: 1 2 3 4 LCB TTO INSP AV: 39930

RMV Land: 0 RMV Imp: 52530 RMV Total: 52530 MAV: 39930 MSAV: 0 SAV: 0

Comment: ARROWHEAD M.H.P., SPACE #88, MS SERIAL # D56E23062, X # X00153794, PERSONAL MS

Notations

No notation data available.

OSDs

No OSD data available.

Land

No land data available.

Improvements - Residence / Manufactured Structures

Bldg: 1 Code Area: 24010 Stat Class: 456 Year Blt: 1978 Eff Year Blt: 1981 Sq.Ft: 1344 % Complete: 100
Desc: MANUF STRUCT, CLASS 5, 24' WIDE DOUBLE Dimensions: 56x24 RMV: 52530
Func Obsc: 100 Econ %: 100 Other %: 100 Exception: 0 Adjust: Adjust RMV: 0

Floors

Type	Class	Display Group	Floor Size	Beds	Baths	Yr Blt	Eff Yr Blt	Inventory	Exception: Y N
First Floor	5	Finished	1344	3	FB-2	1978	1981	KIT+, SKIRT, ROOF+, BATH - 2, HVAC+	

Accessories

Description	Class	Size SqFt	Eff Yr Blt	RMV	Quantity	Exception: Y N
DECK	5	160	1981	1162	0	
DECK	5	224	1981	1626	0	
ROOF EXTENSION OR PATIO COVER	5	320	1981	3062	0	
ROOF EXTENSION OR PATIO COVER	5	360	1981	3445	0	


Improvements - Accessory Buildings

No improvement data available for all other stat class types.



Viewed.
New 2001

TAX LOT:

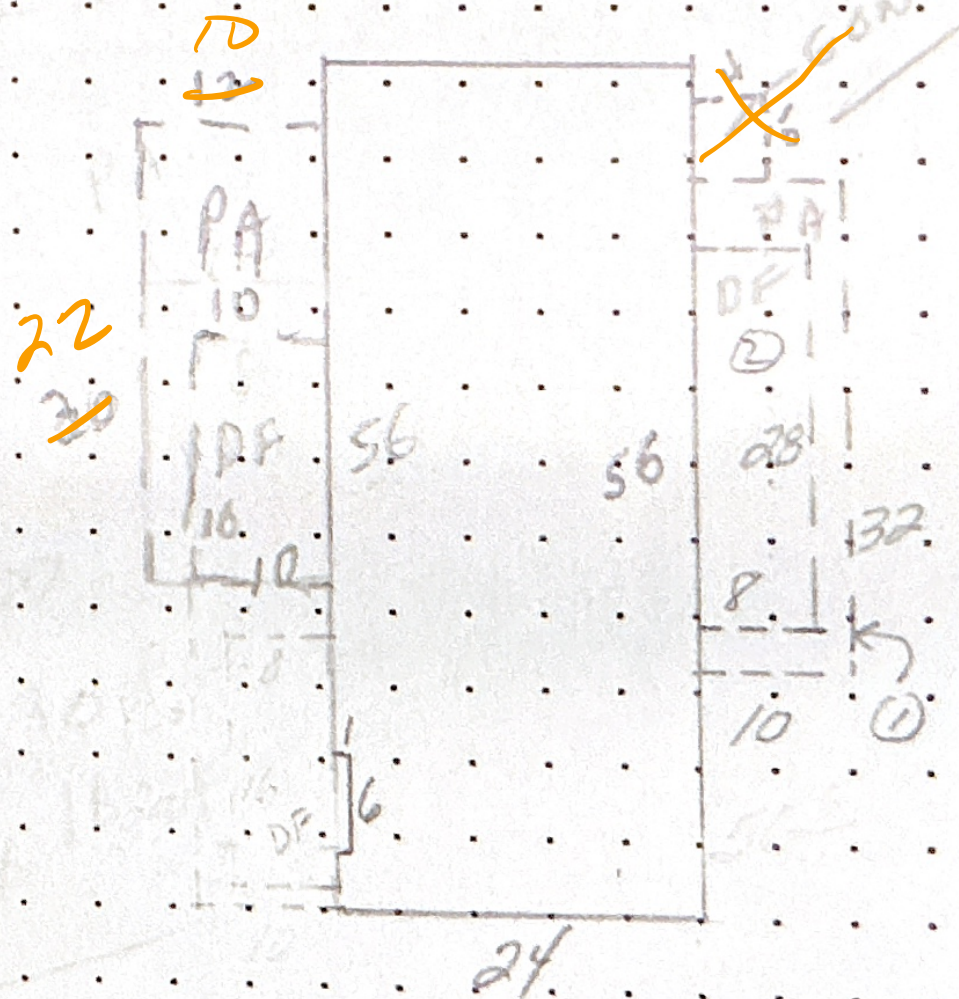

SCALE: 1" = 20'

1338

MEASUREMENT VERIFIED		YR BLT: 78	ADDRESS: ARROWHEAD MP #88		SALES	
DATE	BY	REMARKS:	BUILDER: GOLDEN SUNRISE		Date	Amt.
12/28/87	65					
2-27-95	79					
9-21-11	DT4					