

Acct ID: 535183 MTL: 092W080001100 Date: 6/4/25 Appr: MLH Prop Class: 551 RMV Prop Class: 551
 Situs: 4900 COOK RD SE TURNER OR 97392 MaSaNh: 07 06 000 Unit: 71400 Year: 2025

Last Date Appraised: 12/13/2011 Appraiser: MATT LORD Retag: Y N Tag info:
 Owner: MEADOWOOD FARM LLC Roll Type: R
 Cycle Tag Sales Verification Other: clean up Inspection level: 1 2 3 4 LCB TTO INSP AV: 1478526
 RMV Land: 422210 RMV Imp: 1588990 RMV Total: 2011200 MAV: 1398530 MSAV: 121616 SAV: 283084
 Comment:

Notations update Inventory Input MLH 7/10/25

RP/MS	Code	Description
MS	ZONED	FARM EFU ZONED
RP	ZONED	FARM EFU ZONED

Farm Dairy

OSDs

Count	Code	Description	RMV	Code Area	Exception
6	SAA	SA OSD - AVERAGE	50000	05590	0

Land

Site: 1	Code Area: 05595	Size: 30.40 Acres	Use Code: 005	Zone: REST	SAV Use: 011	Exception: 0
Class: 2BISS	Value Source: Farm Use - EFU	Description: TWO BENCH IRR SOUTH SPECIAL	RMV: 104880	Exception: Y N		
Adjustment(s):	GSOIL, IRR, VWGR, GSOIL, IRR	Fire Patrol:	Description:			
Comments:	Liability year - 1980 / 550190: 02-03: REAPPRAISAL					
Site: 2	Code Area: 05595	Size: 4.60 Acres	Use Code: 005	Zone: REST	SAV Use: 011	Exception: 0
Class: 4BISS	Value Source: Farm Use - EFU	Description: FOUR BENCH IRR SPECIAL SOUTH	RMV: 14490	Exception: Y N		
Adjustment(s):	GSOIL, IRR, VWGR, GSOIL, IRR	Fire Patrol:	Description:			
Comments:	Liability year - 1980 / 550190					
Site: 4	Code Area: 05590	Size: 1.00 Acres	Use Code: 005	Zone: REST	SAV Use: 011	Exception: 0
Class:	Value Source: Farm Homesite	Description:	RMV: 38000	Exception: Y N		
Adjustment(s):	GSOIL, IRR, VWGR, GSOIL, IRR	Fire Patrol:	Description:			
Comments:	Liability year - 2009 / 550190					
Site: 6	Code Area: 05590	Size: 1.00 Acres	Use Code: 005	Zone: REST	SAV Use: 011	Exception: 0
Class: <u>6</u>	Value Source: Farm Homesite	Description:	RMV: 3000	Exception: Y N		
Adjustment(s):	GSOIL, IRR, VWGR, GSOIL, IRR	Fire Patrol:	Description:			
Comments:	Liability year - 2009 / 500190					
Site: 7	Code Area: 05590	Size: 26.80 Acres	Use Code: 005	Zone: REST	SAV Use: 011	Exception: 0
Class: 2BISS	Value Source: Farm Use - EFU	Description: TWO BENCH IRR SOUTH SPECIAL	RMV: 92460	Exception: Y N		
Adjustment(s):	GSOIL, IRR, VWGR, GSOIL, IRR	Fire Patrol:	Description:			
Comments:	Liability year - 1980 / 500190					
Site: 8	Code Area: 05590	Size: 5.20 Acres	Use Code: 005	Zone: REST	SAV Use: 011	Exception: 0
Class: 4BISS	Value Source: Farm Use - EFU	Description: FOUR BENCH IRR SPECIAL SOUTH	RMV: 16380	Exception: Y N		
Adjustment(s):	GSOIL, IRR, VWGR, GSOIL, IRR	Fire Patrol:	Description:			
Comments:	Liability year - 1980 / 500190					
Site: 10	Code Area: 05590	Size: 1.00 Acres	Use Code: 005	Zone: REST	SAV Use: 011	Exception: 0
Class: <u>10</u>	Value Source: Farm Homesite	Description:	RMV: 3000	Exception: Y N		
Adjustment(s):	GSOIL, IRR, VWGR, GSOIL, IRR	Fire Patrol:	Description:			
Comments:	Liability year - 2011 / 19-20: CORRECTED LIAB YEAR					

Improvements - Residence / Manufactured Structures

Bldg: 1	Code Area: 05595	Stat Class: 142	Year Blt: 1993	Eff Year Blt: 1993	Sq.Ft: 2774	% Complete: 100
Desc:	Multi Story above grade		Dimensions:	RMV: 435340		
Func Obsc: 100	Econ %: 100	Other %: 100	Exception: 0	Adjust:	Adjust RMV: 0	

Floors

Type	Class	Display Group	Floor Size	Beds	Baths	Yr Blt	Eff Yr Blt	Inventory	Exception
First Floor	4	Finished	1638	<u>0 1</u>	<u>0 1</u>	1993	1993	ROOF, KIT+, BATH - 1, HVAC+	Exception: Y N
Second Floor	4	Finished	1136	<u>0 3</u>	<u>0 2</u>	1993	1993	HVAC+, BATH - 2	Exception: Y N
Garage Attached	4	Finished	600	0	0	1993	1993	ROOF	Exception: Y N

I/O

Accessories

Description	Class	Size SqFt	Eff Yr Blt	RMV	Quantity	Exception
<u>PATIO</u> <u>part of YI</u>	4	2520	1998	12058	1	Exception: Y N
YARD IMPROVEMENTS AVERAGE	4	1	1993	27285	1	Exception: Y N

Bldg: 11 Code Area: 05595 Stat Class: 108 Year Blt: 1998 Eff Year Blt: 1998 Sq.Ft: 0 % Complete: 100

Desc: Residential Other Improvements Dimensions: RMV: 5790

Func Obsc: 100 Econ %: 100 Other %: 100 Exception: 0 Adjust: Adjust RMV: 0

Floors

Type	Class	Display Group	Floor Size	Beds	Baths	Yr Blt	Eff Yr Blt	Inventory
------	-------	---------------	------------	------	-------	--------	------------	-----------

No floor data available

move to Bldg 12

I/O

Accessories

Description	Class	Size SqFt	Eff Yr Blt	RMV	Quantity
CONCRETE DRIVEWAY	1	2048	1998	5791	1

Exception: Y N

Bldg: 14 Code Area: 05595 Stat Class: 108 Year Blt: 1998 Eff Year Blt: 1998 Sq.Ft: 0 % Complete: 100

Desc: Residential Other Improvements Dimensions: RMV: 6330

Func Obsc: 100 Econ %: 100 Other %: 100 Exception: 0 Adjust: Adjust RMV: 0

Floors

Type	Class	Display Group	Floor Size	Beds	Baths	Yr Blt	Eff Yr Blt	Inventory
------	-------	---------------	------------	------	-------	--------	------------	-----------

No floor data available

combine and change to bunker silo

Accessories

Description	Class	Size SqFt	Eff Yr Blt	RMV	Quantity
CONCRETE DRIVEWAY	1	2240 2520	1998	6334	1

Exception: Y N

Bldg: 16 Code Area: 05595 Stat Class: 108 Year Blt: Eff Year Blt: Sq.Ft: 0 % Complete: 100

Desc: Residential Other Improvements Dimensions: RMV: 0

Func Obsc: 100 Econ %: 100 Other %: 100 Exception: 0 Adjust: Adjust RMV: 0

Floors

Type	Class	Display Group	Floor Size	Beds	Baths	Yr Blt	Eff Yr Blt	Inventory
------	-------	---------------	------------	------	-------	--------	------------	-----------

No floor data available

Retaining wall

Accessories

Description	Class	Size SqFt	Eff Yr Blt	RMV	Quantity
No accessory data available					

Bldg: 17 Code Area: 05595 Stat Class: 141 + Year Blt: 2010 Eff Year Blt: 2010 Sq.Ft: 2235 % Complete: 100

Desc: One Story Only Dimensions: RMV: 440270

Func Obsc: 100 Econ %: 100 Other %: 100 Exception: 0 Adjust: Adjust RMV: 0

Floors

Type	Class	Display Group	Floor Size	Beds	Baths	Yr Blt	Eff Yr Blt	Inventory
------	-------	---------------	------------	------	-------	--------	------------	-----------

First Floor 4 + Finished 2235 03 2 2010 2010 FP - 1, HVAC, ROOF, BATH+, KIT+, BTH - 1, BATH - 2 Exception: Y N

Garage Attached 4 Finished 931 0 0 2010 2010 ROOF Exception: Y N

Accessories

Description	Class	Size SqFt	Eff Yr Blt	RMV	Quantity
No accessory data available					

VI 4 A

I/O

Improvements - Accessory Buildings

Bldg: 2 Code Area: 05595 Stat Class: 313 Year Blt: 1980 Eff Year Blt: 1980 Sq.Ft: 31152 % Complete: 100

Desc: Free Stall Barn (SB) Dimensions: 236x132 RMV: 91760

Func Obsc: 100 Econ %: 100 Other %: 100 Exception: 0 Adjust: Adjust RMV: 0

Floors

Type	Class	Display Group	Floor Size	Beds	Baths	Yr Blt	Eff Yr Blt	Inventory
------	-------	---------------	------------	------	-------	--------	------------	-----------

Free Stall Barn 5 Finished 31152 0 0 1980 1980 *Ave* Exception: Y N

I/O

Accessories

Description	Class	Size SqFt	Eff Yr Blt	RMV	Quantity
No accessory data available					

Bldg: 3 Code Area: 05595 Stat Class: 331 Year Blt: 1995 Eff Year Blt: 1995 Sq.Ft: 4500 % Complete: 100

Desc: Milking Parlor (MK) Dimensions: 150x30 RMV: 93130

Func Obsc: 100 Econ %: 100 Other %: 100 Exception: 0 Adjust: Adjust RMV: 0

Floors

Type	Class	Display Group	Floor Size	Beds	Baths	Yr Blt	Eff Yr Blt	Inventory
------	-------	---------------	------------	------	-------	--------	------------	-----------

Milking Parlor 5 Finished 4500 0 1 1995 1995 FAIR, BATH - 1 Exception: Y N

I/O

Accessories

Description	Class	Size SqFt	Eff Yr Blt	RMV	Quantity
No accessory data available					

Bldg: 4 Code Area: 05595 Stat Class: 351 Year Blt: 1995 Eff Year Blt: 1995 Sq.Ft: 2100 % Complete: 100
 Desc: General Purpose Building (GB) Dimensions: 70x30 RMV: 18000
 Func Obsc: 100 Econ %: 100 Other %: 100 Exception: 0 Adjust: Adjust RMV: 0

n/c

Floors

Type	Class	Display Group	Floor Size	Beds	Baths	Yr Blt	Eff Yr Blt	Inventory
General Purpose Bldg	5	Finished	2100	0	0	1995	1995	FAIR
Exception: Y N								

Accessories

Description	Class	Size SqFt	Eff Yr Blt	RMV	Quantity
No accessory data available					

Bldg: 5 Code Area: 05595 Stat Class: 351 Year Blt: 1995 Eff Year Blt: 1995 Sq.Ft: 5280 % Complete: 100
 Desc: General Purpose Building (GB) Dimensions: RMV: 42210
 Func Obsc: 100 Econ %: 100 Other %: 100 Exception: 0 Adjust: Adjust RMV: 0

n/c

Floors

Type	Class	Display Group	Floor Size	Beds	Baths	Yr Blt	Eff Yr Blt	Inventory
General Purpose Bldg	5	Finished	5280	0	0	1995	1995	FAIR
Exception: Y N								

Accessories

Description	Class	Size SqFt	Eff Yr Blt	RMV	Quantity
No accessory data available					

Bldg: 6 Code Area: 05595 Stat Class: 305 Year Blt: Eff Year Blt: Sq.Ft: 0 % Complete: 100
 Desc: Tank/Silo/Bin *Bulk feed tank* Dimensions: RMV: ~~6750~~ *5000*
 Func Obsc: 100 Econ %: 100 Other %: 100 Exception: 0 Adjust: Adjust RMV: 0

I/O

Floors

Type	Class	Display Group	Floor Size	Beds	Baths	Yr Blt	Eff Yr Blt	Inventory
No floor data available								

Accessories

Description	Class	Size SqFt	Eff Yr Blt	RMV	Quantity
No accessory data available					

Bldg: 7 Code Area: 05595 Stat Class: 301 Year Blt: Eff Year Blt: Sq.Ft: 100 % Complete: 100
 Desc: Accessory Improvements & Misc. Dimensions: 10x10 RMV: 0
 Func Obsc: 100 Econ %: 100 Other %: 100 Exception: 0 Adjust: Adjust RMV: 0

n/c

Floors

Type	Class	Display Group	Floor Size	Beds	Baths	Yr Blt	Eff Yr Blt	Inventory
Pump House	0	Finished	100	0	0	0	0	Finished
Exception: Y N								

Accessories

Description	Class	Size SqFt	Eff Yr Blt	RMV	Quantity
No accessory data available					

Bldg: 8 Code Area: 05595 Stat Class: 301 Year Blt: Eff Year Blt: Sq.Ft: 64 % Complete: 100
 Desc: Accessory Improvements & Misc. Dimensions: 8x8 RMV: 0
 Func Obsc: 100 Econ %: 100 Other %: 100 Exception: 0 Adjust: Adjust RMV: 0

n/c

Floors

Type	Class	Display Group	Floor Size	Beds	Baths	Yr Blt	Eff Yr Blt	Inventory
Pump House	0	Finished	64	0	0	0	0	Finished
Exception: Y N								

Accessories

Description	Class	Size SqFt	Eff Yr Blt	RMV	Quantity
No accessory data available					

Bldg: 9 Code Area: 05595 Stat Class: 380 Year Blt: Eff Year Blt: Sq.Ft: 0 % Complete: 100
 Desc: Farm M&E Dimensions: RMV: 80000
 Func Obsc: 100 Econ %: 100 Other %: 100 Exception: 0 Adjust: Adjust RMV: 0

Floors

Type	Class	Display Group	Floor Size	Beds	Baths	Yr Blt	Eff Yr Blt	Inventory
No floor data available								

Accessories

Description	Class	Size SqFt	Eff Yr Blt	RMV	Quantity
No accessory data available					

Bldg: 10 Code Area: 05595 Stat Class: 301 Year Blt: 1998 Eff Year Blt: 1998 Sq.Ft: 5680 % Complete: 100

Desc: Accessory Improvements & Misc.

Dimensions: 284x20 RMV: 23890

Func Obsc: 100 Econ %: 100 Other %: 100 Exception: 0 Adjust: Adjust RMV: 0

move to Bldg 2

move MAJ

Floors	Type	Class	Display Group	Floor Size	Beds	Baths	Yr Blt	Eff Yr Blt	Inventory	Exception
	Building Structure	0	Finished	5680	0	0	1998	1998		Y N

Accessories

Description	Class	Size SqFt	Eff Yr Blt	RMV	Quantity
No accessory data available					

Bldg: 12 Code Area: 05595 Stat Class: 313 Year Blt: 1998 Eff Year Blt: 1998 Sq.Ft: 26752 % Complete: 100

Desc: Free Stall Barn (SB)

Dimensions: 209x128 RMV: 189130

Func Obsc: 100 Econ %: 100 Other %: 100 Exception: 0 Adjust: Adjust RMV: 0

I/O

Floors	Type	Class	Display Group	Floor Size	Beds	Baths	Yr Blt	Eff Yr Blt	Inventory	Exception
	Free Stall Barn	5	Finished	26752	0	0	1998	1998	<i>Acc</i>	Y N

Accessories

Description	Class	Size SqFt	Eff Yr Blt	RMV	Quantity
No accessory data available					

Bldg: 13 Code Area: 05590 Stat Class: 353 Year Blt: 1998 Eff Year Blt: 1998 Sq.Ft: 4200 % Complete: 100

Desc: Machine Shed (MS)

Dimensions: 140x30 RMV: 24330

Func Obsc: 100 Econ %: 100 Other %: 100 Exception: 0 Adjust: Adjust RMV: 0

I/O

Floors	Type	Class	Display Group	Floor Size	Beds	Baths	Yr Blt	Eff Yr Blt	Inventory	Exception
	Machine Shed	5	Finished	4200	0	0	1998	1998	<i>Fair</i>	Y N

Accessories

Description	Class	Size SqFt	Eff Yr Blt	RMV	Quantity
No accessory data available					

Bldg: 15 Code Area: 05590 Stat Class: 351 Year Blt: 1998 Eff Year Blt: 1998 Sq.Ft: 900 % Complete: 100

Desc: General Purpose Building (GB)

Dimensions: 30x30 RMV: 9940

Func Obsc: 100 Econ %: 100 Other %: 100 Exception: 0 Adjust: Adjust RMV: 0

N/C

Floors	Type	Class	Display Group	Floor Size	Beds	Baths	Yr Blt	Eff Yr Blt	Inventory	Exception
	General Purpose Bldg	5	Finished	900	0	0	1998	1998	FAIR	Y N

Accessories

Description	Class	Size SqFt	Eff Yr Blt	RMV	Quantity
No accessory data available					

Bldg: 18 Code Area: 05590 Stat Class: 313 Year Blt: 2008 Eff Year Blt: 2008 Sq.Ft: 7200 % Complete: 100

Desc: Free Stall Barn (SB)

Dimensions: 120x60 RMV: 96100

Func Obsc: 100 Econ %: 100 Other %: 100 Exception: 0 Adjust: Adjust RMV: 0

N/C

Floors	Type	Class	Display Group	Floor Size	Beds	Baths	Yr Blt	Eff Yr Blt	Inventory	Exception
	Free Stall Barn	5	Finished	7200	0	0	2008	2008	FAIR	Y N

Accessories

Description	Class	Size SqFt	Eff Yr Blt	RMV	Quantity
No accessory data available					

Bldg: 19 Code Area: 05590 Stat Class: 353 Year Blt: 2002 Eff Year Blt: 2002 Sq.Ft: 3600 % Complete: 100

Desc: Machine Shed (MS)

Dimensions: 120x30 RMV: 15810

Func Obsc: 100 Econ %: 100 Other %: 100 Exception: 0 Adjust: Adjust RMV: 0

I/O

Floors	Type	Class	Display Group	Floor Size	Beds	Baths	Yr Blt	Eff Yr Blt	Inventory	Exception
	Machine Shed	4	Finished	3600	0	0	2002	2002	<i>Fair</i>	Y N

Accessories

Description	Class	Size SqFt	Eff Yr Blt	RMV	Quantity
No accessory data available					

Bldg: 20 Code Area: 05590 Stat Class: 355 Year Blt: 2009 Eff Year Blt: 2009 Sq.Ft: 1800 % Complete: 100

Desc: Lean-to Heavy (LTH)

Dimensions: RMV: 10210

Func Obsc: 100

Econ %: 100

Other %: 100

Exception: 0

Adjust:

Adjust RMV: 0

I/O

Floors

Type	Class	Display Group	Floor Size	Beds	Baths	Yr Blt	Eff Yr Blt	Inventory	Exception: Y N
Lean-to Heavy Duty	5	Finished	1800	0	0	2009	2009	FAIR	

Accessories

Description	Class	Size SqFt	Eff Yr Blt	RMV	Quantity
No accessory data available					

353 MS 5 ²⁵⁴⁴~~2578~~ cf 1999 Fair I/O

322 BS 44x170 1999 I/O
 | BS 50x160 1999 I/O
 | BS 40x50 1999 I/O

2
108

VI ^{2G} 7F 1990 V I S for Manuf I/O
 EP 2 99sf 1990


321 HL 4 26x20 1999 Ave I/O

SKETCH/AREA TABLE ADDENDUM

SUBJECT INFO

File No.: 535183 Parcel No.: 092W08 01100
 Property Address: 4900 COOK RD SE
 City: TURNER County: MARION State: OR ZipCode: 97392
 Owner:
 Client Address:
 Appraiser Name: Inspection Date:

SKETCH

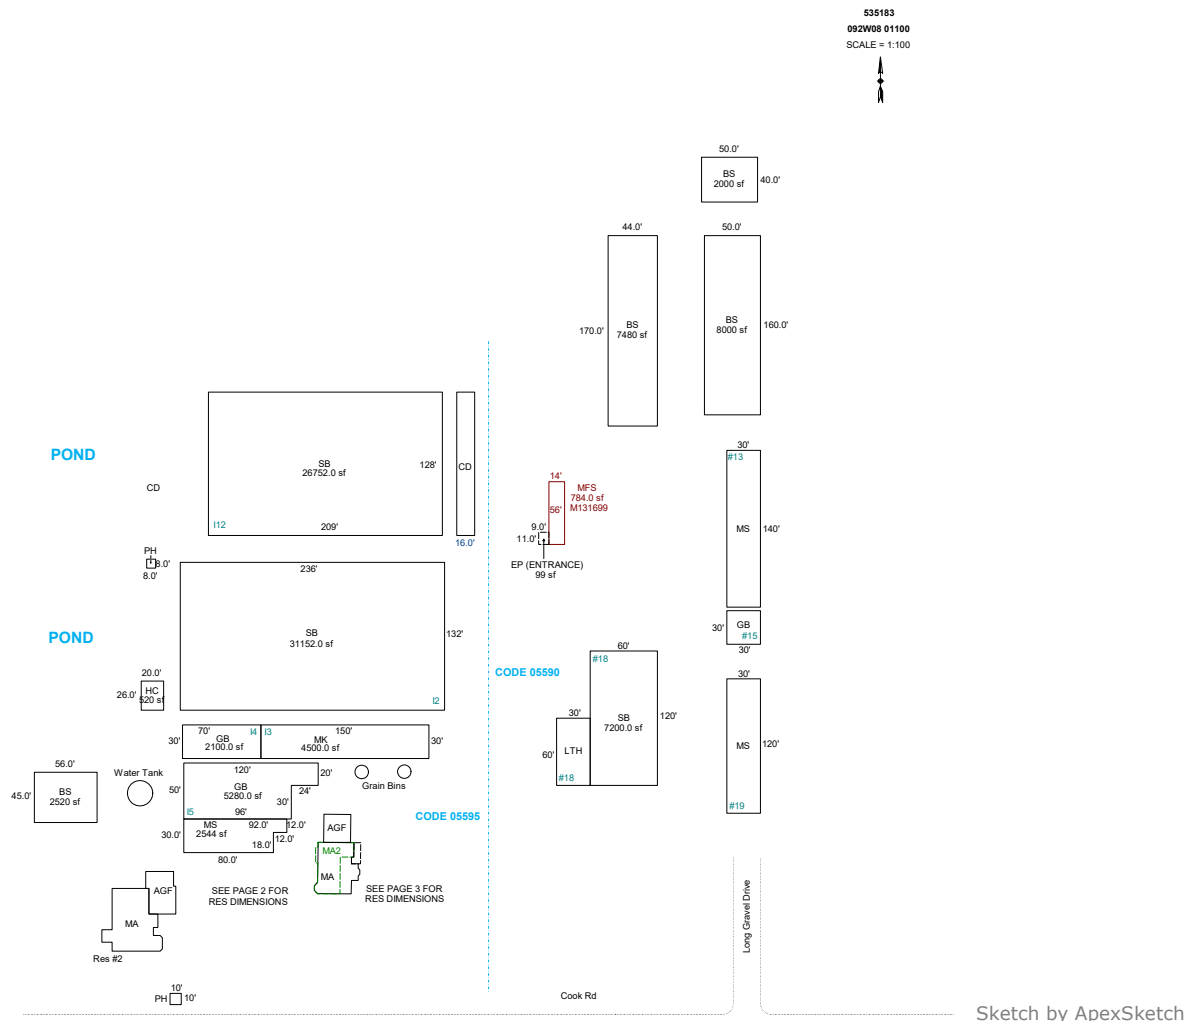

Sketch by ApexSketch

AREA CALCULATIONS SUMMARY

Code	Description	Factor	Net Size	Perimeter	Net Totals	
GBA1	BS	1.0	2000.0	180.0		
	MS	1.0	4200.0	340.0		
	LTH	1.0	1800.0	180.0		
	SB	1.0	7200.0	360.0		
	BS	1.0	7480.0	428.0		
	SB	1.0	26752.0	674.0		
	SB	1.0	31152.0	736.0		
	PH	1.0	64.0	32.0		
	HC	1.0	520.0	92.0		
	MK	1.0	4500.0	360.0		
	GB	1.0	2100.0	200.0		
	GB	1.0	5280.0	340.0		
	PH	1.0	100.0	40.0		
	BS	1.0	2520.0	202.0		
	MS	1.0	2544.0	244.0		
	BS	1.0	8000.0	420.0		
		9 addl items				
		Net LIVABLE	cnt	0 (rounded)		5,660
	Net BUILDING	cnt	18 (rounded)		110,712	

COMMENT TABLE 1

DRAWN BY SH 12-14-10
 UPDATED BY CJURAN 08/31/2023
 UPDATED BY CLOBERG 07/09/25

COMMENT TABLE 2

SC COMB. W/ 535182
 MLH 06/04/25

COMMENT TABLE 3

CLEAN UP L4

SKETCH/AREA TABLE ADDENDUM

SUBJECT INFO


File No.: 535183 Parcel No.: 092W08 01100
 Property Address: 4900 COOK RD SE
 City: TURNER County: MARION State: OR ZipCode: 97392
 Owner:
 Client: Client Address:
 Appraiser Name: Inspection Date:

SKETCH

535183
092W08 01100
 SCALE = 1:20



SEE PAGE 1 FOR
ALL BLDGS

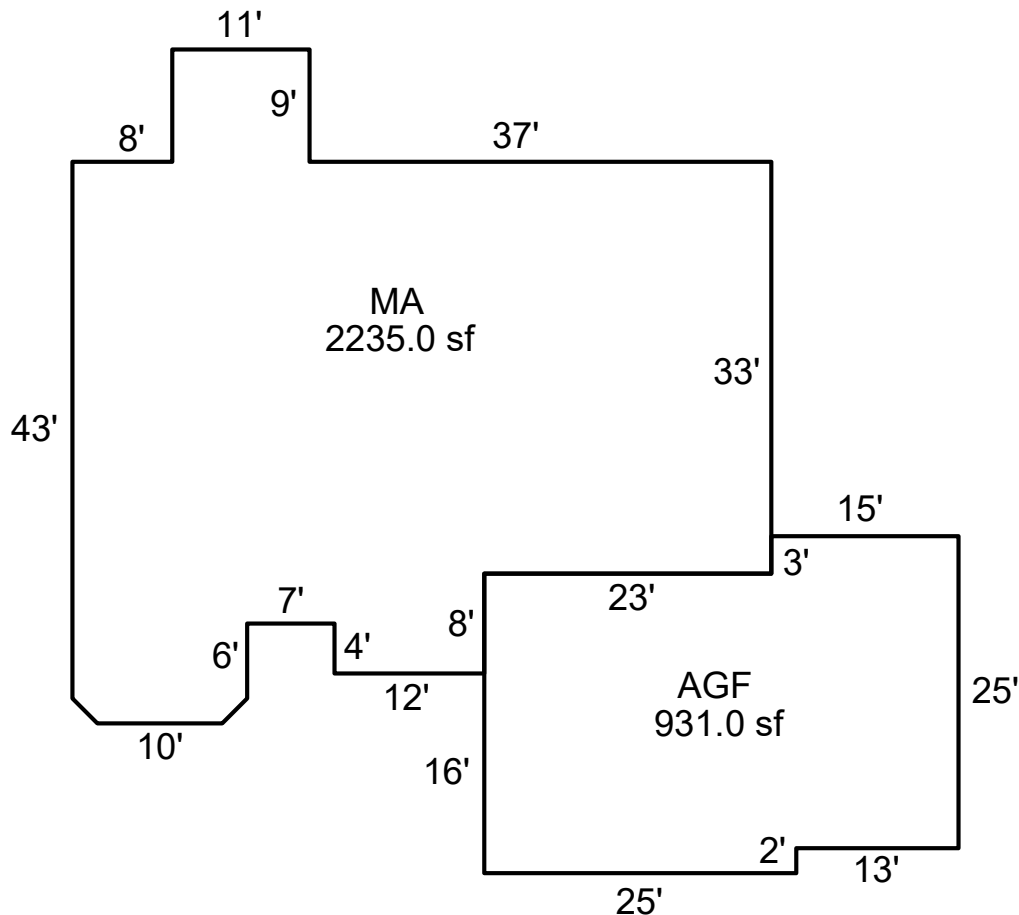

Sketch by ApexSketch

AREA CALCULATIONS SUMMARY

Code	Description	Factor	Net Size	Perimeter	Net Totals
GLA1	MA	1.0	2235.0	225.7	2235.0
	Net LIVABLE	cnt	0 (rounded)		2,235

COMMENT TABLE 1

DRAWN BY SH 12-14-10
 UPDATED BY CJURAN 08/31/2023
 UPDATED BY CLOBERG 07/09/25

COMMENT TABLE 2

SC COMB. W/ 535182
 MLH 06/04/25

COMMENT TABLE 3


CLEAN UP L4

SKETCH/AREA TABLE ADDENDUM

SUBJECT INFO

File No.: 535183 Parcel No.: 092W08 01100
 Property Address: 4900 COOK RD SE
 City: TURNER County: MARION State: OR ZipCode: 97392
 Owner:
 Client: Client Address:
 Appraiser Name: Inspection Date:

SKETCH

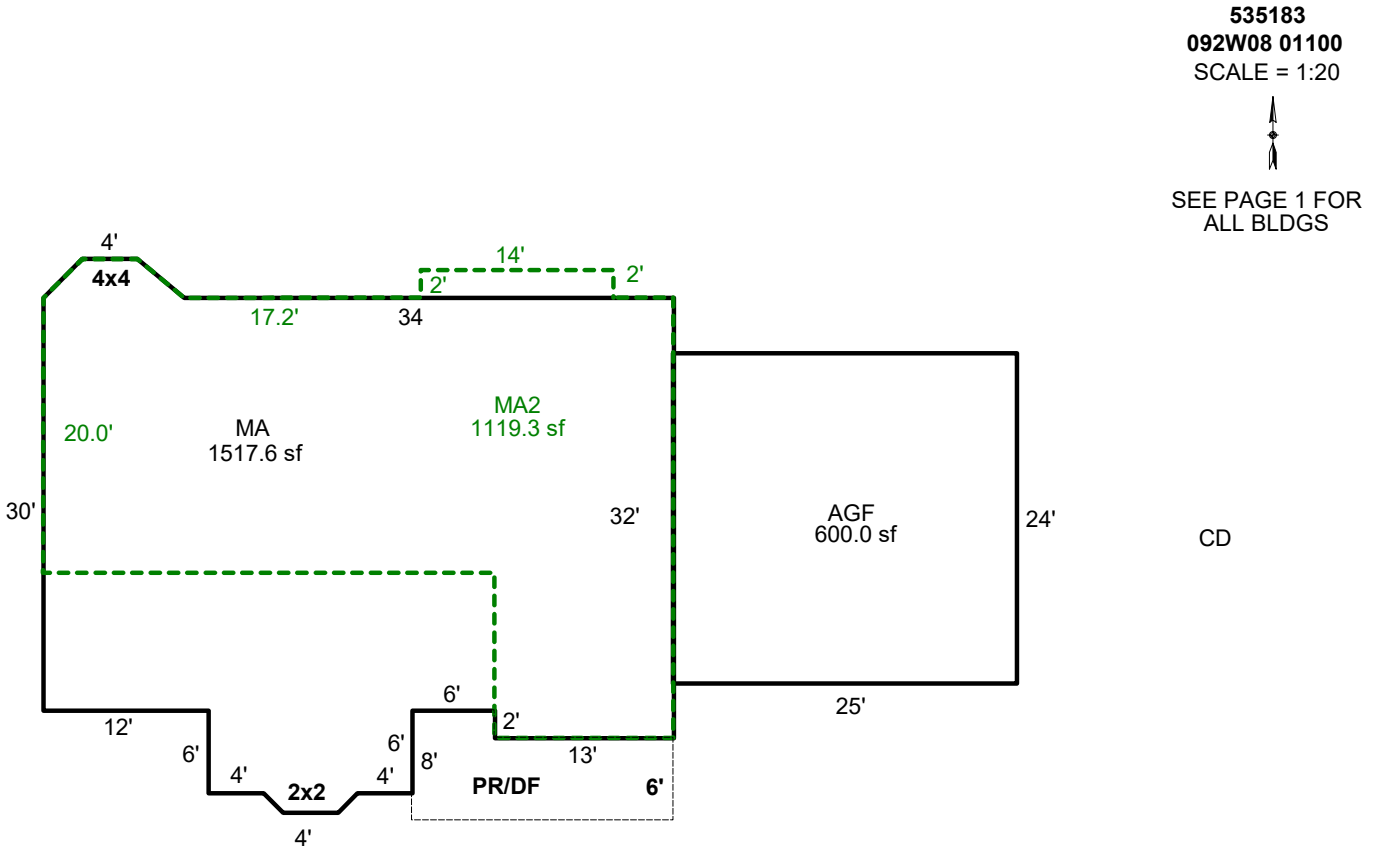

AREA CALCULATIONS SUMMARY

Code	Description	Factor	Net Size	Perimeter	Net Totals
GLA1	MA	1.0	1517.6	171.0	1517.6
GLA2	MA2	1.0	1119.3	161.7	1119.3
GAR	AGF	1.0	600.0	98.0	600.0
P/P	PR/DF	1.0	126.0	54.0	126.0

COMMENT TABLE 1

DRAWN BY SH 12-14-10
 UPDATED BY CJURAN 08/31/2023
 UPDATED BY CLOBERG 07/09/25

COMMENT TABLE 2

SC COMB. W/ 535182
 MLH 06/04/25

COMMENT TABLE 3

CLEAN UP L4

Net LIVABLE cnt 0 (rounded) 2,637

SKETCH/AREA TABLE ADDENDUM

SUBJECT INFO


File No.: 535183 Parcel No.: 092W08 01100
 Property Address: 4900 COOK RD SE
 City: TURNER County: MARION State: OR ZipCode: 97392
 Owner:
 Client: Client Address:
 Appraiser Name: Inspection Date:

SKETCH

535183
092W08 01100
 SCALE = 1:20



SEE PAGE 1 FOR
ALL BLDGS

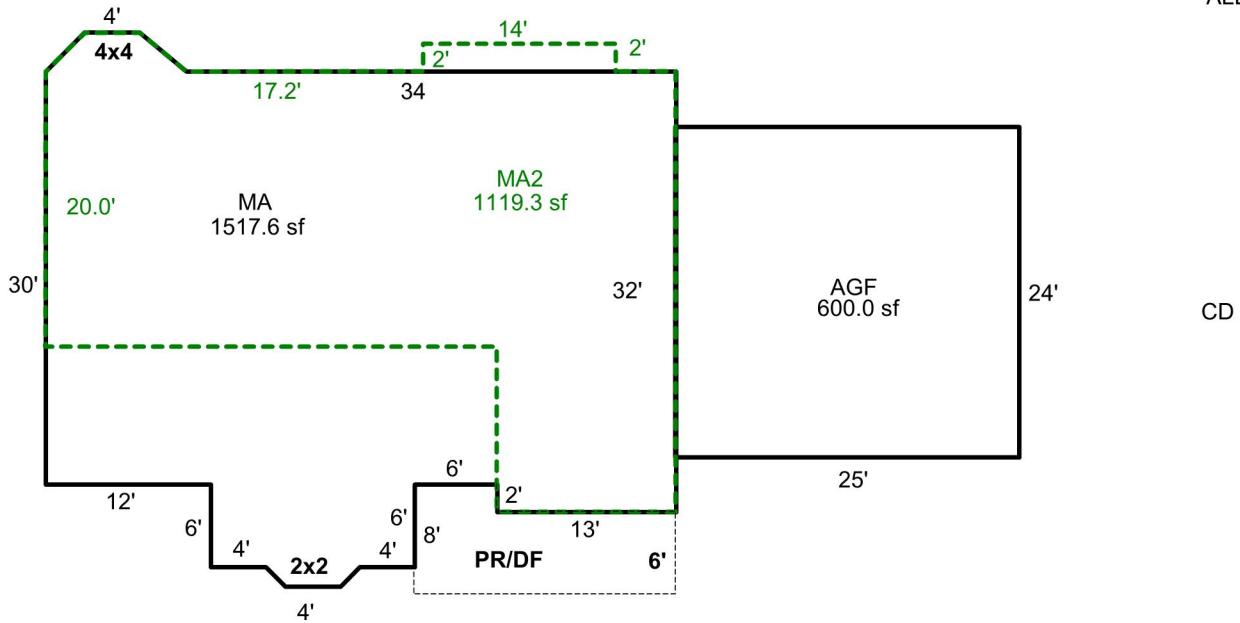

Sketch by Apex Sketch

AREA CALCULATIONS SUMMARY

Code	Description	Factor	Net Size	Perimeter	Net Totals
GLA1	MA	1.0	1517.6	171.0	1517.6
GLA2	MA2	1.0	1119.3	161.7	1119.3
GAR	AGF	1.0	600.0	98.0	600.0
P/P	PR/DF	1.0	126.0	54.0	126.0

COMMENT TABLE 1

DRAWN BY SH 12-14-10
 UPDATED BY CJURAN 08/31/2023










COMMENT TABLE 2

SC COMB. W/ 535182

COMMENT TABLE 3

Net LIVABLE cnt 2 (rounded) 2,637


R35182
092W08 01100

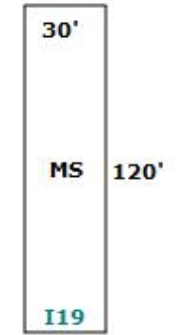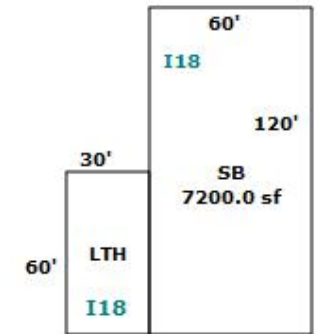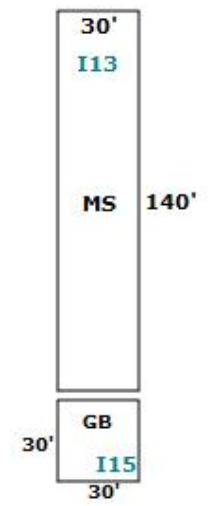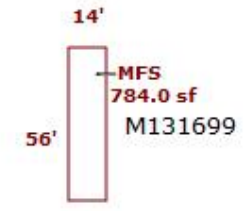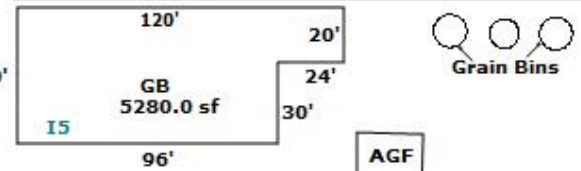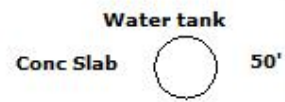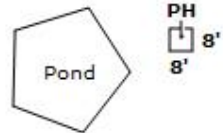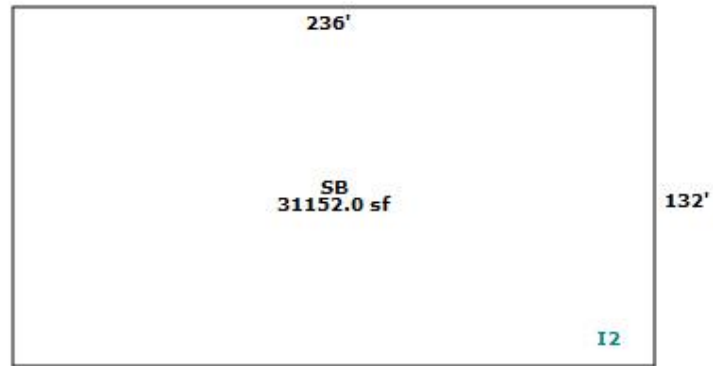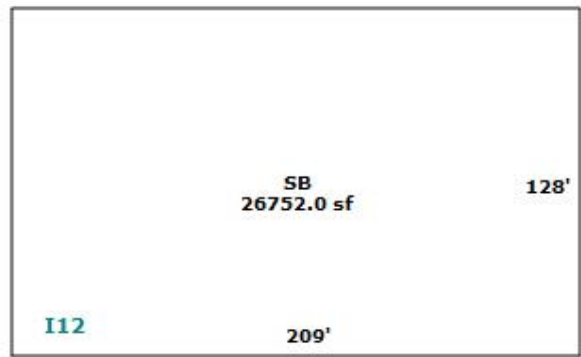

Cook Rd

Long Gravel Drive

R35182
092W08 01100
See Page 1 for all structures
Page 2 of 3

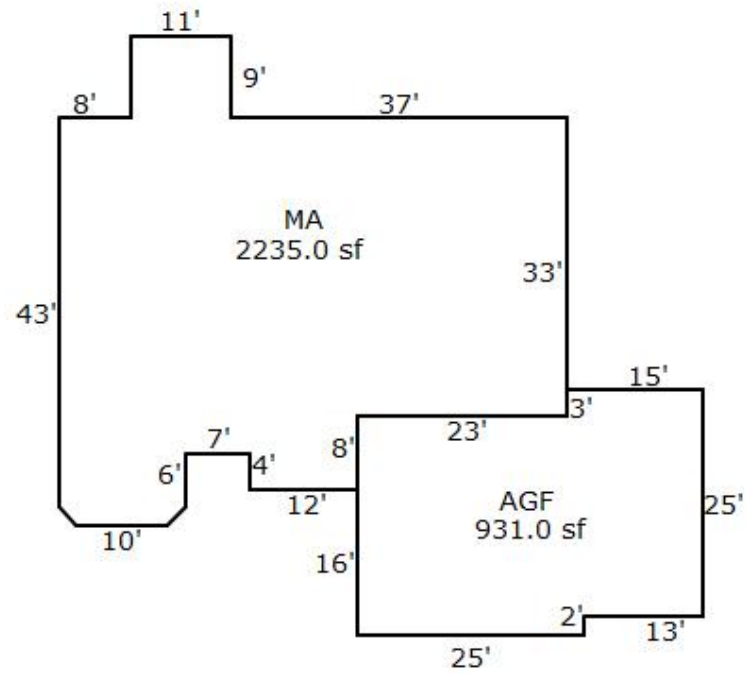

Res #1

