

Acct ID: 538000 MTL: 061E32B000800 Date: **7/31/25** Appr: **MLH** Prop Class: 451 RMV Prop Class: 451  
 Situs: 5953 DAVIS CREEK RD NE SILVERTON OR 97381 MaSaNh: 03 06 000 Unit: 31482 Year: 2025

Last Date Appraised: 09/18/2013 Appraiser: MATTHEW HAMILTON Retag: Y N Tag info:  
 Owner: SORRELS, DUSTIN R Roll Type: R  
 Cycle Tag Sales Verification Other: **Jet disqual** Inspection level: 1 2 3 4 **LCB** **TTC** INSP AV: 220200  
 RMV Land: 296420 RMV Imp: 180430 RMV Total: 476850 MAV: 220200 MSAV: 0 SAV: 0

Comment: **Dustin.Sorrels1@gmail.com send Farm use info**

Notations **update Inventory** **Input MLH 7/31/25**  
 No notation data available.

**OSDs**

| Count | Code | Description   | RMV   | Code Area | Exception |
|-------|------|---------------|-------|-----------|-----------|
| 1     | MKTA | OSD - AVERAGE | 50000 | 04500     | 0         |

**Land**

Site: 1 Code Area: 04500 Size: 1.80 Acres Use Code: 005 Zone: REST SAV Use: Exception: 0  
 Class: Value Source: Rural Restrictive Description: RMV: 246420 Exception: Y N  
 Adjustment(s): Fire Patrol: Description:  
 Comments: 08-09: LAND SEG CONSOLIDATION// 06-07: RECALC SETUP;#19 06-29-05

**Improvements - Residence / Manufactured Structures**

**EYB Roof, paint, counter 1985**

Bldg: 1 Code Area: 04500 Stat Class: 131 Year Blt: 1972 Eff Year Blt: **1972** Sq.Ft: 1590 % Complete: 100  
 Desc: One Story Only Dimensions: RMV: 170100  
 Func Obsc: 100 Econ %: 100 Other %: 100 Exception: 0 Adjust: Adjust RMV: 0

**Floors**

| Type        | Class | Display Group | Floor Size | Beds | Baths         | Yr Blt | Eff Yr Blt | Inventory   | Exception |
|-------------|-------|---------------|------------|------|---------------|--------|------------|---|-----------|
| First Floor | 3     | Finished      | 1590       | 3    | FB-1/<br>HB-1 | 1972   | 1972       | FP - <b>+</b> , HVAC, ROOF, KIT+, BTH - 1, BATH - 1 | Y N       |

**Accessories**

| Description            | Class | Size SqFt | Eff Yr Blt | RMV  | Quantity | Exception |
|------------------------|-------|-----------|------------|------|----------|-----------|
| YARD IMPROVEMENTS FAIR | 3     | 1         | 1972       | 7918 | 1        | Y N       |

**Improvements - Accessory Buildings**

**1999**

Bldg: 2 Code Area: 04500 Stat Class: 353 Year Blt: 1993 Eff Year Blt: **1993** Sq.Ft: 360 % Complete: 100  
 Desc: Machine Shed (MS) Dimensions: 24x15 RMV: 1590  
 Func Obsc: 100 Econ %: 100 Other %: 100 Exception: 0 Adjust: Adjust RMV: 0

**Floors**

| Type         | Class | Display Group | Floor Size | Beds | Baths | Yr Blt | Eff Yr Blt | Inventory | Exception |
|--------------|-------|---------------|------------|------|-------|--------|------------|-----------|-----------|
| Machine Shed | 4     | Finished      | 360        | 0    | 0     | 1993   | 1993       | <b>MS</b> | Y N       |

**Accessories**

| Description                 | Class | Size SqFt | Eff Yr Blt | RMV | Quantity | Exception |
|-----------------------------|-------|-----------|------------|-----|----------|-----------|
| No accessory data available |       |           |            |     |          |           |

Bldg: 3 Code Area: 04500 Stat Class: 341 Year Blt: 1991 Eff Year Blt: **2009** Sq.Ft: 360 % Complete: 100  
 Desc: **Multi Purpose Shed (MP) - GB** Dimensions: 20x18 RMV: 2480  
 Func Obsc: 100 Econ %: 100 Other %: 100 Exception: 0 Adjust: Adjust RMV: 0

**Floors**

| Type               | Class      | Display Group | Floor Size | Beds | Baths | Yr Blt | Eff Yr Blt | Inventory        | Exception |
|--------------------|------------|---------------|------------|------|-------|--------|------------|------------------|-----------|
| Multi-Purpose Bldg | <b>5.4</b> | Finished      | 360        | 0    | 0     | 1991   | 1991       | FAIR <b>Good</b> | Y N       |

**Accessories**

| Description                 | Class | Size SqFt | Eff Yr Blt | RMV | Quantity | Exception |
|-----------------------------|-------|-----------|------------|-----|----------|-----------|
| No accessory data available |       |           |            |     |          |           |

Bldg: 4 Code Area: 04500 Stat Class: 351 Year Blt: 1991 Eff Year Blt: **2009** Sq.Ft: 800 % Complete: 100  
 Desc: General Purpose Building (GB) Dimensions: 40x20 RMV: 6260  
 Func Obsc: 100 Econ %: 100 Other %: 100 Exception: 0 Adjust: Adjust RMV: 0

**Floors**

| Type                 | Class | Display Group | Floor Size | Beds | Baths | Yr Blt | Eff Yr Blt | Inventory       | Exception: Y N |
|----------------------|-------|---------------|------------|------|-------|--------|------------|-----------------|----------------|
| General Purpose Bldg | 5     | Finished      | 800        | 0    | 0     | 1991   | 1991       | FAIR <i>AJL</i> |                |

**Accessories**

| Description                 | Class | Size SqFt | Eff Yr Blt | RMV | Quantity |
|-----------------------------|-------|-----------|------------|-----|----------|
| No accessory data available |       |           |            |     |          |

*355 LTH 12 x 10 1999*




# SKETCH/AREA TABLE ADDENDUM

## SUBJECT INFO

File No.: 538000 Parcel No.: 061E32B 00800  
 Property Address: 5953 DAVIS CREEK RD NE  
 City: SILVERTON County: MARION State: OR ZipCode: 97381  
 Owner:  
 Client Address:  
 Appraiser Name: Inspection Date:

## SKETCH

538000  
 061E32B 00800  
 SCALE=1:30

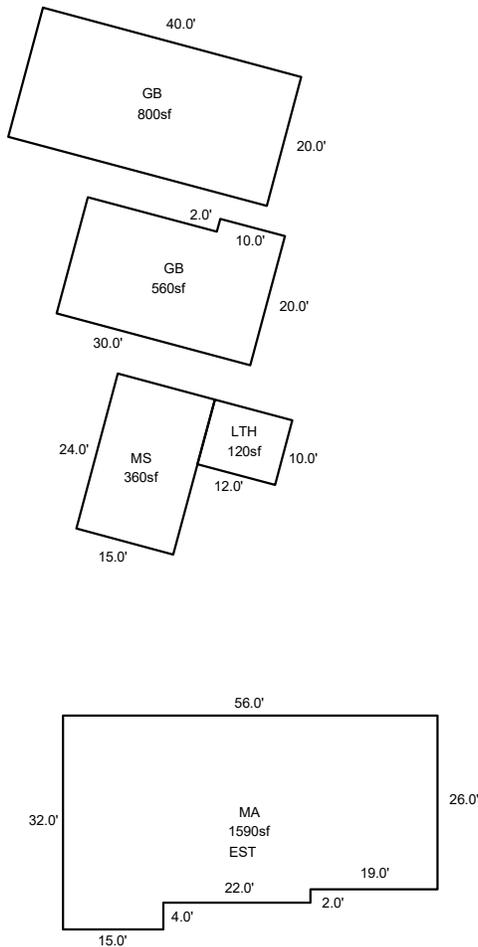

Sketch by ApexSketch

### AREA CALCULATIONS SUMMARY

| Code | Description  | Factor | Net Size    | Perimeter | Net Totals |
|------|--------------|--------|-------------|-----------|------------|
| GBA1 | MS           | 1.0    | 360.0       | 78.0      |            |
|      | GB           | 1.0    | 560.0       | 100.0     |            |
|      | GB           | 1.0    | 800.0       | 120.0     |            |
|      | LTH          | 1.0    | 120.0       | 44.0      | 1840.0     |
| GLA1 | MA           | 1.0    | 1590.0      | 176.0     | 1590.0     |
|      | Net LIVABLE  | cnt    | 0 (rounded) |           | 1,590      |
|      | Net BUILDING | cnt    | 4 (rounded) |           | 1,840      |

### COMMENT TABLE 1

DRAWN BY JRONDEMA 7/17/18  
 UPDATED BY CLOBERG 09/22/25



### COMMENT TABLE 2

MLH 07/31/25

### COMMENT TABLE 3

VET DQ L3

R38000  
061E32B 00800  
SCALE=1:30

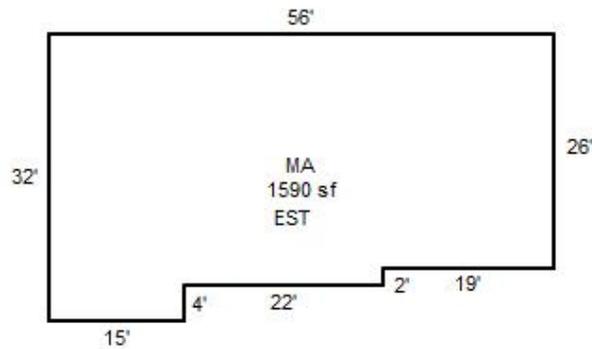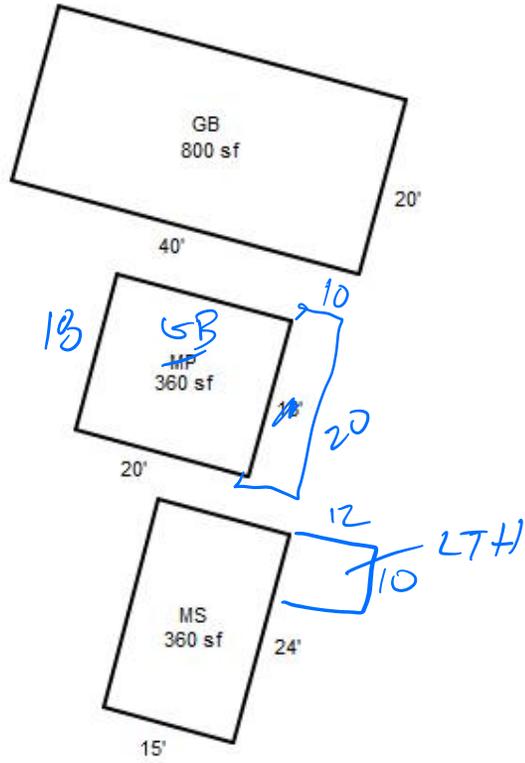

7/31/25 MLH Jet DQ  
L3