

Apex

Summary

Lead Appr: corr 10.13.25 lak

Clerk:

Lead Clerk:

Appr: SA 6/4/25

Print Date: 4/9/2025

Acct ID: 127096

MTL: 063W26AC05700P1

Date: 5/21/25

Appr: SA

Prop Class: 019

RMV Prop Class: 019

Situs: 929 OAKWOOD ST NE KEIZER, OR 97303

MaSaNh: 13 05 000

Unit: 140916

Year: 2025

Last Date Appraised: 05/26/2023

Appraiser: THERESA SWEARINGEN

Retag: Y N

Tag info:

Owner: FLORES GARCIA, FRANCISCO MARCOS

Roll Type: MS

Cycle

Tag

Sales Verification

Other:

Inspection level: 1 2 3 4

LCB

TTO

INSP

AV: 28160

RMV Land: 0

RMV Imp: 64850

RMV Total: 64850

MAV: 28160

MSAV: 0

SAV: 0

Comment: 23-24: L2 05.26.23 TS

update inventory

Notations

No notation data available.

OSDs

No OSD data available.

Land

No land data available.

Improvements - Residence / Manufactured Structures

Bldg: 1

Code Area: 24200

Stat Class: 456

Year Blt: 1975

Eff Year Blt: 1997

Sq.Ft: 1248

% Complete: 100

Desc: MANUF STRUCT, CLASS 5, 24' WIDE DOUBLE

Dimensions: 52x24

RMV: 64850

Func Obsc: 100

Econ %: 100

Other %: 100

Exception: 0

Adjust:

Adjust RMV: 0

Floors


Type	Class	Display Group	Floor Size	Beds	Baths	Yr Blt	Eff Yr Blt	Inventory
First Floor	5	Finished	1248	2	FB-2	1975	1997	SKIRT, ROOF+, HVAC, KIT, BATH - 2

Accessories

Description	Class	Size SqFt	Eff Yr Blt	RMV	Quantity
DECK	5	70	1997	739	0
ROOF EXTENSION OR PATIO COVER	5	428	1997	5958	0

Improvements - Accessory Buildings

No improvement data available for all other stat class types.

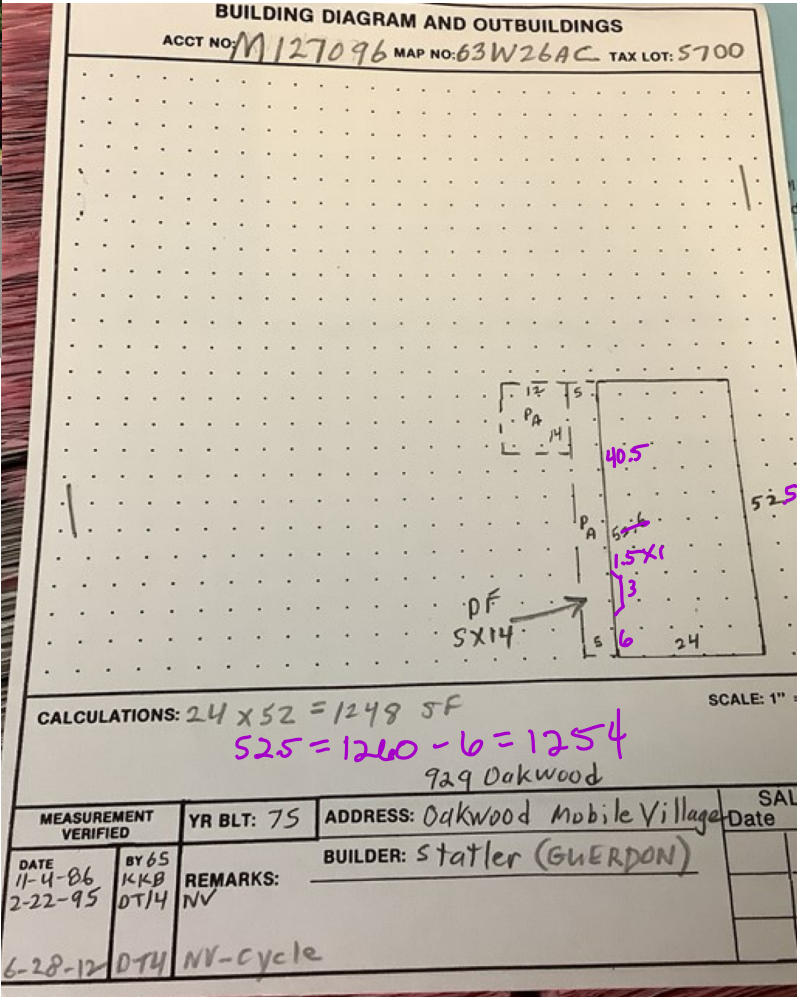

vinyl win + siding
good paint
clean