

Summary

Lead Appr: WW 10/21

Clerk:

Lead Clerk:

Appr:

Print Date: 9/26/2025

Acct ID: 345373

MTL: 081W33B004900

Date: 10-7-25

Appr: Gue

Prop Class: 401

RMV Prop Class: 401

Situs: 8196 RAUSCHER LN SE AUMSVILLE OR 97325

MaSaNh: 01 06 008

Unit: 86047

Year: 2025

Last Date Appraised: 12/03/2024

Appraiser: CLINT LUKE

Tag: Y

Tag info: 2026 - Tags/Permit (TAGS/PERMIT)

Owner: CHURCH LT

Last Sales Date: 03/13/2017

Roll Type: R

Cycle Tag

Sales Verification

Other:

Inspection level: 1 2 3

LCB

TTO

INSP

AV: 495700

RMV Land: 328580

RMV Imp: 812670

RMV Total: 1141250

MAV: 458310

MSAV: 0

SAV: 0

Comment: 25-26 L2 12/3/24 CLUKE

OSDs

make noted changes per

Count	Code	Description	RMV	Code Area	Exception
1	MKTA	OSD - AVERAGE	50000	29588	0

Land

Site: 1

Code Area: 29588

Size: 2.08 Acres

Use Code: 004

Zone: NREST

SAV Use:

Exception: 0

Class: 2BDSS

Value Source: Rural at MKT

Description: TWO BENCH DRY SOUTH SPECIAL

RMV: 278580

Exception: Y N

Adjustment(s): GSOIL

Fire Patrol:

Description:

Comments: 20-21: PER #10 UPGRADE OSD / 19-20: PER #10 ADD OSD / 2960180// 09-10: NEW SUBDIVISION

Improvements - Residence / Manufactured Structures

Bldg: 1

Code Area: 29588

Stat Class: 142 +

Year Blt: 2018

Eff Year Blt: 2018

Sq.Ft: 3592

% Complete: 100.00

Desc: Multi Story above grade

Dimensions:

RMV: 734310

Func Obsc: 100

Econ %: 100

Other %: 100

Exception: 0

Adjust:

Adjust RMV: 0

Floors

Type	Class	Display Group	Floor Size	Beds	Baths	Yr Blt	Eff Yr Blt	Inventory	Exception: Y N
First Floor	4 +	Finished	1986	1	FB-1/ HB-1	2018	2018	KIT, HVAC, BTH - 1, BATH - 1, FP - 2, ROOF	Y N
Second Floor	4 +	Finished	864	3	FB-1	2018	2018	HVAC, BATH - 1	Y N
Attic	4 +	Finished	742	0	0	2018	2018	HVAC	Y N
Garage Attached	4	Finished	1144	0	0	2018	2018	ROOF	Y N

Accessories

Description	Class	Size SqFt	Eff Yr Blt	RMV	Quantity	Exception: Y N
YARD IMPROVEMENTS AVERAGE	4	0	2018	31137	1	Y N

Improvements - Accessory Buildings

Bldg: 2

Code Area: 29588

Stat Class: 351

Year Blt: 2024

Eff Year Blt: 2024

Sq.Ft: 3360

% Complete: 100.00

Desc: General Purpose Building (GB)

Dimensions: 84x40

RMV: 75120

Func Obsc: 100

Econ %: 100

Other %: 100

Exception: 35840

Adjust:

Adjust RMV: 0

Floors

Type	Class	Display Group	Floor Size	Beds	Baths	Yr Blt	Eff Yr Blt	Inventory	Exception: Y N
General Purpose Bldg	5	Finished	3360	0	0	2024	2024	AVC	Y N

Accessories

Description	Class	Size SqFt	Eff Yr Blt	RMV	Quantity
No accessory data available					

Bldg: 3

Code Area: 29588

Stat Class: 355

Year Blt: 2024

Eff Year Blt: 2024

Sq.Ft: 480

% Complete: 100.00

Desc: Lean-to Heavy (LTH)

Dimensions: 48x10

RMV: 3240

Func Obsc: 100

Econ %: 100

Other %: 100

Exception: 1550

Adjust:

Adjust RMV: 0

Floors

Type	Class	Display Group	Floor Size	Beds	Baths	Yr Blt	Eff Yr Blt	Inventory	Exception: Y N
Lean-to Heavy Duty	4	Finished	480	0	0	2024	2024		Y N

Accessories

Description	Class	Size SqFt	Eff Yr Blt	RMV	Quantity
No accessory data available					

Permits

Permit Number	Permit ID	Origin	Category	Type	Estimate Value	% Complete	Roll Type	Description
25-000710	83673	MARION COUNTY	TAGS/PERMITS	REPAIR/REMODEL	26827	0	R	Permitting and finishing 2 Storage Rms inside Shop structure


FINISHED 5-9-25

SKETCH/AREA TABLE ADDENDUM

SUBJECT INFO

File No.: 345373 Parcel No.: 081W33B004900
 Property Address: 8196 RAUSCHER LANE SE
 City: AUMSVILLE County: MARION State: OR ZipCode: 97325
 Owner:
 Client: Client Address:
 Appraiser Name: Inspection Date:

SKETCH

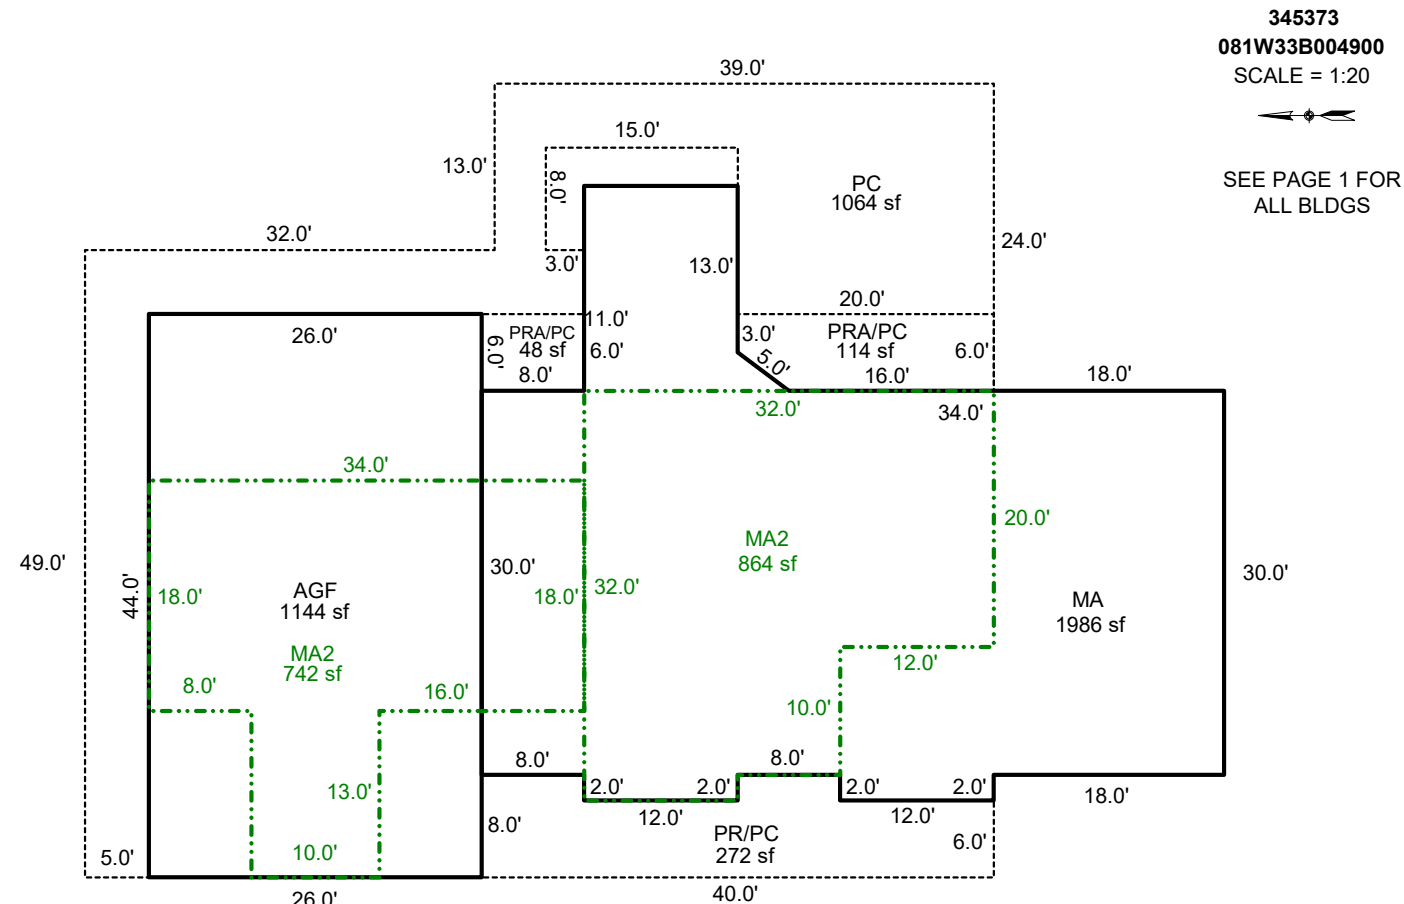

AREA CALCULATIONS SUMMARY

Code	Description	Factor	Net Size	Perimeter	Net Totals
GLA1	MA	1.0	1986.0	214.0	1986.0
GLA2	MA2	1.0	742.0	130.0	
	MA2	1.0	864.0	128.0	1606.0
GAR	AGF	1.0	1144.0	140.0	1144.0
P/P	PC	1.0	1064.0	320.0	
	PRA/PC	1.0	48.0	28.0	
	PRA/PC	1.0	114.0	50.0	
	PR/PC	1.0	272.0	100.0	1498.0

COMMENT TABLE 1

DRAWN BY JRONDEMA 9/20/18
 UPDATED BY JRONDEMA 1/31/19
 UPD BY PH 05.06.20
 UPDATED BY CJURAN 04/10/2024 24-000889 GB
 UPDATED BY WILLIAMS 12/19/24
 UPDATED BY CLOBERG 04/07/25 25-000710 GB ADDN

COMMENT TABLE 2

01.24.19 CL #10
 10.16.19 CL #10
 12.3.24 CL

COMMENT TABLE 3

TAGS
 TAGS
 TAGS L2

Net LIVABLE cnt 0 (rounded) 3,592