

Rural Work Order Cover Sheet

RAM Transaction #: 794602

Year: 25 - 26

Account Numbers Involved: 541057

Sequence #1: ACREAGE CORRECTION BASED ON DEAD – 0.42

Sequence #2:

Sequence #3:

Sequence #4:

Sequence #5:

		Check For:				Forms Included:	
	Yes	No		Yes	No		✓
Move Building Permits	☐	☒	Fire Patrol (Email Supervisor)	☒	☐	RAM Report	☒
Move Photos	☐	☒	Multi-Section	☐	☒	Processing Forms	☒
Update Apex	☐	☒	Tagged for 2 nd year Reset	☐	☒	Before and After Maps	☒
Update Account Notes	☐	☐	Exemptions	☐	☒	Multi-Section Processing Form	☐
PAT LIAB	☐	☒	Update Tracker	☐	☐	Calculation Form(s)	☐

Miscellaneous Notes: COMPLETE ROLL CORRECTION FOR MAV ADJUSTMENT PRIOR TO WORKORDER

Appraiser: WWILLIAMS

Date: 2.25.25

Appraisal Review:

Date:

Data Entry:

Chin

Date:

2/27/25

Rural Work Order Processing Form

One Page Per Account

Sequence #: 1 of 1 Account Number: 541507 MTL: 092E18AD00700 RAM Transaction ID: 794602

Type: ☐ COM ☐ LLA ☐ PPT ☐ SEG ☐ SUB ☒ AC ☐ R of W ☐ Vacate ☐ Map Maintenance

Account Details

Ma Sa Nh: 01 06 007 Prop Class: 017 RMV Class: 401

Assigned Appraiser: CLUKE Part of Unit: Yes ☐ or No ☒ Fire Patrol: Yes ☒ or No ☐

Land Fragment

Account From	Code Area	Liab Yr	Land Class	LUC	Value Source	# of Acres	Zone	Land Adjustments
541057	29544		4BDSS	004	RURAL @ MARKET	0.81	NREST	H20AR
541057	29544				OSDA			

Total Acres: 0.81

Improvements

Account From	Code Area	Imp ID	Stat Class	Description	Account From	Code Area	Imp ID	Stat Class	Description
541057	295444	1	142	RESIDENCE					
541057	295444	2	RBH	RESIDENCE					

Adjustments: _____

Exception


New MAV: 112,700 ☐ Sys Calc ☒ No Change to MAV

Size ID	Tax Year	Account ID	MTL	Voucher ID	Voucher Sequence	Recorded Date	Transaction Comment	Voucher Notes	Code	+/- Size	Size Type
691979	2025	541057	092E18AD00700	890725	1	2/24/2025 0:00	SIZE CHANGE - CGV	ACREAGE CORRECTION BASED IN DEED. REEL 4401 PAGE 14	29544	-0.42	A

09 2E 18AD

09 2E 18AD

B4

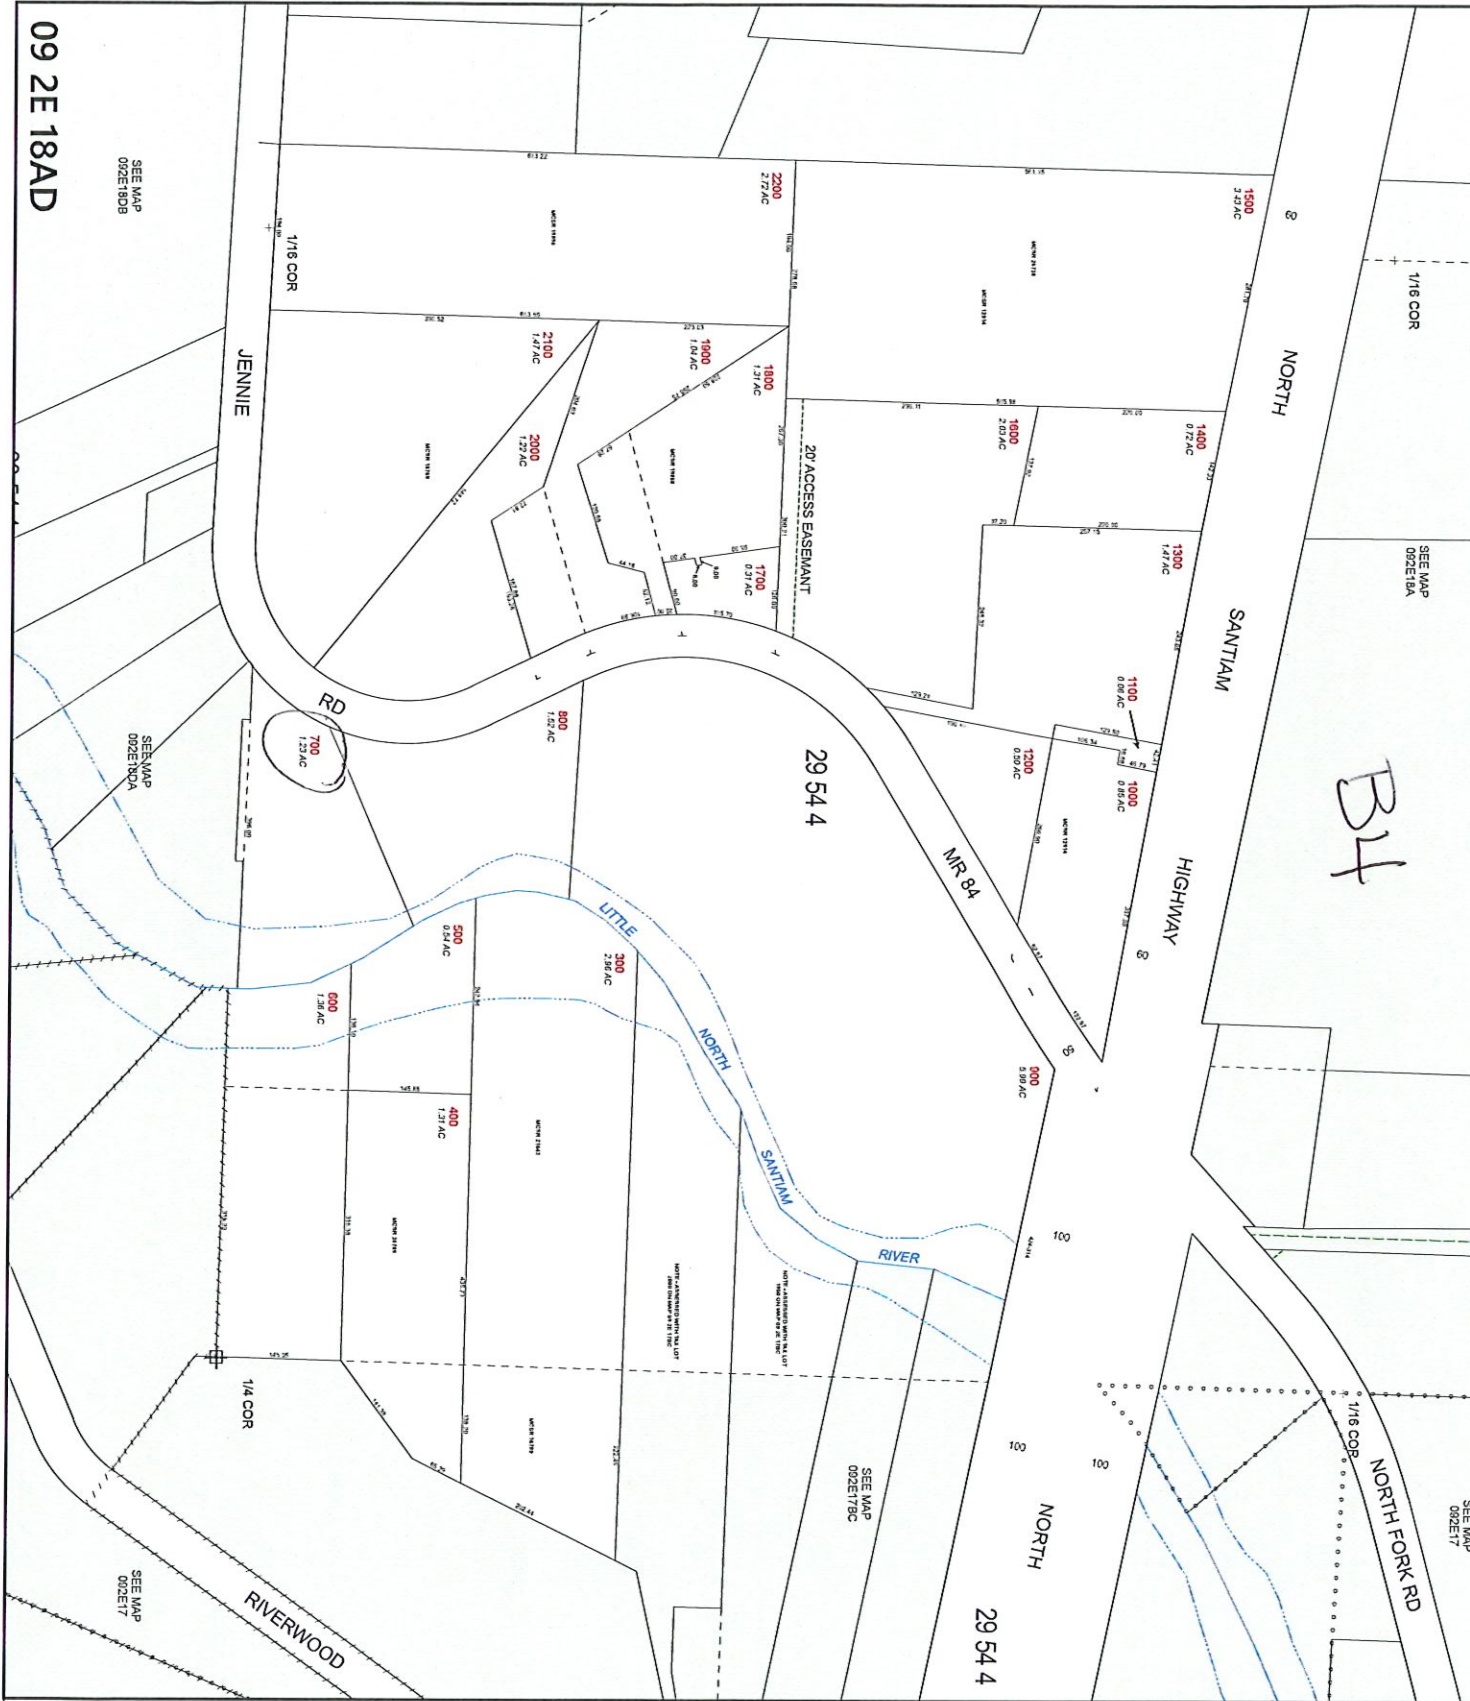

MARION COUNTY, OREGON
SE 1/4 NE 1/4 SEC 18 T9S R2E W.M.
SCALE 1" = 100'

LEGEND

- LINE TYPES**
- Tablot Boundary
 - Road Right-of-Way
 - Railroad Right-of-Way
 - Private Road ROW
 - Subdivision Plot Boundary
 - Waterline - Tablot Boundary
 - Waterline - Non Boundary
 - Historical Boundary
 - Environment
 - Railroad Centerline
 - Taxcode Line
 - Map Boundary

CORNER TYPES

- + 1/16th Section Cor.
- ⊕ 1/4 Section Cor.
- ⊙ D/C Corner
- ⊕ Section Corner

NUMBERS

- Tax Code - Number
- 00 00 0
- Active
- All acre listed are Net Acres, excluding any portions of the tablot within public ROWs.

NOTES

Tick Mark: A tick mark in the road indicates that the tablot dimension extends into the public ROW.

CANCELLED NUMBERS

DISCLAIMER: THIS MAP WAS PREPARED FOR ASSESSMENT PURPOSES ONLY



FOR ADDITIONAL MAPS VISIT OUR WEBSITE AT
WWW.CO.MARION.ORG

PLOT DATE: 3/5/2024

09 2E 18AD

09 2E 18AD

SEE MAP 002E1808

SEE MAP 002E18A

SEE MAP 002E17

SEE MAP 002E180A


SEE MAP 002E17BC

SEE MAP 002E17

09 2E 18AD

09 2E 18AD

After

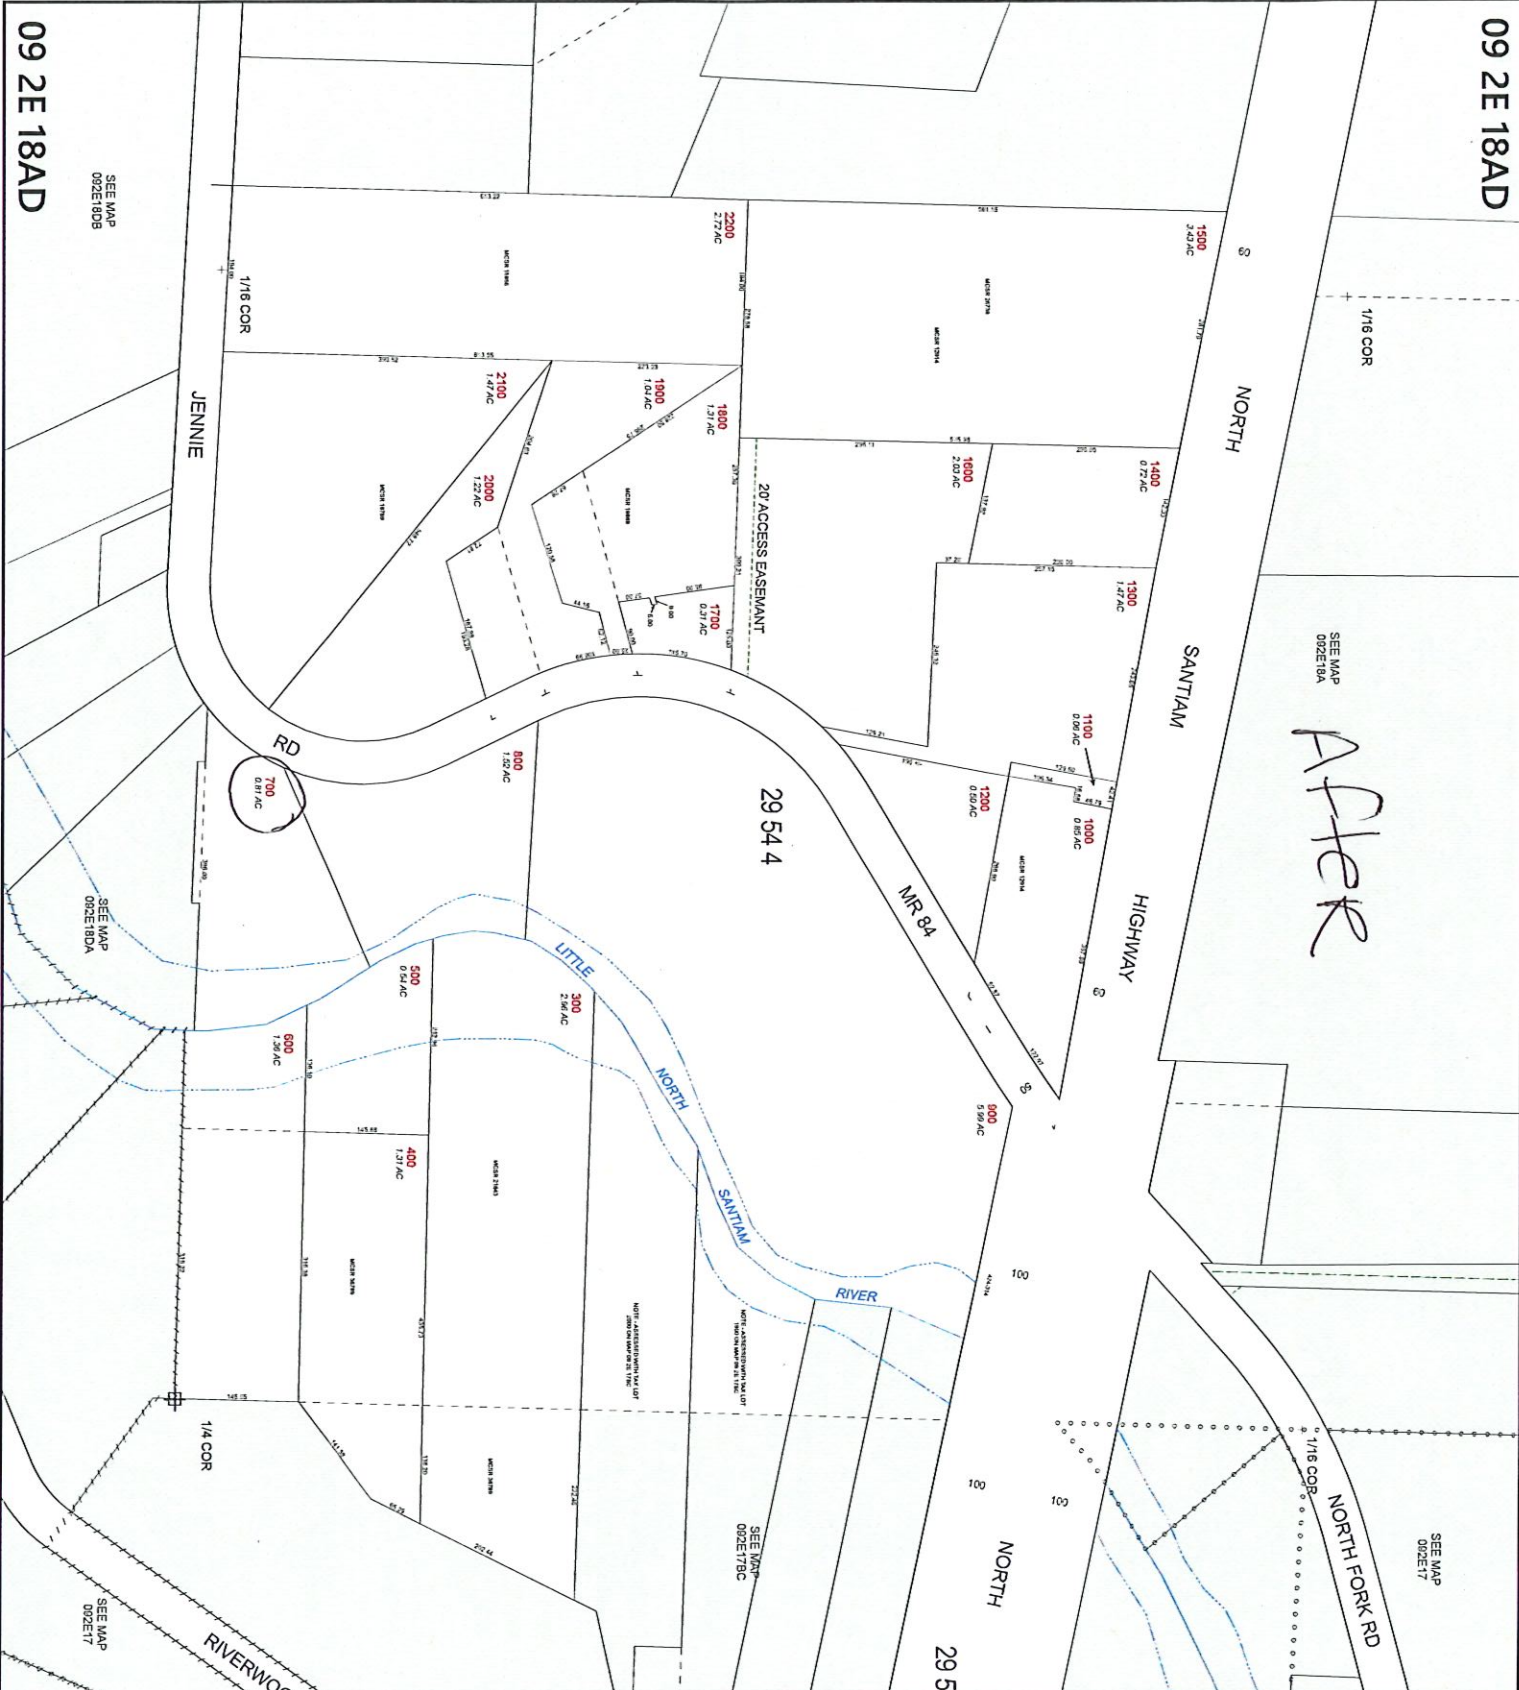

MARION COUNTY, OREGON
SE1/4 NE1/4 SEC18 T9S R2E W.M.
SCALE 1" = 100'

LEGEND

- LINE TYPES
 - Taxlot Boundary
 - Road Right-of-Way
 - Railroad Right-of-Way
 - Private Road ROW
 - Subdivision/Private Boundary
 - Waterline - Taxlot Boundary
 - Waterline - Non Boundary
- Historical Boundary
- Easement
- Railroad Right-of-Way
- Taxcode Line
- Map Boundary
- Waterline - Non Boundary

CORNER TYPES

- + 1/16th Section Cor
- ⊙ D/C Corner
- ⊕ 1/4 Section Cor
- ⊕ 1/8 Section Cor
- ⊕ 1/32 Section Corner

NUMBERS

- Tax Code Number
- 00 00 0

NOTES

All acres listed are Net Acres, excluding any 0.29-acre portions of the taxlot within public ROWs

Tick Mark: A tick mark in the road indicates that the labelled dimension extends into the public ROW

CANCELLED NUMBERS

DISCLAIMER: THIS MAP WAS PREPARED FOR ASSESSMENT PURPOSES ONLY



FOR ADDITIONAL MAPS VISIT OUR WEBSITE AT www.co.marion.or.us

PLOT DATE: 2/24/2025

09 2E 18AD

09 2E 18AD

SEE MAP 002E1808

SEE MAP 002E18A

SEE MAP 002E18DA

SEE MAP 002E17

SEE MAP 002E17