

# 529779Rural Work Order Cover Sheet

RAM Transaction #: 805722 Recording Date: 10/26/24 Year: 25 - 26

Account Numbers Involved: 529779, 529770, 529753, 529749  
(New accounts in **Green**, Cancelled accounts in **Red**)

Sequence #1: 529779, CANCELED AND COMBINED INTO 529749 - ACREAGE SET TO ZERO IN  
PREPERATION OF CANCELATION -44.38

Sequence #2: 529770 CANCELED AND COMBINED INTO 529749 - ACREAGE SET TO ZERO IN  
PREPERATION OF CANCELATION -19.41

Sequence #3: 529753 CANCELED AND COMBINED INTO 529749 - ACREAGE SET TO ZERO IN  
PREPERATION OF CANCELATION -4.35 CODE 5410

Sequence #4: 529753 CANCELED AND COMBINED INTO 529749 - ACREAGE SET TO ZERO IN  
PREPERATION OF CANCELATION -13.22 CODE 92410

Sequence #5: 529779, 529770 & 529753 CANCELED AND COMBINED INTO 529749 CODE 5410 +4.35

Sequence #6: 529779, 529770 & 529753 CANCELED AND COMBINED INTO 529749 CODE 92410 +13.22

| Check For:            |                                     |                                     |                                       |                                     | Forms Included:                     |                                     |
|-----------------------|-------------------------------------|-------------------------------------|---------------------------------------|-------------------------------------|-------------------------------------|-------------------------------------|
|                       | Yes                                 | No                                  |                                       | Yes                                 | No                                  | ✓                                   |
| Move Building Permits | <input type="checkbox"/>            | <input checked="" type="checkbox"/> | Multi-Section                         | <input type="checkbox"/>            | <input checked="" type="checkbox"/> | <input checked="" type="checkbox"/> |
| Move Photos           | <input checked="" type="checkbox"/> | <input type="checkbox"/>            | Tagged for 2 <sup>nd</sup> year Reset | <input type="checkbox"/>            | <input checked="" type="checkbox"/> | <input checked="" type="checkbox"/> |
| Update Apex           | <input checked="" type="checkbox"/> | <input type="checkbox"/>            | Exemptions                            | <input checked="" type="checkbox"/> | <input type="checkbox"/>            | <input checked="" type="checkbox"/> |
| Update Account Notes  | <input checked="" type="checkbox"/> | <input type="checkbox"/>            | Update Tracker                        | <input checked="" type="checkbox"/> | <input type="checkbox"/>            | <input type="checkbox"/>            |
| PAT LIAB Updates      | <input type="checkbox"/>            | <input checked="" type="checkbox"/> |                                       |                                     |                                     | <input type="checkbox"/>            |
|                       |                                     |                                     |                                       |                                     |                                     |                                     |

Miscellaneous Notes:  
**(Follow up workflow to correct soil, inventory, etc?)**

FOLLOW UP FOR IMPROVEMENT REVIEW

Forms Completed By: WW Date: 6/12/25  
Appraisal Review: WW BLS Date: 6/12/25  
Data Entry: CWD Date: 6/13/25

| Tax Year | Account ID | MTL           | Transaction | Voucher Sequence | Recorded Date   | Operation          | Voucher Notes                                                                                                 | Code  | +/- Size | Size Type |
|----------|------------|---------------|-------------|------------------|-----------------|--------------------|---------------------------------------------------------------------------------------------------------------|-------|----------|-----------|
| 2025     | 529779     | 082W02D000200 | 805722      | 1                | 10/26/2024 0:00 | COMBINATION - FROM | 529779, 529770 & 529753 CANCELED AND COMBINED INTO 529749 - ACREAGE SET TO ZERO IN PREPERATION OF CANCELATION | 92410 | -44.38   | A         |
| 2025     | 529770     | 082W11A000600 | 805722      | 2                | 10/26/2024 0:00 | COMBINATION - FROM | 529779, 529770 & 529753 CANCELED AND COMBINED INTO 529749 - ACREAGE SET TO ZERO IN PREPERATION OF CANCELATION | 92410 | -19.41   | A         |
| 2025     | 529753     | 082W11A001000 | 805722      | 3                | 10/26/2024 0:00 | COMBINATION - FROM | 529779, 529770 & 529753 CANCELED AND COMBINED INTO 529749 - ACREAGE SET TO ZERO IN PREPERATION OF CANCELATION | 5410  | -4.35    | A         |
| 2025     | 529753     | 082W11A001000 | 805722      | 3                | 10/26/2024 0:00 | COMBINATION - FROM | 529779, 529770 & 529753 CANCELED AND COMBINED INTO 529749 - ACREAGE SET TO ZERO IN PREPERATION OF CANCELATION | 92410 | -13.22   | A         |
| 2025     | 529749     | 082W120000300 | 805722      | 4                | 10/26/2024 0:00 | COMBINATION - TO   | 529779, 529770 & 529753 CANCELED AND COMBINED INTO 529749                                                     | 5410  | 4.35     | A         |
| 2025     | 529749     | 082W120000300 | 805722      | 4                | 10/26/2024 0:00 | COMBINATION - TO   | 529779, 529770 & 529753 CANCELED AND COMBINED INTO 529749                                                     | 92410 | 77.01    | A         |

529779 NO MAR  
 529770 NO MAR  
 529753 NO MAR  
 529749 22, 270

# Rural Work Order Processing Form

One Page Per Account

Sequence #: 1-6 of 6 Account Number: 529749 MTL: 082W120000300 RAM Transaction ID: 805722

Type: ☒ COM ☐ LLA ☐ PPT ☐ SEG ☐ SUB ☐ AC ☐ R of W ☐ Vacate ☐ Map Maintenance

## Account Details

Ma Sa Nh: 0106000 Prop Class: 551 RMV Class: 501 Part of Unit: Yes ☒ or No ☐

## Land Fragment

| Account From | Code Area | Liab Yr | Land Class | LUC | Value Source   | # of Acres | Zone | Land Adjustments |
|--------------|-----------|---------|------------|-----|----------------|------------|------|------------------|
| 529779       | 92410     | 1976    | 4HI        | 005 | FARM USE – EFU | 44.38      | REST | IRR              |
| 529770       | 92410     | 1976    | WST        | 005 | WATER          | 19.41      | REST | WASTE            |
| 529773       | 05410     | 1976    | 2HI        | 005 | FARM USE – EFU | 4.35       | REST | GSOIL, IRR       |
| 529773       | 92410     | 1976    | 2HI        | 005 | FARM USE – EFU | 13.22      | REST | GSOIL, IRR       |
| 529749       | 05410     | 1976    | 2HI        | 005 | FARM USE – EFU | 17.80      | REST | GSOIL, IRR       |
| 529749       | 05410     | 1980    | WST        | 005 | FARM USE – EFU | 1.20       | REST | WASTE            |
| 529749       | 92410     | 1976    | 2HD        | 005 | FARM USE – EFU | 56.00      | REST | GSOIL            |
| 529749       | 92410     | 1976    | 2HI        | 005 | FARM USE – EFU | 35.00      | REST | WASTE            |
| 529749       | 92410     | 1976    | 4HD        | 005 | FARM USE – EFU | 10.44      | REST |                  |
| 529749       | 92410     | 1980    | WST        | 005 | FARM USE – EFU | 9.00       | REST | WASTE            |

|                        |                  |        |               |        |                     |       |
|------------------------|------------------|--------|---------------|--------|---------------------|-------|
| <b>Acreage Balance</b> | Beginning Acres: | 129.44 | Ending Acres: | 210.80 | Net Gained or Lost: | 81.36 |
|------------------------|------------------|--------|---------------|--------|---------------------|-------|

## Improvements

| Account From | Code Area | Imp ID | Stat Class | Description & Size | Account From | Code Area | Imp ID | Stat Class | Description & Size |
|--------------|-----------|--------|------------|--------------------|--------------|-----------|--------|------------|--------------------|
| 529779       | 92410     | 1      | 357        | FC EXEMPT 1920SF   | 529749       | 92410     | 1      | 342        | MC 2880            |
| 529779       | 92410     | 2      | 341        | MP 200             | 529749       | 92410     | 2      | 357        | FC EXEMPT 1800SF   |

Adjustments: \_\_\_\_\_

## Exception

New MAV: \_\_\_\_\_ ☐ Sys Calc ☒ No Change to MAV



08 2W 02D

082W 02D



MARION COUNTY, OREGON  
SE1/4 SEC2 T8S R2W W.M.

SCALE 1" = 200'

### LEGEND

- LINE TYPES**
- |                             |       |
|-----------------------------|-------|
| Taxlot Boundary             | ----- |
| Road Right-of-Way           | ===== |
| Railroad Right-of-Way       | ===== |
| Private Road ROW            | ===== |
| Subdivision/Plat Boundary   | ===== |
| Waterline - Taxlot Boundary | ----- |
| Waterline - Non Boundary    | ----- |
| Historical Boundary         | ----- |
| Easement                    | ----- |
| Railroad Centerline         | ===== |
| Twocore Line                | ===== |
| Map Boundary                | ===== |

## CORNER TYPES

- + 1/16TH Section Cor.  
 16 15  
 21 22  
 1/4 Section Cor.  
 Section Corner

## NUMBERS

00 00 0

Acres: 0.25 AC  
All acres listed are Net Acres, excluding any portions of the taxlot within public ROWs

## NOTES

**Tick Marks:** A tick mark in the road indicates that the labeled dimension extends into the public ROW



CANCELLED NUMBERS


301  
400

DISCLAIMER: THIS MAP WAS PREPARED  
FOR ASSESSMENT PURPOSES ONLY



FOR ADDITIONAL MAPS VISIT OUR WEBSITE AT  
[www.co.marion.or.us](http://www.co.marion.or.us)

PLOT DATE: 12/22/2022

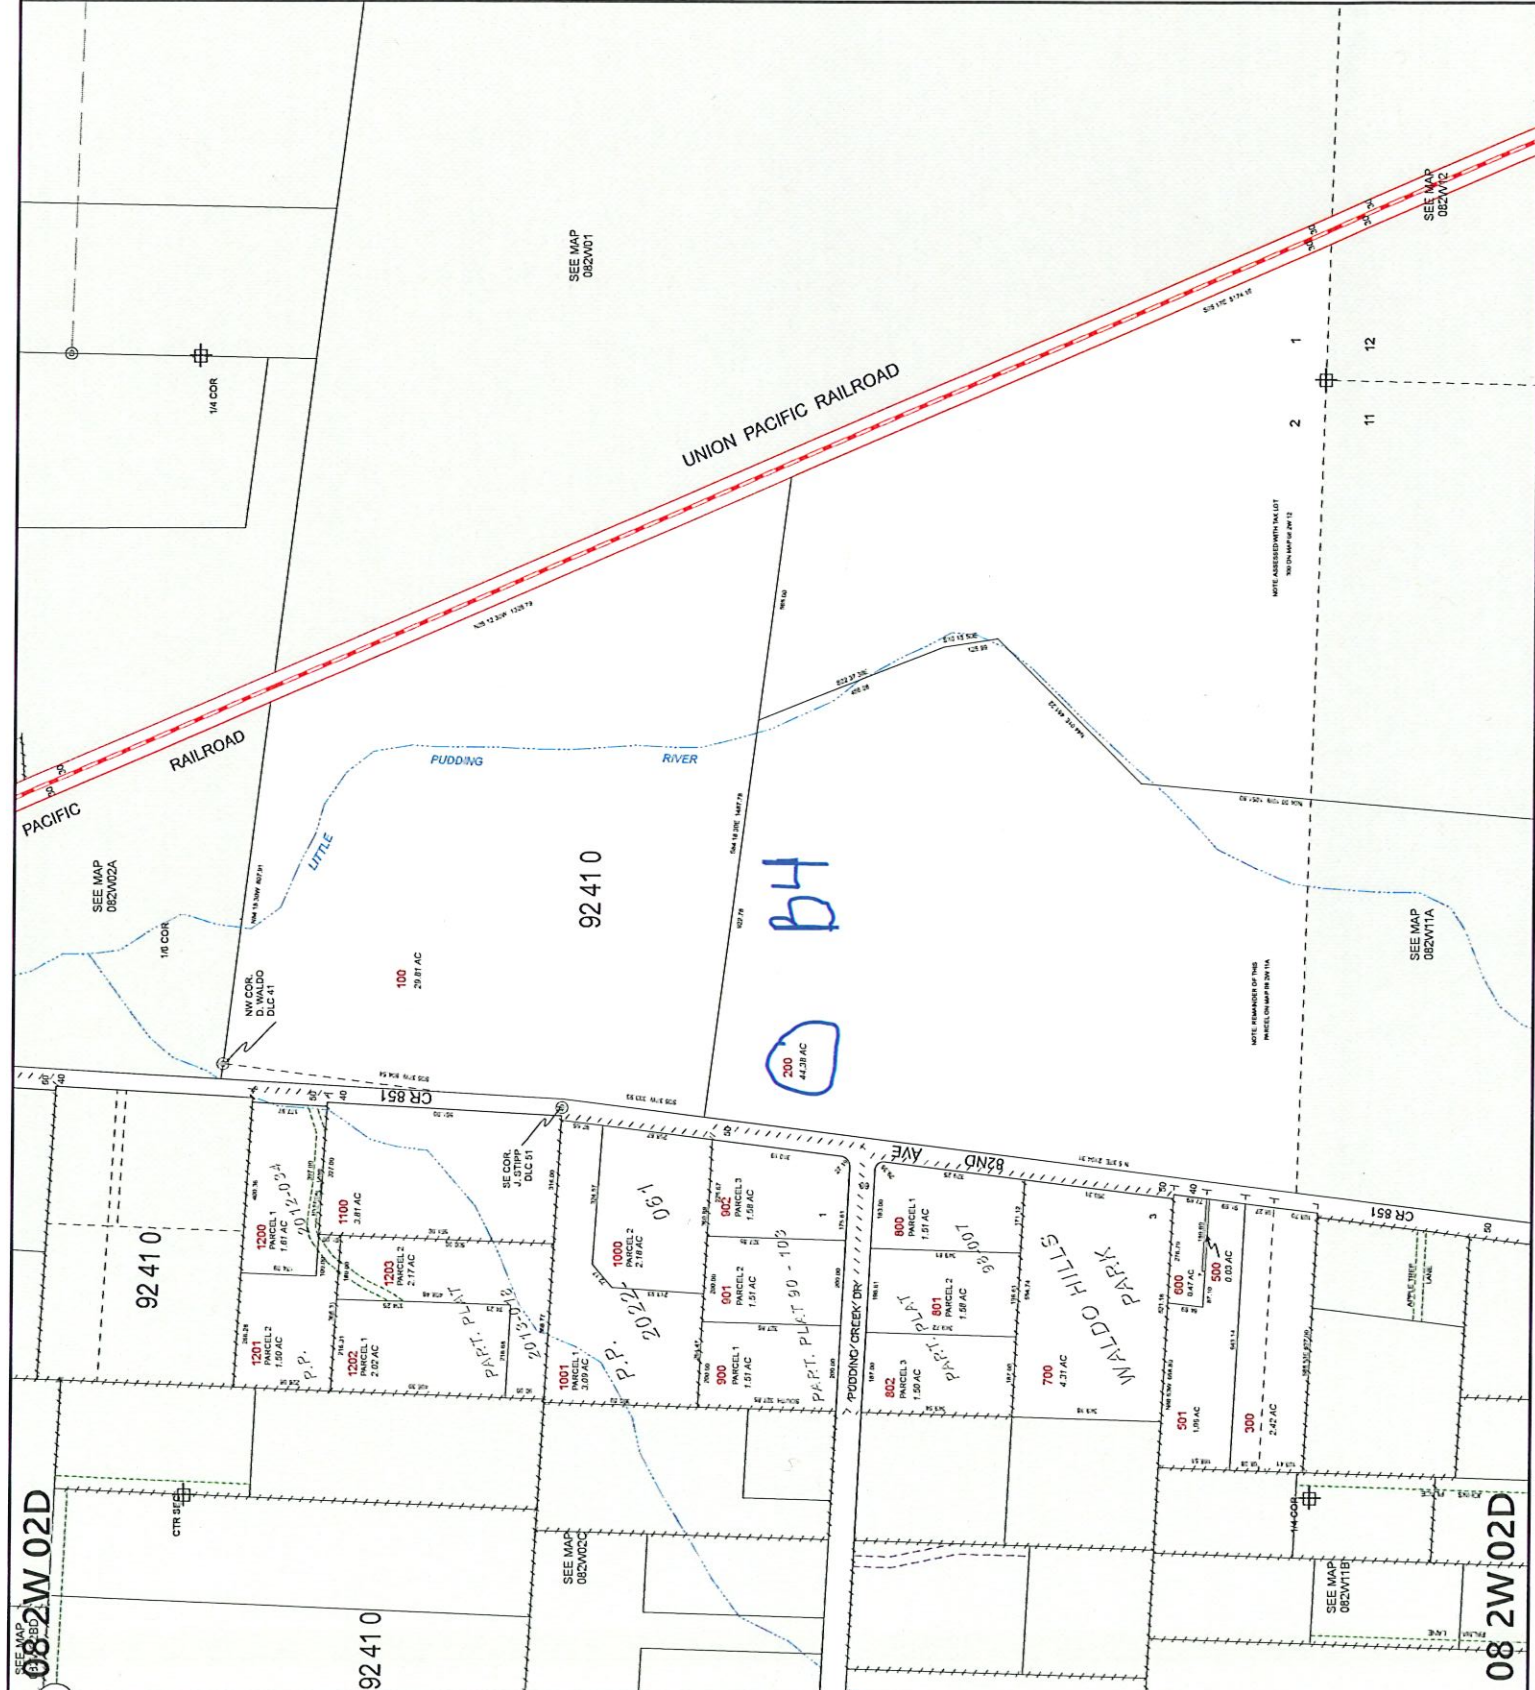






08 2W 12

08 2W 12

08 2W 12

08 2W 12

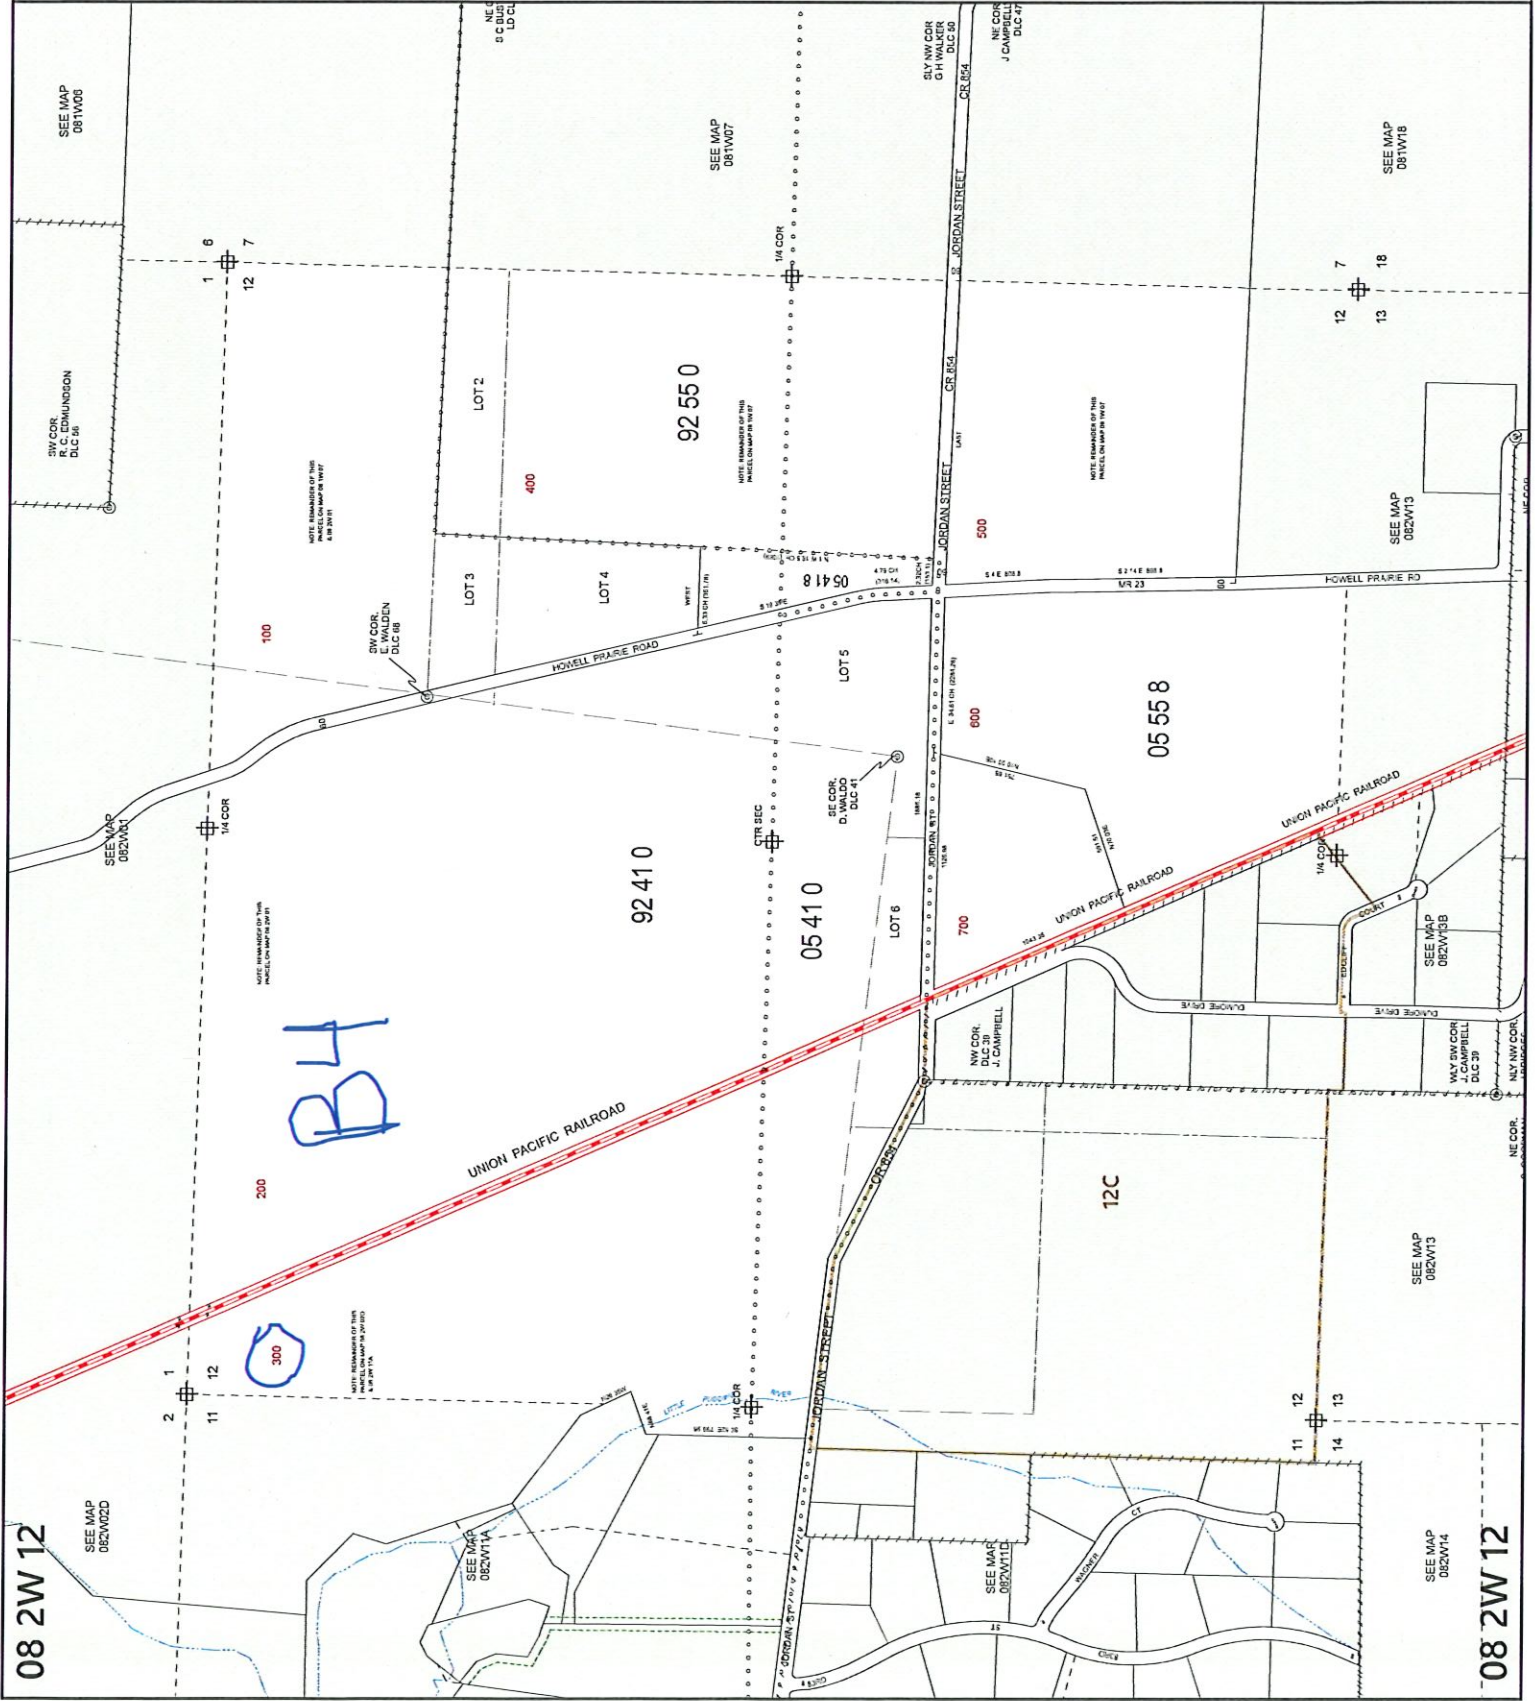

**MARION COUNTY, OREGON**  
SEC 12 T8S R2W W.M.  
SCALE 1" = 400'

- LEGEND**
- LINE TYPES**
- Historical Boundary
  - Right-of-Way
  - Railroad Right-of-Way
  - Private Road ROW
  - Subdivision/Plat Boundary
  - Waterline - Toilet Body
  - Waterline - Non Body
- CORNER TYPES**
- + 1/16th Section Cor.
  - ⊕ 1/4 Section Cor.
  - ⊙ D/C Corner
  - ⊕ 16, 15 Section Corner
  - ⊕ 21, 22
- NUMBERS**
- Tax Code Number  
**00 00 0**
- Acres  
All acres listed are Net Acres, excluding any portions of the taxlot within public ROWs
- NOTES**
- Tick Marks: A tick mark in the road indicates that the labeled dimension extends into the public ROW

**CANCELLED NUMBERS**

|  |
|--|
|  |
|  |
|  |
|  |

DISCLAIMER: THIS MAP WAS PREPARED FOR ASSESSMENT PURPOSES ONLY



FOR ADDITIONAL MAPS VISIT OUR WEBSITE AT [www.co.marion.or.us](http://www.co.marion.or.us)

PLOT DATE: 10/16/2020








08 2W 11A

08 2W 11A

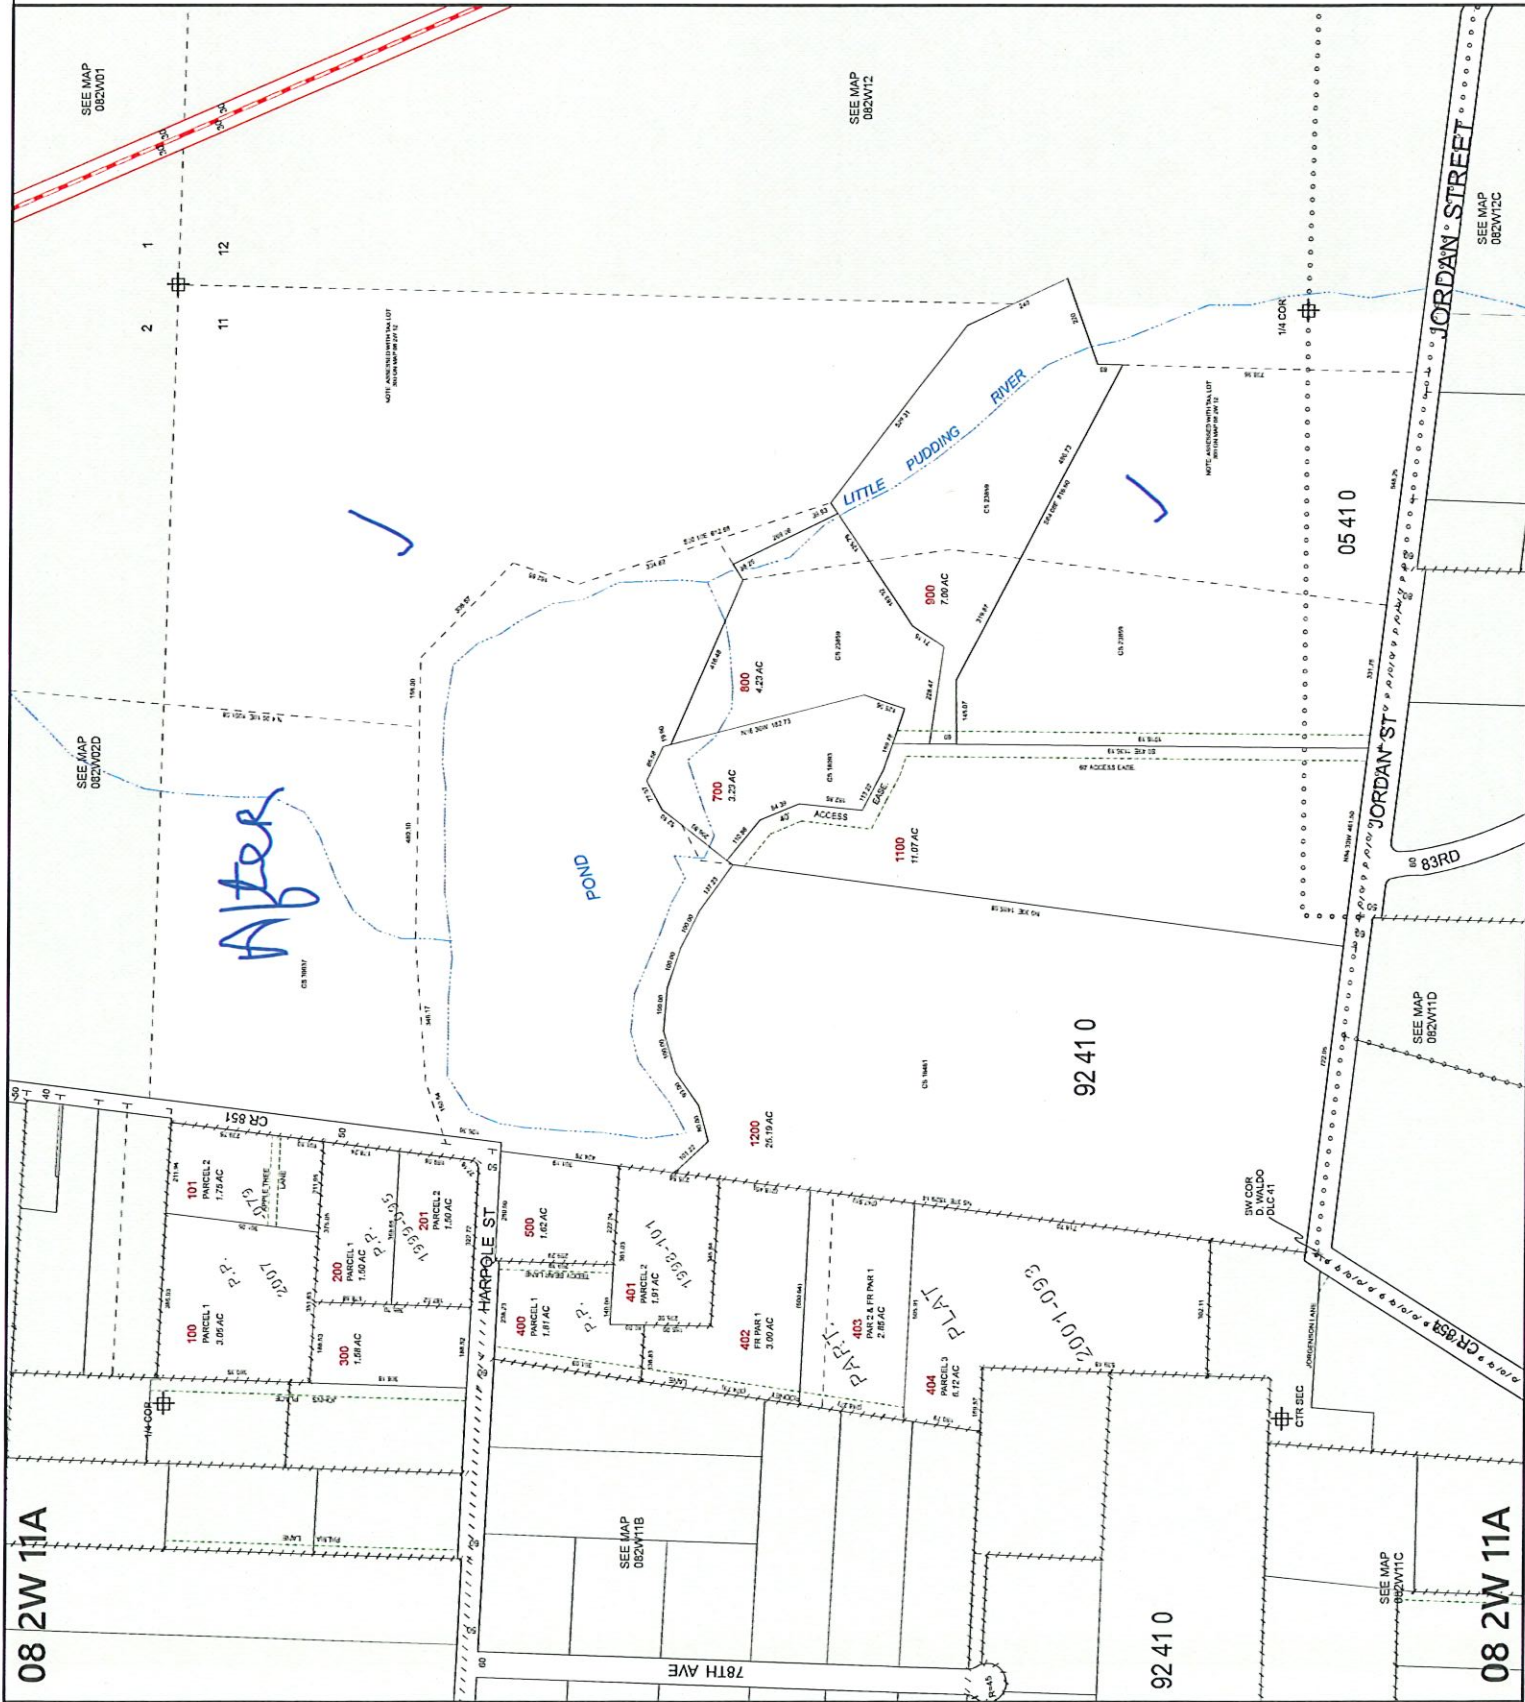

MARION COUNTY, OREGON  
NE 1/4 SEC 11 T8S R2W W.M.  
SCALE 1" = 200'

### LEGEND

#### LINE TYPES

- Twist Boundary
- Road Right-of-Way
- Railroad Right-of-Way
- Private Road ROW
- Subdivision/Plat Bndry
- Waterline - Twist Bndry
- Waterline - Non Bndry
- Historical Boundary
- Easement
- Taxroad Centerline
- Map Boundary

#### CORNER TYPES

- + 1/16TH Section Cor
- ⊙ D/C Corner
- ⊕ 1/4 Section Cor
- ⊕ 1/16TH Section Cor
- ⊕ 21 22

#### NUMBERS

Tax Code Number  
00 00 0

All acres listed are Net Acres, excluding any portions of the taxlot within public ROWs

#### NOTES

Tick Marks: A tick mark in the road indicates that the labeled dimension extends into the public ROW

#### CANCELLED NUMBERS

000  
1000

DISCLAIMER: THIS MAP WAS PREPARED FOR ASSESSMENT PURPOSES ONLY



FOR ADDITIONAL MAPS VISIT OUR WEBSITE AT  
WWW.CO.MARION.ORG

PLOT DATE: 5/28/2025


08 2W 11A

08 2W 11A



08 2W 02D

08 2W 02D

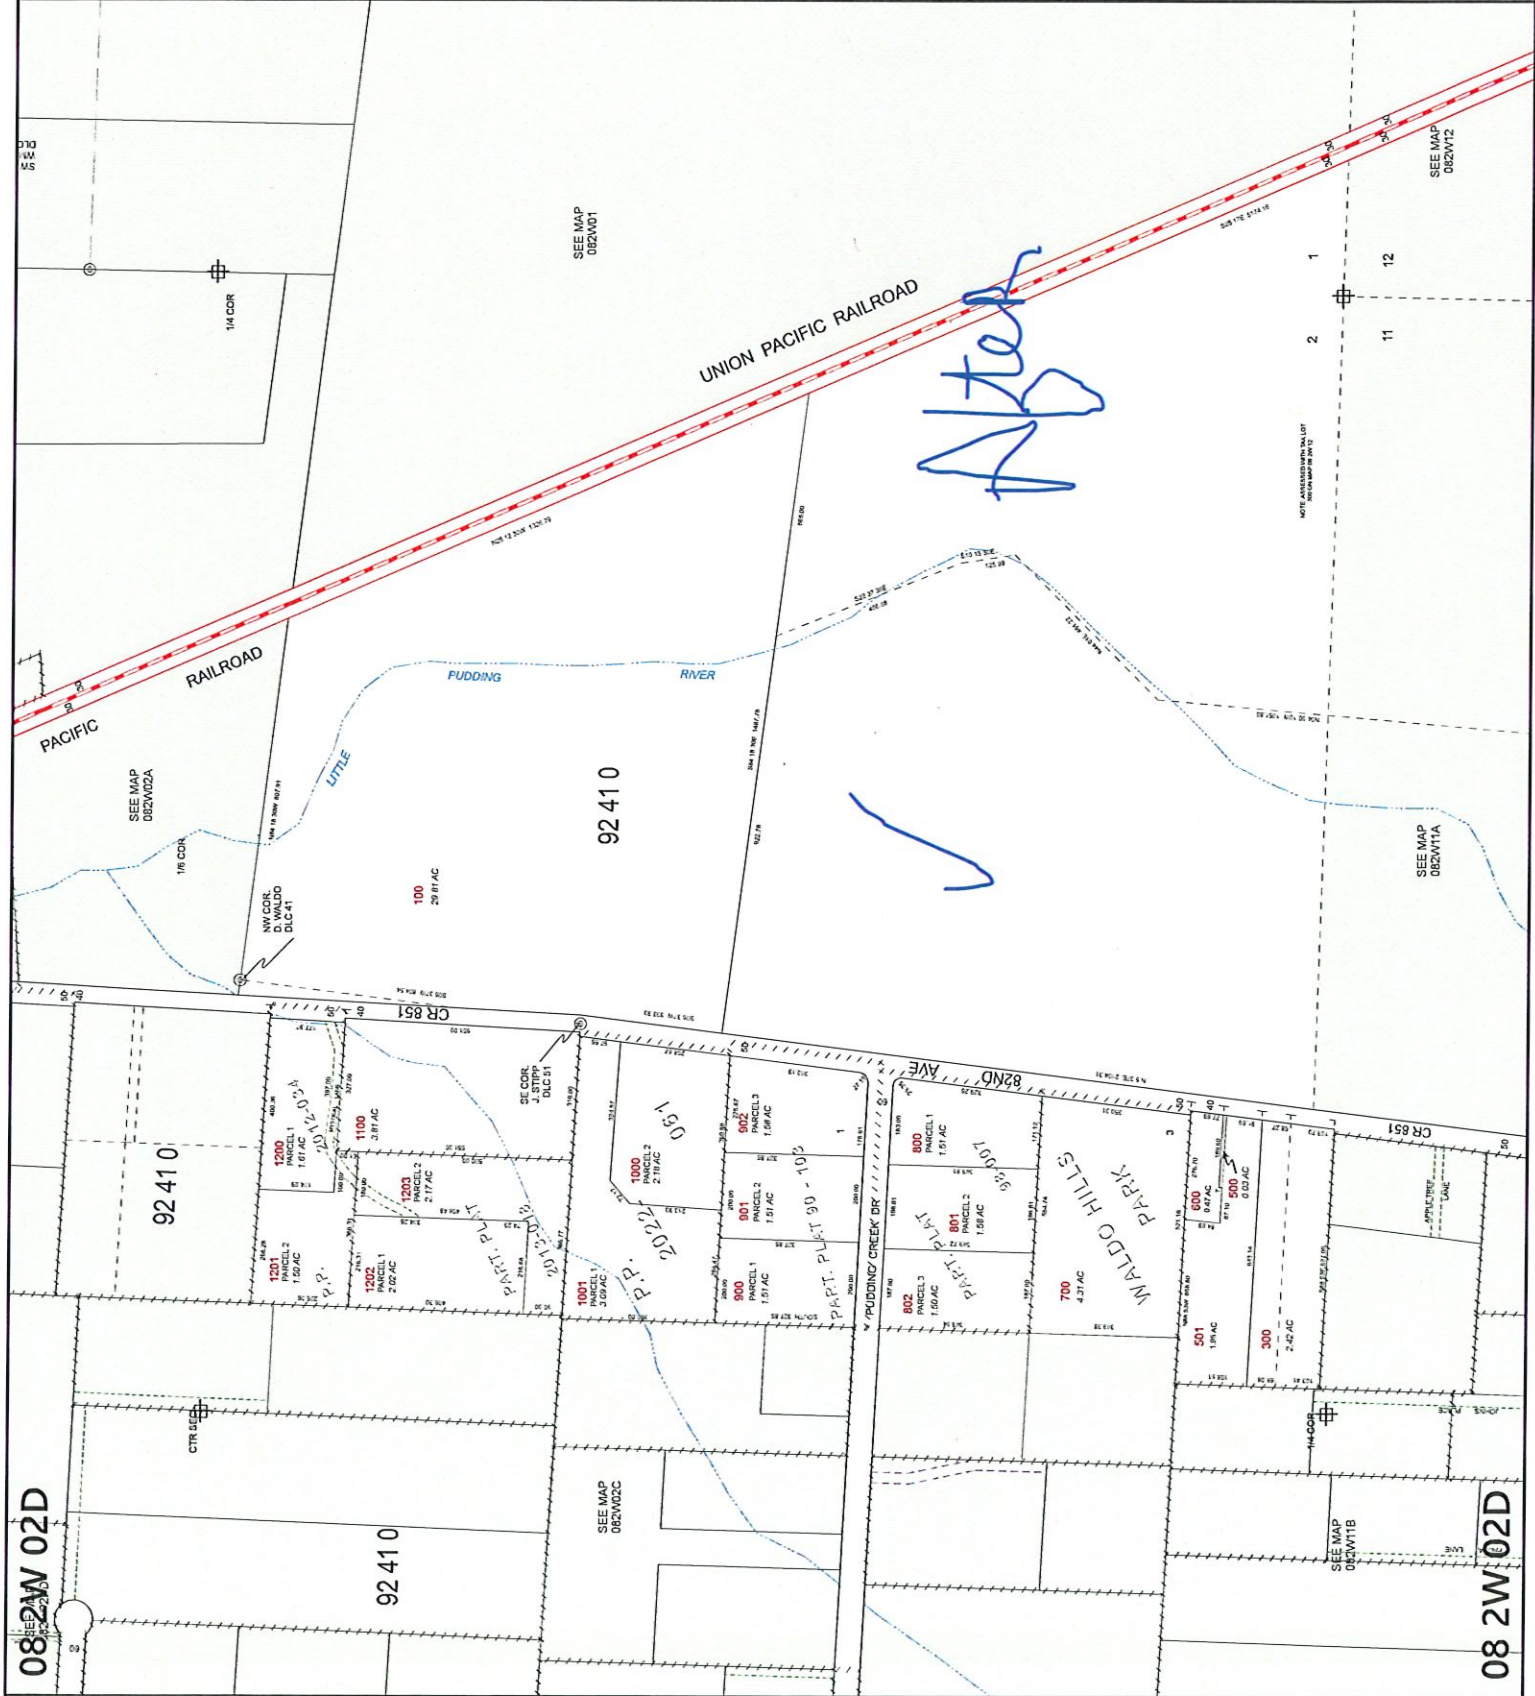

MARION COUNTY, OREGON  
SE1/4 SEC2 T8S R2W W.M.  
SCALE 1" = 200'

LEGEND

LINE TYPES

- Historical Boundary
- Taxlot Boundary
- Road Right-of-Way
- Railroad Right-of-Way
- Private Road ROW
- Subdivision Plat Bndry
- Waterline - Toilet Bndry
- Waterline - Non Bndry
- Easement
- Railroad Centerline
- Taxcode Line
- Map Boundary
- Waterline - Non Bndry

CORNER TYPES

- + 1/4 Section Cor
- ⊙ 1/16TH Section Cor
- ⊙ 1/4 Corner
- ⊙ 1/8 Corner
- ⊙ 1/16 Corner
- ⊙ 1/32 Corner
- ⊙ 1/1298074214637066907132624822305024 Corner
- ⊙ 1/2596148429274133814265249644610048 Corner
- ⊙ 1/5192296858548267628530499289220096 Corner
- ⊙ 1/1038459371709653525706099857840192 Corner
- ⊙ 1/2076918743419307051412199715680384 Corner
- ⊙ 1/4153837486838614102824399431360768 Corner
- ⊙ 1/8307674973677228205648798862721536 Corner
- ⊙ 1/1661534994735445641129759772543072 Corner
- ⊙ 1/3323069989470891282259519545086144 Corner
- ⊙ 1/6646139978941782564519039090172288 Corner
- ⊙ 1/1329227995788356512903807818034576 Corner
- ⊙ 1/2658455991576713025807615636069152 Corner
- ⊙ 1/5316911983153426051615231272138304 Corner
- ⊙ 1/10633823966306852103230462544276608 Corner
- ⊙ 1/21267647932613704206460925088553216 Corner
- ⊙ 1/42535295865227408412921850177106432 Corner
- ⊙ 1/85070591730454816825843700354212864 Corner
- ⊙ 1/170141183460909633651687400708427296 Corner
- ⊙ 1/340282366921819267303374801416854592 Corner
- ⊙ 1/680564733843638534606749602833709184 Corner
- ⊙ 1/1361129467687277069213499205667418368 Corner
- ⊙ 1/2722258935374554138426998411334836736 Corner
- ⊙ 1/5444517870749108276853996822669673472 Corner
- ⊙ 1/10889035741498216553707993645339346944 Corner
- ⊙ 1/21778071482996433107415987290678693888 Corner
- ⊙ 1/43556142965992866214831974581357387776 Corner
- ⊙ 1/87112285931985732429663949162714775552 Corner
- ⊙ 1/174224571863971464593327898325429551104 Corner
- ⊙ 1/348449143727942929186655796650859102208 Corner
- ⊙ 1/696898287455885858373311593301718204416 Corner
- ⊙ 1/1393796574911771716746623866603436408832 Corner
- ⊙ 1/2787593149823543433493247733206872817664 Corner
- ⊙ 1/5575186299647086866986495466413745635328 Corner
- ⊙ 1/11150372599294173733972990932827491170656 Corner
- ⊙ 1/22300745198588347467945981865654982341312 Corner
- ⊙ 1/44601490397176694935891963731309964822624 Corner
- ⊙ 1/89202980794353389871783927462619929645248 Corner
- ⊙ 1/178405961588706779743577854925239859290496 Corner
- ⊙ 1/356811923177413559487155709850479718580992 Corner
- ⊙ 1/713623846354827118974311419700959437161984 Corner
- ⊙ 1/1427247692709654237948622839401918873939872 Corner
- ⊙ 1/2854495385419308475897245678803837747879744 Corner
- ⊙ 1/5708990770838616951794491357607675495759488 Corner
- ⊙ 1/11417981541677233903588982715215350991518976 Corner
- ⊙ 1/22835963083354467807177965430430701983037952 Corner
- ⊙ 1/4567192616670893561435593086086140396607584 Corner
- ⊙ 1/9134385233341787122871186172172280793215168 Corner
- ⊙ 1/18268770466683574245742372344344561486431336 Corner
- ⊙ 1/3653754093336714849148474468868912972862672 Corner
- ⊙ 1/7307508186673429698296948937737825945725344 Corner
- ⊙ 1/14615016373346859396593897875475651891450688 Corner
- ⊙ 1/29230032746693718793187795750951303782901376 Corner
- ⊙ 1/58460065493387437586375591501902607565802752 Corner
- ⊙ 1/116920130986774875172751183003805215131605504 Corner
- ⊙ 1/233840261973549750345502366007610430263211008 Corner
- ⊙ 1/467680523947099500691004732015220860526422016 Corner
- ⊙ 1/935361047894199001382009464030441721052844032 Corner
- ⊙ 1/187072209578839800276401888060888344205568064 Corner
- ⊙ 1/374144419157679600552803776121776688411136128 Corner
- ⊙ 1/748288838315359201105607552243553376822272256 Corner
- ⊙ 1/149657767663071840221121510448710674464444512 Corner
- ⊙ 1/299315535326143680442243020897421389288889024 Corner
- ⊙ 1/598631070652287360884486041794842778577778048 Corner
- ⊙ 1/1197262141304574721768972083589685557155556096 Corner
- ⊙ 1/2394524282609149443537944167179371114311112192 Corner
- ⊙ 1/4789048565218298887075888334358742286222224384 Corner
- ⊙ 1/9578097130436597774151776668717484572444448768 Corner
- ⊙ 1/1915619426087319554330355333743496914488897536 Corner
- ⊙ 1/3831238852174639108660710667486993828977795072 Corner
- ⊙ 1/7662477704349278217321421334973987657955590144 Corner
- ⊙ 1/15324955408698556434642842669947975315911180288 Corner
- ⊙ 1/30649910817397112869285685339895950631822360576 Corner
- ⊙ 1/61299821634794225738571370679791901263644721152 Corner
- ⊙ 1/122599643269588451477142741359581802527289442304 Corner
- ⊙ 1/245199286539176902954285482719163605054578884608 Corner
- ⊙ 1/490398573078353805908570965438327210109157769216 Corner
- ⊙ 1/980797146156707611817141930876665440218315538432 Corner
- ⊙ 1/1961594292333415223634273861533308880436631078656 Corner
- ⊙ 1/3923188584666830447268547723066617608773262157312 Corner
- ⊙ 1/7846377169333660894537095446133235217546524314624 Corner
- ⊙ 1/15692754338667321789074190892266463509105288629248 Corner
- ⊙ 1/31385508677334643578148381784532927018210577258496 Corner
- ⊙ 1/62771017354669287156296763569065854036421154516992 Corner
- ⊙ 1/125542034709338574312593527138131708072842309033984 Corner
- ⊙ 1/251084069418677148625187054276263416145684618067968 Corner
- ⊙ 1/502168138837354297250374108552526832291369236135936 Corner
- ⊙ 1/1004336277674708594500748217105053664582738472271872 Corner
- ⊙ 1/2008672555349417189001496434210107329165476944537744 Corner
- ⊙ 1/4017345110698834378002992868420214582308953889075488 Corner
- ⊙ 1/8034690221397668756005985736840429164617907778150976 Corner
- ⊙ 1/160693804427953375120119714736808583292358155633119552 Corner
- ⊙ 1/321387608855906750240239429473617165847116306666239104 Corner
- ⊙ 1/642775217711813500480478858947234331694232613332478208 Corner
- ⊙ 1/1285550435423627000960957717894468663388465226664956416 Corner
- ⊙ 1/2571100870847254001921915435788937326776930453329912832 Corner
- ⊙ 1/5142201741694508003843830871577874653553860906659825664 Corner
- ⊙ 1/10284403483389016007687661743155749067107721813199651328 Corner
- ⊙ 1/20568806966778032015375323486311498134214435626399302656 Corner
- ⊙ 1/41137613933556064030750646972622996868428871252798605312 Corner
- ⊙ 1/82275227867112128061501293945245993736857742505597210624 Corner
- ⊙ 1/164550457734224256123002579890491974671515485011194421248 Corner
- ⊙ 1/32910091546844851224600515978098394934303097002238884496 Corner
- ⊙ 1/65820183093689702449201031956196789868606194004477778992 Corner
- ⊙ 1/131640366187379404898402063912393779737212388008955557984 Corner
- ⊙ 1/263280732374758809796804127824787559474424776017911115968 Corner
- ⊙ 1/526561464749517619593608255649575118948849552035822231936 Corner
- ⊙ 1/1053122929499035239187216511291500237897691040071644463712 Corner
- ⊙ 1/2106245858998070478374433022583000475795382080143288927424 Corner
- ⊙ 1/4212491717996140956748866045166000951590764160286577854848 Corner
- ⊙ 1/8424983435992281913497733090332001903181528320573155709696 Corner
- ⊙ 1/1684996687198456382699546618064003806336305664114631119392 Corner
- ⊙ 1/336999337439691276539909323612800761267261132822926238784 Corner
- ⊙ 1/673998674879382553079818647225601522534522265645852477568 Corner
- ⊙ 1/1347997349758765106159737294451203045069044531291044955136 Corner
- ⊙ 1/2695994699517530212319474588902406090138089062582089910272 Corner
- ⊙ 1/5391989399035060424638949177804812180276178125164179820544 Corner
- ⊙ 1/10783978798070120849277898355609624360552356250328359641088 Corner
- ⊙ 1/21567957596140241698555797111219248721107111000656679282176 Corner
- ⊙ 1/43135915192280483397111594222438484422214222001313358564352 Corner
- ⊙ 1/86271830384560966794223188444876868844428444002626717128704 Corner
- ⊙ 1/172543660769121933588446376889753737688856888005253434257408 Corner
- ⊙ 1/345087321538243867176892753779507475377713776010506868514816 Corner
- ⊙ 1/690174643076487734353785507559014950754427552021013737029632 Corner
- ⊙ 1/1380349286152974688707571015118029900148855104042027474059264 Corner
- ⊙ 1/2760698572305949377415142030236059800297716808084054949118528 Corner
- ⊙ 1/5521397144611898754830284060472116005954336176168109898237056 Corner
- ⊙ 1/11042794289223797496660568120942232011908668352336219796474112 Corner
- ⊙ 1/2208558857844759499332113624188446402381733670467243959294824 Corner
- ⊙ 1/4417117715689518998664227248376892804763467340934487918589648 Corner
- ⊙ 1/8834235431379037997328454496753785609526934681868975837179296 Corner
- ⊙ 1/17668470862758075994656908993507571219053869363737951674358592 Corner
- ⊙ 1/353369417255161519893138179870151424381073787274