

Summary

Lead Appr: WW 12/9 Clerk: Lead Clerk: Appr: MLH 2/5/26

Print Date: 9/26/2025

Acct ID: 560735 MTL: 071E07A001300 Date: 10/15/25 Appr: MLH Prop Class: 409 RMV Prop Class: 409
Situs: 3818 STARLIGHT DR NE SILVERTON OR 97381 MaSaNh: 03 06 000 Unit: 107838 Year: 2025
Last Date Appraised: 01/15/2025 Appraiser: MATTHEW HAMILTON Tag: Y N Tag info: 2026 - Tags/Permit (Outbuilding)
Owner: MITCHELL, BRIAN J Last Sales Date: 07/12/2018 Roll Type: R
Cycle Tag Sales Verification Other: Inspection level: 1 2 3 4 LCB TTO INSP AV: 217660
RMV Land: 305420 RMV Imp: 277080 RMV Total: 582500 MAV: 205320 MSAV: 0 SAV: 0
Comment: 25-26: L1 1.15.25 MLH
24-25 L3 12/7/23 CLUKE

Change HC to MS update inventory
Close Tag
Input MLH 12/8/25

OSDs

Table with 5 columns: Count, Code, Description, RMV, Code Area, Exception. Row 1: 1, MKTA, OSD - AVERAGE, 50000, 04500, 0

Land

Site: 1 Code Area: 04500 Size: 2.09 Acres Use Code: 004 Zone: NREST SAV Use: Exception: 0
Class: 4BDSS Value Source: Rural at MKT Description: FOUR BENCH DRY SPECIAL SOUTH RMV: 255420 Exception: Y N
Adjustment(s): Fire Patrol: Description:
Comments: 05-06: RECALC SETUP; APPR 36, 05/28/04.

Improvements - Residence / Manufactured Structures

Bldg: 1 Code Area: 04500 Stat Class: 138 Year Blt: Eff Year Blt: 1997 Sq.Ft: 0 % Complete: 100.00
Desc: Res other improvements Dimensions: RMV: 33200
Func Obsc: 100 Econ %: 100 Other %: 100 Exception: 0 Adjust: Adjust RMV: 0

Floors

Table with 10 columns: Type, Class, Display Group, Floor Size, Beds, Baths, Yr Blt, Eff Yr Blt, Inventory, Exception. Row 1: Carport Attached, 3, Unfinished, 360, 0, 0, 0, 1997, ROOF, Exception: Y N

Accessories

Table with 6 columns: Description, Class, Size SqFt, Eff Yr Blt, RMV, Quantity. Row 1: YARD IMPROVEMENTS AVERAGE, 3, 0, 1997, 16756, 1, Exception: Y N

Bldg: 3 Code Area: 04500 Stat Class: 468 Year Blt: 1995 Eff Year Blt: 1997 Sq.Ft: 1984 % Complete: 100.00
Desc: MANUF STRUCT, CLASS 6, 36' WIDE TRIPLE/QUAD Dimensions: RMV: 102810
Func Obsc: 100 Econ %: 100 Other %: 100 Exception: 0 Adjust: Adjust RMV: 0 Subtype: E

Floors

Table with 10 columns: Type, Class, Display Group, Floor Size, Beds, Baths, Yr Blt, Eff Yr Blt, Inventory, Exception. Row 1: First Floor, 6, Finished, 1984, 3, FB-3, 1995, 1997, SKRT+, ROOF+, BATH - 3, HVAC+, KIT-, Exception: Y N

Accessories

Table with 6 columns: Description, Class, Size SqFt, Eff Yr Blt, RMV, Quantity. Row 1: No accessory data available

Bldg: 5 Code Area: 04500 Stat Class: 131 Year Blt: 2014 Eff Year Blt: 2014 Sq.Ft: 682 % Complete: 100.00
Desc: One Story Only Dimensions: RMV: 114290
Func Obsc: 100 Econ %: 100 Other %: 100 Exception: 0 Adjust: Adjust RMV: 0

Floors

Table with 10 columns: Type, Class, Display Group, Floor Size, Beds, Baths, Yr Blt, Eff Yr Blt, Inventory, Exception. Row 1: First Floor, 3, Finished, 682, 1, 0, 2014, 2014, ROOF, HVAC+, Exception: Y N

Accessories

Table with 6 columns: Description, Class, Size SqFt, Eff Yr Blt, RMV, Quantity. Row 1: No accessory data available

Improvements - Accessory Buildings

Bldg: 4 Code Area: 04500 Stat Class: 353 Year Blt: 1984 Eff Year Blt: 1984 Sq.Ft: 352 % Complete: 100.00
Desc: Machine Shed (MS) Dimensions: 22x16 RMV: 920
Func Obsc: 100 Econ %: 100 Other %: 100 Exception: 0 Adjust: Adjust RMV: 0

Floors

Table with 10 columns: Type, Class, Display Group, Floor Size, Beds, Baths, Yr Blt, Eff Yr Blt, Inventory, Exception. Row 1: Machine Shed, 4, Finished, 352, 0, 0, 1984, 1984, FAIR, Exception: Y N

Accessories

Description	Class	Size SqFt	Eff Yr Blt	RMV	Quantity				
No accessory data available									
Bldg: 6	Code Area: 04500	Stat Class: 321	Year Blt: 2024	Eff Year Blt: 2024	Sq.Ft: 3120	% Complete: 100.00			
Desc: Hay Cover (HC)				Dimensions: 60x52	RMV: 25860				
Func Obsc: 100	Econ %: 100	Other %: 100	Exception: 12340	Adjust:	Adjust RMV: 0				
Floors									
Type	Class	Display Group	Floor Size	Beds	Baths	Yr Blt	Eff Yr Blt	Inventory	Exception: Y N
Hay Cover	5	Finished	3120	0	0	2024	2024	FAIR	
Accessories									
Description	Class	Size SqFt	Eff Yr Blt	RMV	Quantity				
No accessory data available									

MS

m/m

355 LTH 16x24 1985 I/O




SKETCH/AREA TABLE ADDENDUM

SUBJECT INFO

File No.: 560735 Parcel No.: 071E 07A 01300
 Property Address: 3818 STARLIGHT DRIVE
 City: SILVERTON County: MARION State: OR ZipCode: 97381
 Owner:
 Client: Client Address:
 Appraiser Name: Inspection Date:

SKETCH

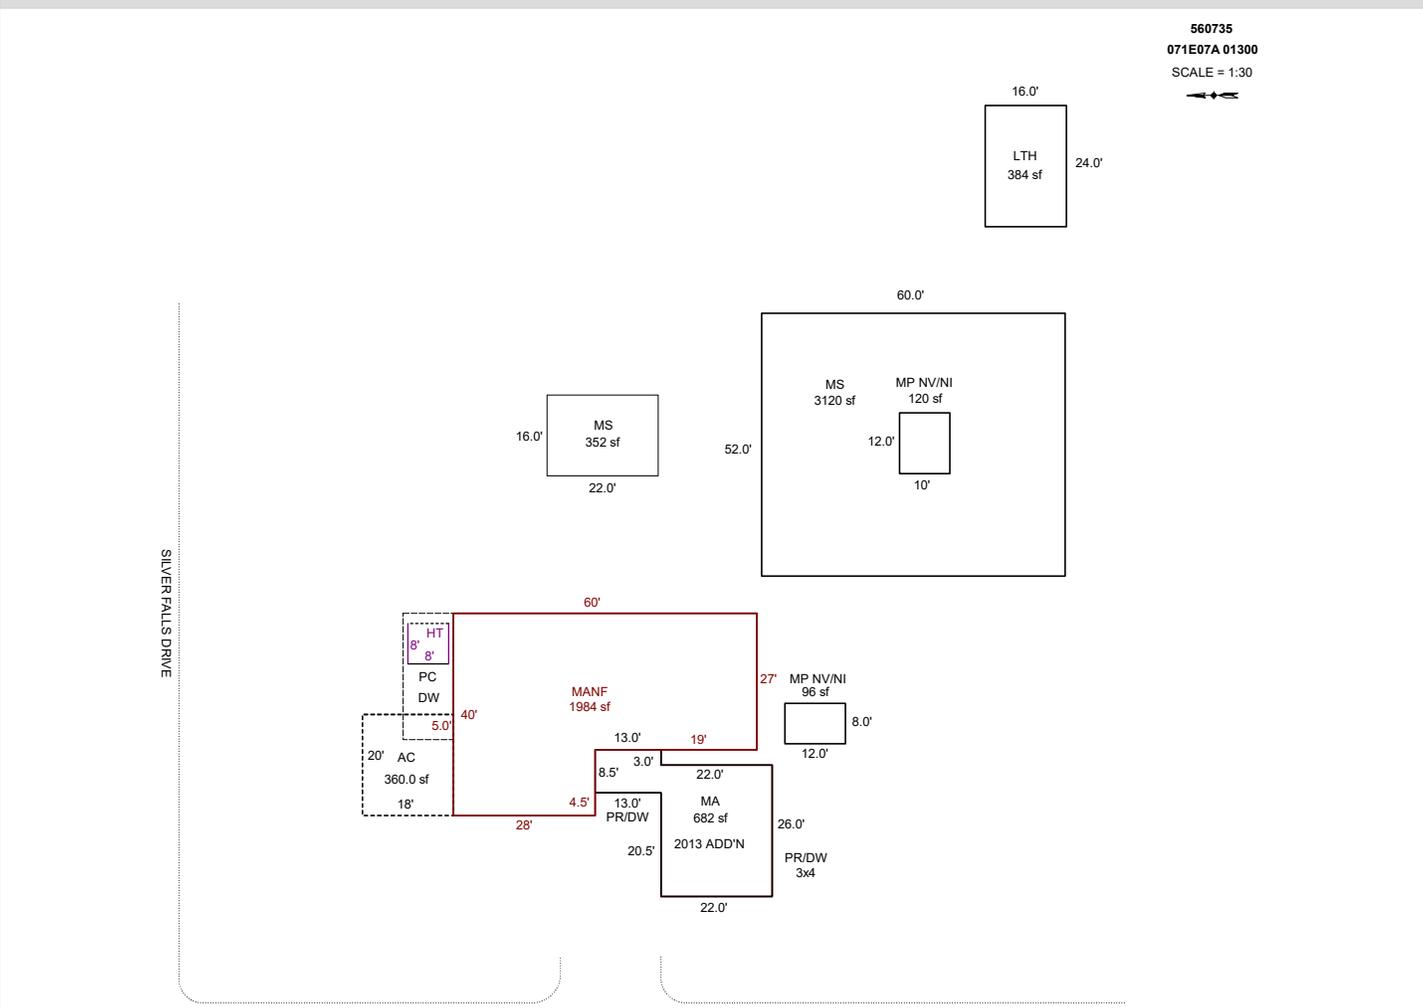

Sketch by ApexSketch

AREA CALCULATIONS SUMMARY						COMMENT TABLE 1	
Code	Description	Factor	Net Size	Perimeter	Net Totals		
GBA1	MS	1.0	3120.0	224.0		Apex 5/16/2011 Jane UPDATED BY SRAGSDALE 2/3/15 UPDATED BY CJURAN 12/18/2023 UPDATED BY CLOBERG 01/24/25 UPDATED BY CLOBERG 02/12/26	
	MS	1.0	352.0	76.0			
	MP NV/NI	1.0	120.0	44.0			
	MP NV/NI	1.0	96.0	40.0	3688.0		
	GLA1	MFS	1.0	2666.5	285.0		
GAR	AC	1.0	360.0	76.0	360.0		
LTH	LTH	1.0	384.0	80.0	384.0		
MA	MA	1.0	682.5	128.0	682.5		
MANF	MANF	1.0	1984.0	200.0	1984.0		
OTH	HT	1.0	64.0	32.0	64.0		
P/P	DF	1.0	250.0	70.0	250.0		
	Net LIVABLE	cnt	4	(rounded)	6,077		
	Net BUILDING	cnt	0	(rounded)	3,688		


COMMENT TABLE 2	COMMENT TABLE 3
1/30/15 #94, TAGS, VER CL 12/07/2023 MLH 01/15/25 MLH 10/24/25	TAGS L3 TAGS L1 TAGS L3

SKETCH/AREA TABLE ADDENDUM

SUBJECT INFO

File No.: 560735 Parcel No.: 071E 07A 01300
 Property Address: 3818 STARLIGHT DRIVE
 City: SILVERTON County: MARION State: OR ZipCode: 97381
 Owner:
 Client: Client Address:
 Appraiser Name: Inspection Date:

SKETCH

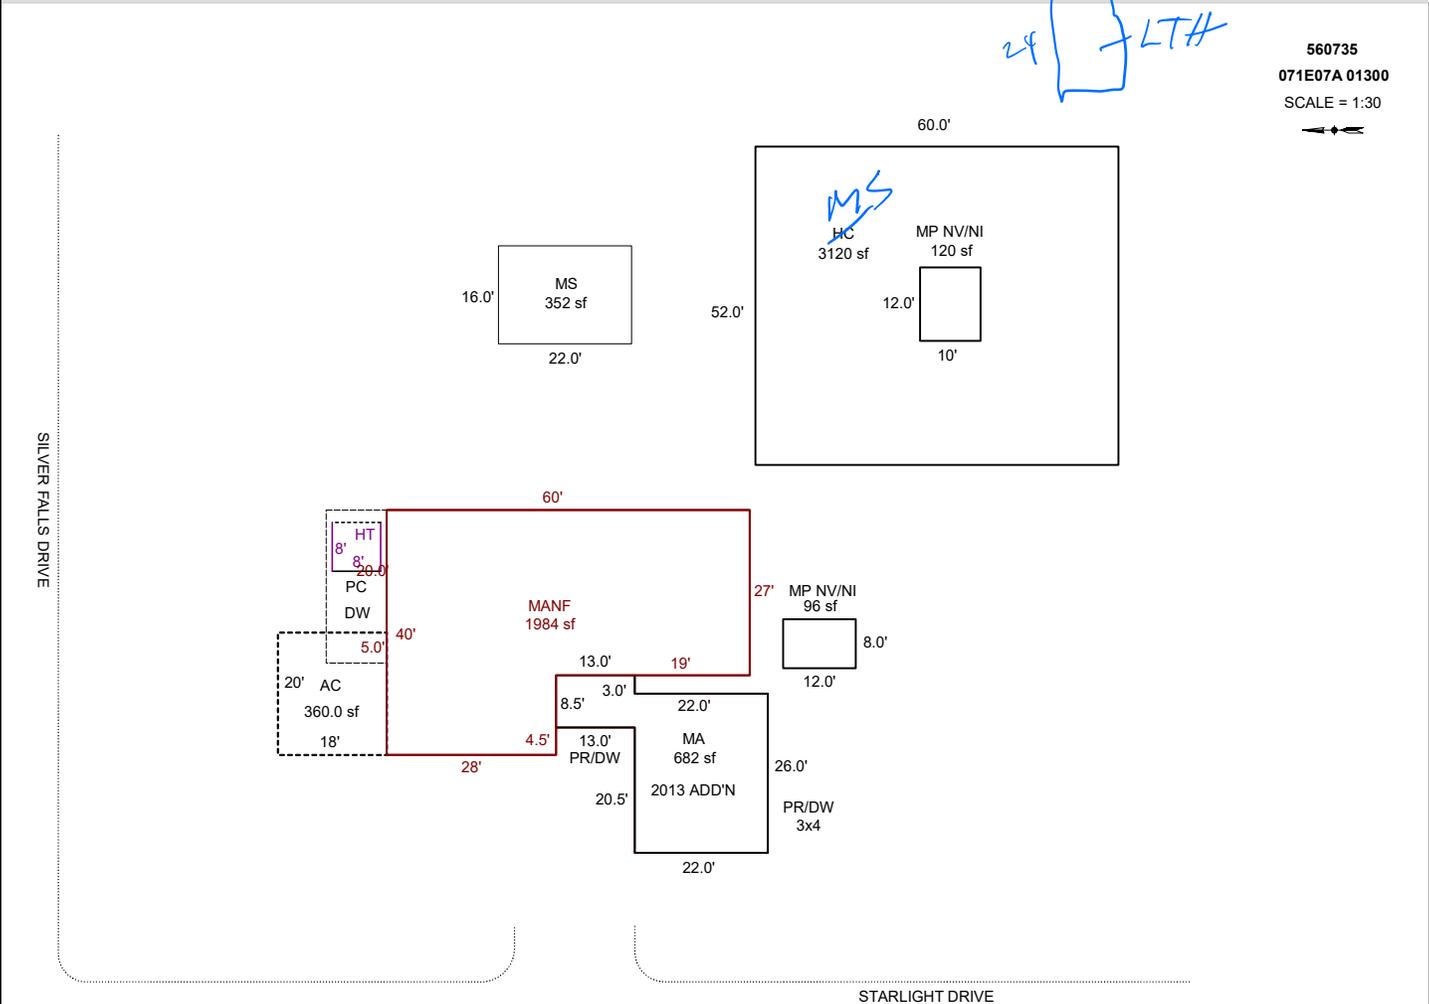

560735
 071E07A 01300
 SCALE = 1:30

Sketch by ApexSketch

AREA CALCULATIONS SUMMARY

Code	Description	Factor	Net Size	Perimeter	Net Totals
GBA1	HC	1.0	3120.0	224.0	
	MS	1.0	352.0	76.0	
	MP NV/NI	1.0	120.0	44.0	
	MP NV/NI	1.0	96.0	40.0	3688.0
GLA1	MFS	1.0	2666.5	285.0	2666.5
GAR	AC	1.0	360.0	76.0	360.0
MA	MA	1.0	682.5	128.0	682.5
MANF	MANF	1.0	1984.0	200.0	1984.0
OTH	HT	1.0	64.0	32.0	64.0
P/P	DF	1.0	250.0	70.0	250.0
	Net LIVABLE	cnt	2 (rounded)		5,333
	Net BUILDING	cnt	4 (rounded)		3,688

COMMENT TABLE 1

Apex 5/16/2011 Jane
 UPDATED BY SRAGSDALE 2/3/15
 UPDATED BY CJURAN 12/18/2023
 UPDATED BY CLOBERG 01/24/25

COMMENT TABLE 2

1/30/15 #94, TAGS, VER
 CL 12/07/2023
 MLH 01/15/25

MLH 10/24/25

COMMENT TABLE 3

TAGS L3
 TAGS L1

Tags L3