






SKETCH/AREA TABLE ADDENDUM

SUBJECT INFO

File No.: 510081 Parcel No.: 031W32A 01300
 Property Address: 24126 BUTTEVILLE RD NE
 City: AURORA County: MARION State: OR ZipCode: 97002
 Owner:
 Client:
 Appraiser Name: Client Address:
 Inspection Date:

SKETCH

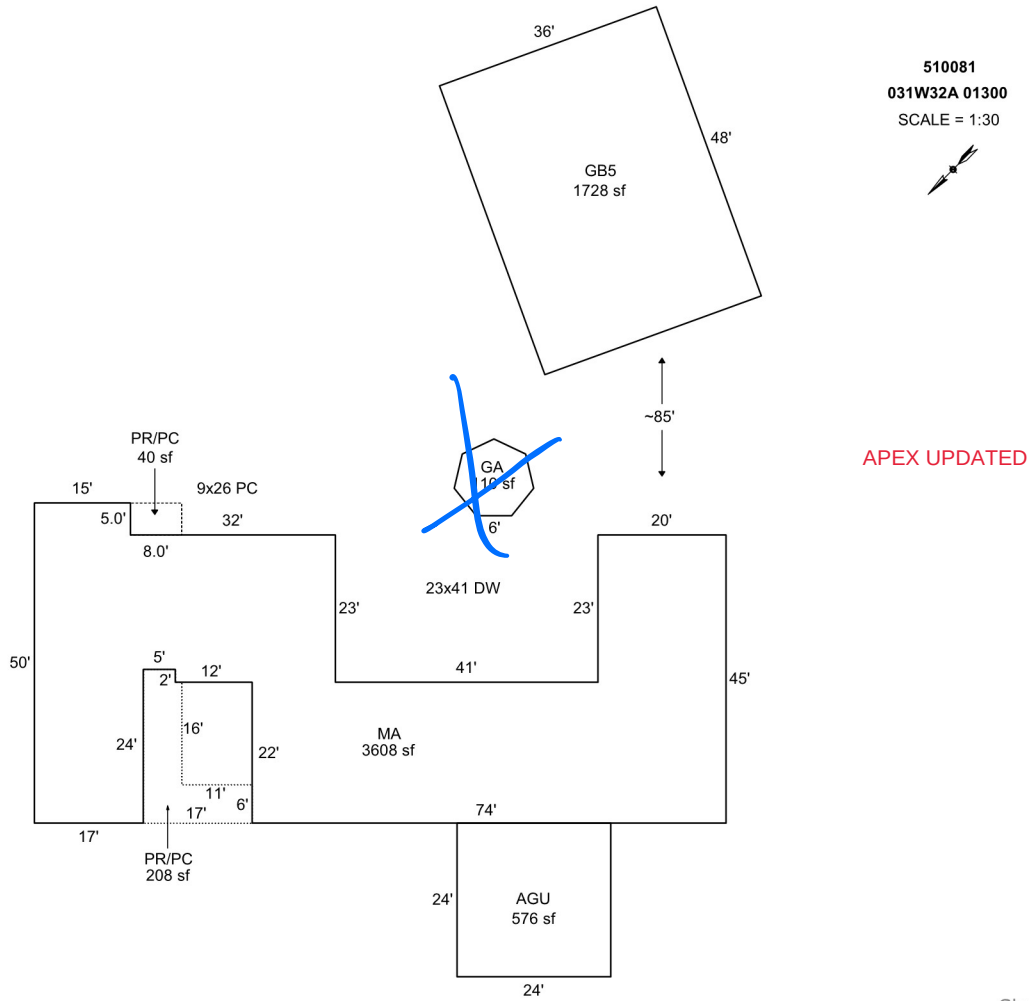

Sketch by Apex Sketch

AREA CALCULATIONS SUMMARY

Code	Description	Factor	Net Size	Perimeter	Net Totals
GBA1	GB5	1.0	1728.0	168.0	1728.0
GLA1	MA	1.0	3608.0	410.0	3608.0
GAR	AGU	1.0	576.0	96.0	576.0
P/P	PR/PC	1.0	40.0	26.0	40.0

COMMENT TABLE 1

Apex by AC 07/24/07
 UPDATED BY CJURAN 12/13/2023 23-009041 INT REM

COMMENT TABLE 2

LL 3-5-24

COMMENT TABLE 3

Tags JJS

Net LIVABLE cnt 1 (rounded) 3,608
 Net BUILDING cnt 1 (rounded) 1,728