

Rural Work Order Cover Sheet

RAM Transaction #: 608246

Year: 24 - 25

Account Numbers Involved: 518373 518374

Sequence #1: ACREAGE CORRECTION

Sequence #2: ACREAGE CORRECTION

Sequence #3: LOT LINE ADJUSTMENT FROM 518374 TO 518373

Sequence #4: LOT LINE ADJUSTMENT FROM 518374 TO 518373

Check For:					Forms Included:	
	Yes	No		Yes	No	✓
Move Building Permits	<input type="checkbox"/>	<input checked="" type="checkbox"/>	Fire Patrol (Email Supervisor)	<input type="checkbox"/>	<input checked="" type="checkbox"/>	RAM Report <input checked="" type="checkbox"/>
Move Photos	<input type="checkbox"/>	<input checked="" type="checkbox"/>	Multi-Section	<input type="checkbox"/>	<input checked="" type="checkbox"/>	Processing Forms <input checked="" type="checkbox"/>
Update Apex	<input type="checkbox"/>	<input checked="" type="checkbox"/>	Tagged for 2 nd year Reset	<input type="checkbox"/>	<input type="checkbox"/>	Before and After Maps <input checked="" type="checkbox"/>
Update Account Notes	<input checked="" type="checkbox"/>	<input type="checkbox"/>	Exemptions	<input type="checkbox"/>	<input type="checkbox"/>	Multi-Section Processing Form <input type="checkbox"/>
PAT LIAB	<input checked="" type="checkbox"/>	<input type="checkbox"/>	Update Tracker	<input type="checkbox"/>	<input type="checkbox"/>	Calculation Form(s) <input type="checkbox"/>

Miscellaneous Notes: PERMANENTLY DISQUALIFIED LAND INVOLVED

Appraiser: MLH Date: 8/22/24

Appraisal Review: WW Date: 8/22/24

Data Entry: Chris Date: 8/23/24

Tax Year	Account ID	MTL	Transaction	Vouc	Recorded Date	Transaction Comment	Operation	Voucher Notes	Code	+/- Size	Size
2024	518374	062W090000400	608246	1	2/28/2024 10:57	LOT LINE ADJUSTMENT & ACREAGE CORRECTIONS - SDB	SIZE CHANGE	ACREAGE CORRECTION	01410	1.06	A
2024	518373	062W090000500	608246	2	2/28/2024 10:57	LOT LINE ADJUSTMENT & ACREAGE CORRECTIONS - SDB	SIZE CHANGE	ACREAGE CORRECTION	01410	-0.06	A
2024	518374	062W090000400	608246	3	2/28/2024 10:57	LOT LINE ADJUSTMENT & ACREAGE CORRECTIONS - SDB	LOT LINE ADJUSTMENT - FROM	LOT LINE ADJUSTMENT FROM 518374 TO 518373	01410	-5	A
2024	518373	062W090000500	608246	4	2/28/2024 10:57	LOT LINE ADJUSTMENT & ACREAGE CORRECTIONS - SDB	LOT LINE ADJUSTMENT - TO	LOT LINE ADJUSTMENT FROM 518374 TO 518373	01410	5	A

Rural Work Order Processing Form

One Page Per Account

Sequence #: 1 of 4 Account Number: 518374 MTL: 062W090000400 RAM Transaction ID: 608246

Type: COM LLA PPT SEG SUB AC R of W Vacate Map Maintenance

Account Details

Ma Sa Nh: 04 06 000 Prop Class: 559 RMV Class: 509

Assigned Appraiser: MLH Part of Unit: Yes or No Fire Patrol: Yes or No

Land Fragment

Account From	Code Area	Liab Yr	Land Class	LUC	Value Source	# of Acres	Zone	Land Adjustments
518374	01410	2009		005	Farm Homesite	1.00	REST	
518374	01410	1976	2BI	005	Farm Use EFU	34.00	REST	GSOIL IRR
518374	01410	1976	4BI	005	Farm Use EFU	35.05	REST	IRR
518374	01410	2024	4BI	005	Farm Use EFU	1.06	REST	IRR

Total Acres: 71.11

Improvements

Account From	Code Area	Imp ID	Stat Class	Description	Account From	Code Area	Imp ID	Stat Class	Description
No Changes									

Adjustments: _____

Exception

New MAV: _____ Sys Calc No Change to MAV

Rural Work Order Processing Form

One Page Per Account

Sequence #: 2 of 4 Account Number: 518373 MTL: 062W090000500 RAM Transaction ID: 608246

Type: COM LLA PPT SEG SUB AC R of W Vacate Map Maintenance

Account Details

Ma Sa Nh: 04 06 000 Prop Class: 459 RMV Class: 459

Assigned Appraiser: MLH Part of Unit: Yes or No Fire Patrol: Yes or No

Land Fragment

Account From	Code Area	Liab Yr	Land Class	LUC	Value Source	# of Acres	Zone	Land Adjustments
518373	01410			005	Permanently Disqualified	0.94	REST	

Total Acres: 0.94

Improvements

Account From	Code Area	Imp ID	Stat Class	Description	Account From	Code Area	Imp ID	Stat Class	Description
No Changes									

Adjustments: _____

Exception

New MAV: _____ Sys Calc No Change to MAV

Rural Work Order Processing Form

One Page Per Account

Sequence #: 3 of 4 Account Number: 518374 MTL: 062W090000400 RAM Transaction ID: 608246

Type: COM LLA PPT SEG SUB AC R of W Vacate Map Maintenance

Account Details

Ma Sa Nh: 04 06 000 Prop Class: 559 RMV Class: 509

Assigned Appraiser: MLH Part of Unit: Yes or No Fire Patrol: Yes or No

Land Fragment

Account From	Code Area	Liab Yr	Land Class	LUC	Value Source	# of Acres	Zone	Land Adjustments
518374	01410	2009		005	Farm Homesite	1.00	REST	
518374	01410	1976	2BI	005	Farm Use EFU	32.37	REST	GSOIL IRR
518374	01410	1976	4BI	005	Farm Use EFU	31.68	REST	IRR
518374	01410	2024	4BI	005	Farm Use EFU	1.06	REST	IRR

Total Acres: 66.11

Improvements

Account From	Code Area	Imp ID	Stat Class	Description	Account From	Code Area	Imp ID	Stat Class	Description
NO CHANGES									

Adjustments: _____

Exception

New MAV: _____ Sys Calc No Change to MAV

Rural Work Order Processing Form

One Page Per Account

Sequence #: 4 of 4 Account Number: 518373 MTL: 062W090000500 RAM Transaction ID: 608246

Type: COM LLA PPT SEG SUB AC R of W Vacate Map Maintenance

Account Details

Ma Sa Nh: 04 06 000 Prop Class: 459 RMV Class: 459

Assigned Appraiser: MLH Part of Unit: Yes or No Fire Patrol: Yes or No

Land Fragment

Account From	Code Area	Liab Yr	Land Class	LUC	Value Source	# of Acres	Zone	Land Adjustments
518373	01410			005	Permanently Disqualified	0.94	REST	
518374	01410	1976	2BI	005	Farm Use EFU	1.63	REST	GSOIL IRR
518374	01410	1976	4BI	005	Farm Use EFU	3.37	REST	IRR

Total Acres: 5.94

Improvements

Account From	Code Area	Imp ID	Stat Class	Description	Account From	Code Area	Imp ID	Stat Class	Description
NO CHANGES									

Adjustments: _____

Exception

New MAV: _____ Sys Calc No Change to MAV

06 2W 09

06 2W 09



MARION COUNTY, OREGON

SEC 9 T6S R2W W.M.
SCALE 1" = 400'

LEGEND

- LINE TYPES**
- Taxlot Boundary
 - Road Right-of-Way
 - Railroad Right-of-Way
 - Private Road ROW
 - Subdivision/Plat Boundary
 - Waterline - Taxlot Boundary
 - Waterline - Non Boundary
 - Historical Boundary
 - Easement
 - Railroad Centerline
 - Taxcode Line
 - Map Boundary

- CORNER TYPES**
- + 1/4 Section Cor.
 - ⊙ DIC Corner
 - ⊕ 1/4 Section Cor.
 - ⊕ 16 1/2 Section Corner
 - ⊕ 21 22

NUMBERS
Tax Code Number
00000

ACREAGE
All acres listed are Net Acres, excluding any portions of the taxlot within public ROWs
0.25 AC

NOTES
Tick Marks: A tick mark in the road indicates that the labeled dimension extends into the public ROW

CANCELLED NUMBERS


DISCLAIMER: THIS MAP WAS PREPARED FOR ASSESSMENT PURPOSES ONLY



FOR ADDITIONAL MAPS VISIT OUR WEBSITE AT www.co.marion.or.us

PLOT DATE: 8/22/2024

06 2W 09

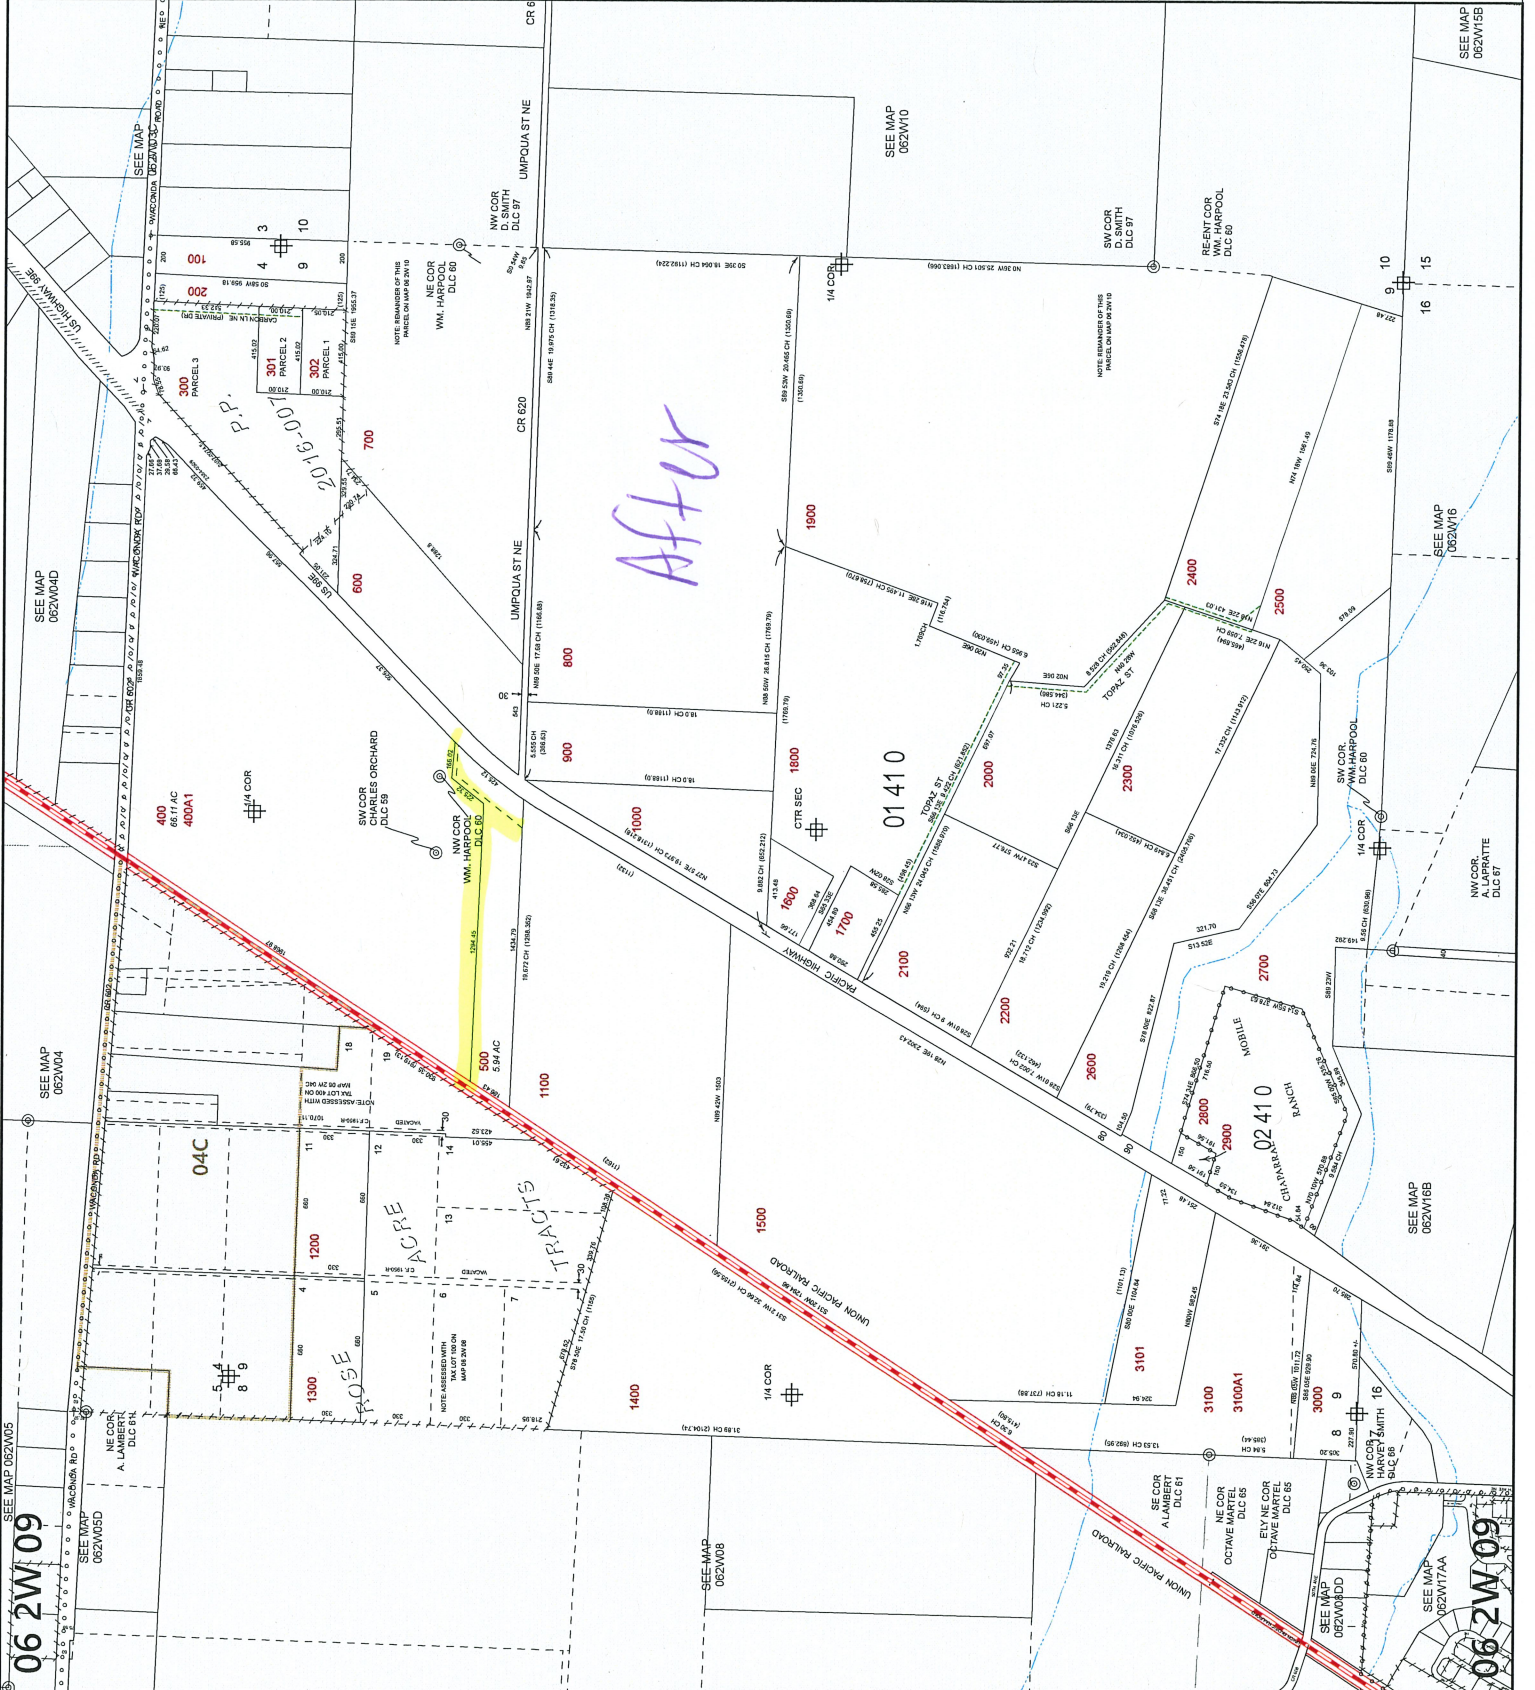



MARION COUNTY, OREGON
SEC 9 T6S R2W W.M.
SCALE 1" = 400'

LEGEND

- LINE TYPES**
- Taxlot Boundary
 - Road Right-of-Way
 - Railroad Right-of-Way
 - Private Road ROW
 - Subdivision/Plat Boundary
 - Waterline - Taxlot Brndy
 - Waterline - Non Brndy
 - Historical Boundary
 - Easement
 - Railroad Centerline
 - Taxcode Line
 - Map Boundary
 - Waterline - Non Brndy
- CORNER TYPES**
- + 1/4th Section Cor.
 - ⊙ DIC Corner
 - ⊕ 1/4 Section Cor.
 - ⊕ 16 1/2 Section Corner
 - ⊕ 21 22
- NUMBERS**
- Tax Code Number
00000
- Acreage
0.25 AC
- All acres listed are Net Acres, excluding any portions of the taxlot within public ROWs
- NOTES**
- Tick Marks: A tick mark in the road indicates that the labeled dimension extends into the public ROW

CANCELLED NUMBERS

DISCLAIMER: THIS MAP WAS PREPARED FOR ASSESSMENT PURPOSES ONLY



FOR ADDITIONAL MAPS VISIT OUR WEBSITE AT www.marion.or.us

PLOT DATE: 10/16/2020

