

Rural Work Order Cover Sheet

RAM Transaction #: 609410 1 OF 2

Year: 24 - 25

Account Numbers Involved: 533448, 533449, 533450

Sequence #1-2: RE-TAXLOTTED FROM 08-3W-36C-01800 TO 08-3W-36-01400.

Sequence #3: 533448 COMBINED INTO 533449 FOR MAPPING PURPOSES. ACREAGE SET TO ZERO IN PREPARATION OF CANCELLATION. -44.63

Sequence #4: 533448 COMBINED INTO 533449 FOR MAPPING PURPOSES. +44.63

Sequence #5: ACREAGE CORRECTION PER DEED AND MCSR 39994. -0.62 533449

Sequence #6: ADJUSTMENT FROM 533449 TO 533450. MARION COUNTY PROPERTY LINE ADJUSTMENT CASE NO.

23-036. -6.76 533449

Sequence #7: ADJUSTMENT FROM 533449 TO 533450. MARION COUNTY PROPERTY LINE ADJUSTMENT CASE NO.

23-036. +6.76 533450

	Check For:			Check For:		Forms Included:	
	Yes	No		Yes	No		✓
Move Building Permits	<input checked="" type="checkbox"/>	<input type="checkbox"/>	Fire Patrol (Email Supervisor)	<input type="checkbox"/>	<input checked="" type="checkbox"/>	RAM Report	<input checked="" type="checkbox"/>
Move Photos	<input checked="" type="checkbox"/>	<input type="checkbox"/>	Multi-Section	<input type="checkbox"/>	<input checked="" type="checkbox"/>	Processing Forms	<input checked="" type="checkbox"/>
Update Apex	<input checked="" type="checkbox"/>	<input type="checkbox"/>	Tagged for 2 nd year Reset	<input type="checkbox"/>	<input checked="" type="checkbox"/>	Before and After Maps	<input checked="" type="checkbox"/>
Update Account Notes	<input checked="" type="checkbox"/>	<input type="checkbox"/>	Exemptions	<input type="checkbox"/>	<input checked="" type="checkbox"/>	Multi-Section Processing Form	<input type="checkbox"/>
PAT LIAB	<input type="checkbox"/>	<input checked="" type="checkbox"/>	Update Tracker	<input checked="" type="checkbox"/>	<input type="checkbox"/>	Calculation Form(s)	<input type="checkbox"/>

Miscellaneous Notes: SEQ 1-2 HAVE NO ACTION

533448 READY TO CANCEL

Appraiser: WW Date: 7/3/24

Appraisal Review: WW Date: 7/3/24

Data Entry: Chris Date: 7/9/24

Tax Year	Account ID	MTL	Transaction	Vou	Recorded Date	Transaction Comment	Operation	Voucher Notes	Code	+/- Size	Size
2024	533450	083W36C001800	609410	1	3/22/2024 11:22	LOT LINE ADJUSTMENT 1 OF 2 WITH COMBINATION FOR MAPPING PURPOSES PRIOR TO AND ACREAGE CORRECTION - JMS	RETAXLOTTING - FROM	RE-TAXLOTTED FROM 08-3W-36C-01800 TO 08-3W-36-01400.			
2024	533450	083W360001400	609410	2	3/22/2024 11:22	LOT LINE ADJUSTMENT 1 OF 2 WITH COMBINATION FOR MAPPING PURPOSES PRIOR TO AND ACREAGE CORRECTION - JMS	RETAXLOTTING - TO	RE-TAXLOTTED FROM 08-3W-36C-01800 TO 08-3W-36-01400.			
2024	533448	083W360000700	609410	3	3/22/2024 11:22	LOT LINE ADJUSTMENT 1 OF 2 WITH COMBINATION FOR MAPPING PURPOSES PRIOR TO AND ACREAGE CORRECTION - JMS	COMBINATION - FROM	533448 COMBINED INTO 533449 FOR MAPPING PURPOSES. ACREAGE SET TO ZERO IN PREPARATION OF CANCELLATION.	92590	-44.63	A
2024	533449	083W360000600	609410	4	3/22/2024 11:22	LOT LINE ADJUSTMENT 1 OF 2 WITH COMBINATION FOR MAPPING PURPOSES PRIOR TO AND ACREAGE CORRECTION - JMS	COMBINATION - TO	533448 COMBINED INTO 533449 FOR MAPPING PURPOSES.	92590	44.63	A
2024	533449	083W360000600	609410	5	3/22/2024 11:22	LOT LINE ADJUSTMENT 1 OF 2 WITH COMBINATION FOR MAPPING PURPOSES PRIOR TO AND ACREAGE CORRECTION - JMS	SIZE CHANGE	ACREAGE CORRECTION PER DEED AND MCSR 39994.	92590	-0.62	A
2024	533449	083W360000600	609410	6	3/22/2024 11:22	LOT LINE ADJUSTMENT 1 OF 2 WITH COMBINATION FOR MAPPING PURPOSES PRIOR TO AND ACREAGE CORRECTION - JMS	LOT LINE ADJUSTMENT - FROM	ADJUSTMENT FROM 533449 TO 533450. MARION COUNTY PROPERTY LINE ADJUSTMENT CASE NO. 23-036.	92590	-6.76	A
2024	533450	083W360001400	609410	7	3/22/2024 11:22	LOT LINE ADJUSTMENT 1 OF 2 WITH COMBINATION FOR MAPPING PURPOSES PRIOR TO AND ACREAGE CORRECTION - JMS	LOT LINE ADJUSTMENT - TO	ADJUSTMENT FROM 533449 TO 533450. MARION COUNTY PROPERTY LINE ADJUSTMENT CASE NO. 23-036.	92590	6.76	A

Rural Work Order Processing Form

One Page Per Account

1-
 Sequence #: 4 of 7 Account Number: 533449 MTL: 083W360000600 RAM Transaction ID: 609410

Type: COM LLA PPT SEG SUB AC R of W Vacate Map Maintenance

Account Details

Ma Sa Nh: 0706000 Prop Class: 581 RMV Class: 581
 Assigned Appraiser: MLORD Part of Unit: Yes or No Fire Patrol: Yes or No

Land Fragment

Account From	Code Area	Liab Yr	Land Class	LUC	Value Source	# of Acres	Zone	Land Adjustments
533449	92590	1983	6H	005	FARM USE – EFU	6.10	REST	FSOIL
533449	92590	2009		005	FOREST HOMESITE	1.0	REST	EXCELLENT VIEW
533449	92590	1968	STFC	005	SMALL TRACT FOREST	3.0	REST	
533449	92590				SA OSDA			
533448	92590	1983	STFC	005	SMALL TRACT FOREST	44.63	REST	

Total Acres: 54.73

Improvements

Account From	Code Area	Imp ID	Stat Class	Description	Account From	Code Area	Imp ID	Stat Class	Description
				NO CHANGE					

Adjustments: _____

Exception

New MAV: _____ Sys Calc No Change to MAV

Rural Work Order Processing Form

One Page Per Account

Sequence #: 5 of 7 Account Number: 533449 MTL: 083W360000600 RAM Transaction ID: 609410

Type: COM LLA PPT SEG SUB AC R of W Vacate Map Maintenance

Account Details

Ma Sa Nh: 0706000 Prop Class: 581 RMV Class: 581

Assigned Appraiser: MLORD Part of Unit: Yes or No Fire Patrol: Yes or No

Land Fragment

Account From	Code Area	Liab Yr	Land Class	LUC	Value Source	# of Acres	Zone	Land Adjustments
533449	92590	1983	6H	005	FARM USE – EFU	5.48	REST	FSOIL
533449	92590	2009		005	FOREST HOMESITE	1.0	REST	EXCELLENT VIEW
533449	92590	1968	STFC	005	SMALL TRACT FOREST	3.0	REST	
533449	92590				SA OSDA			
533449	92590	1983	STFC	005	SMALL TRACT FOREST	44.63	REST	

Total Acres: 54.11

Improvements

Account From	Code Area	Imp ID	Stat Class	Description	Account From	Code Area	Imp ID	Stat Class	Description
				NO CHANGE					

Adjustments: _____

Exception

New MAV: _____ Sys Calc No Change to MAV

Rural Work Order Processing Form

One Page Per Account

Sequence #: 6 of 7 Account Number: 533449 MTL: 083W360000600 RAM Transaction ID: 609410

Type: COM LLA PPT SEG SUB AC R of W Vacate Map Maintenance

Account Details

Ma Sa Nh: 0706000 Prop Class: 550 RMV Class: 450

Assigned Appraiser: MLORD Part of Unit: Yes or No Fire Patrol: Yes or No

Land Fragment

Account From	Code Area	Liab Yr	Land Class	LUC	Value Source	# of Acres	Zone	Land Adjustments
533449	92590	1968	STFC	005	SMALL TRACT FOREST	2.72	REST	
533449	92590				SA-OSDA			
533449	92590	1983	STFC	005	SMALL TRACT FOREST	44.63	REST	

Total Acres: 47.35

Improvements

Account From	Code Area	Imp ID	Stat Class	Description	Account From	Code Area	Imp ID	Stat Class	Description
				ALL MOVING					

Adjustments: _____

Exception

New MAV: 0 Sys Calc No Change to MAV

Rural Work Order Processing Form

One Page Per Account

Sequence #: 7 of 7 Account Number: 533450 MTL: 083W360001400 RAM Transaction ID: 609410

Type: COM LLA PPT SEG SUB AC R of W Vacate Map Maintenance

Account Details

Ma Sa Nh: 07/06/000 Prop Class: 581 RMV Class: 451

Assigned Appraiser: MLORD Part of Unit: Yes or No Fire Patrol: Yes or No

Land Fragment

Account From	Code Area	Liab Yr	Land Class	LUC	Value Source	# of Acres	Zone	Land Adjustments
533450	92590	1983	4HD	005	FARM USE – EFU	1.33	REST	
533449	92590	1968	STFC	005	SMALL TRACT FOREST	0.28	REST	
533449	92590	1983	6H	005	FARM USE – EFU	5.48	REST	FSOIL
533449	92590	2009		005	FOREST HOMESITE	1.0	REST	EXCELLENT VIEW
<u>533449</u>	<u>92590</u>				<u>SA OSDA</u>			

Total Acres: 8.09

Improvements

Account From	Code Area	Imp ID	Stat Class	Description	Account From	Code Area	Imp ID	Stat Class	Description
533449	92590	1	154	MULTI STORY/BMS					
533449	92590	2	341	MP					

Adjustments: _____

Exception

New MAV: 268,860 Sys Calc No Change to MAV

08 3W 36C

08 3W 36C

08 3W 36C

08 3W 36C



MARION COUNTY, OREGON
SW 1/4 SEC 36 T8S R3W W.M.
SCALE 1" = 200'

LEGEND

- LINE TYPES**
- Tablot Boundary
 - Road Right-of-Way
 - Railroad Right-of-Way
 - Private Road ROW
 - Subdivision/Plat Boundary
 - Waterline - Taxlot Boundary
 - Waterline - Non Boundary
 - Historical Boundary
 - Easement
 - Railroad Centerline
 - Taxcode Line
 - Map Boundary
- CORNER TYPES**
- + 1/16th Section Cor.
 - @ DIC Corner
 - ⊕ 1/4 Section Cor.
 - ⊕ 1/2 Section Corner
 - ⊕ 2/3 Section Corner
- NUMBERS**
- Tax Code Number
00000
- Acreage All acres listed are Net Acres, excluding any portions of the tablot within public ROWs
- NOTES**
- Tick Marks: A tick mark in the road indicates that the labeled dimension extends into the public ROW


CANCELLED NUMBERS	
299	
301	
1101	
1201	
1201A1	

DISCLAIMER: THIS MAP WAS PREPARED FOR ASSESSMENT PURPOSES ONLY



FOR ADDITIONAL MAPS VISIT OUR WEBSITE AT www.co.marion.or.us

PLOT DATE: 2/3/2022

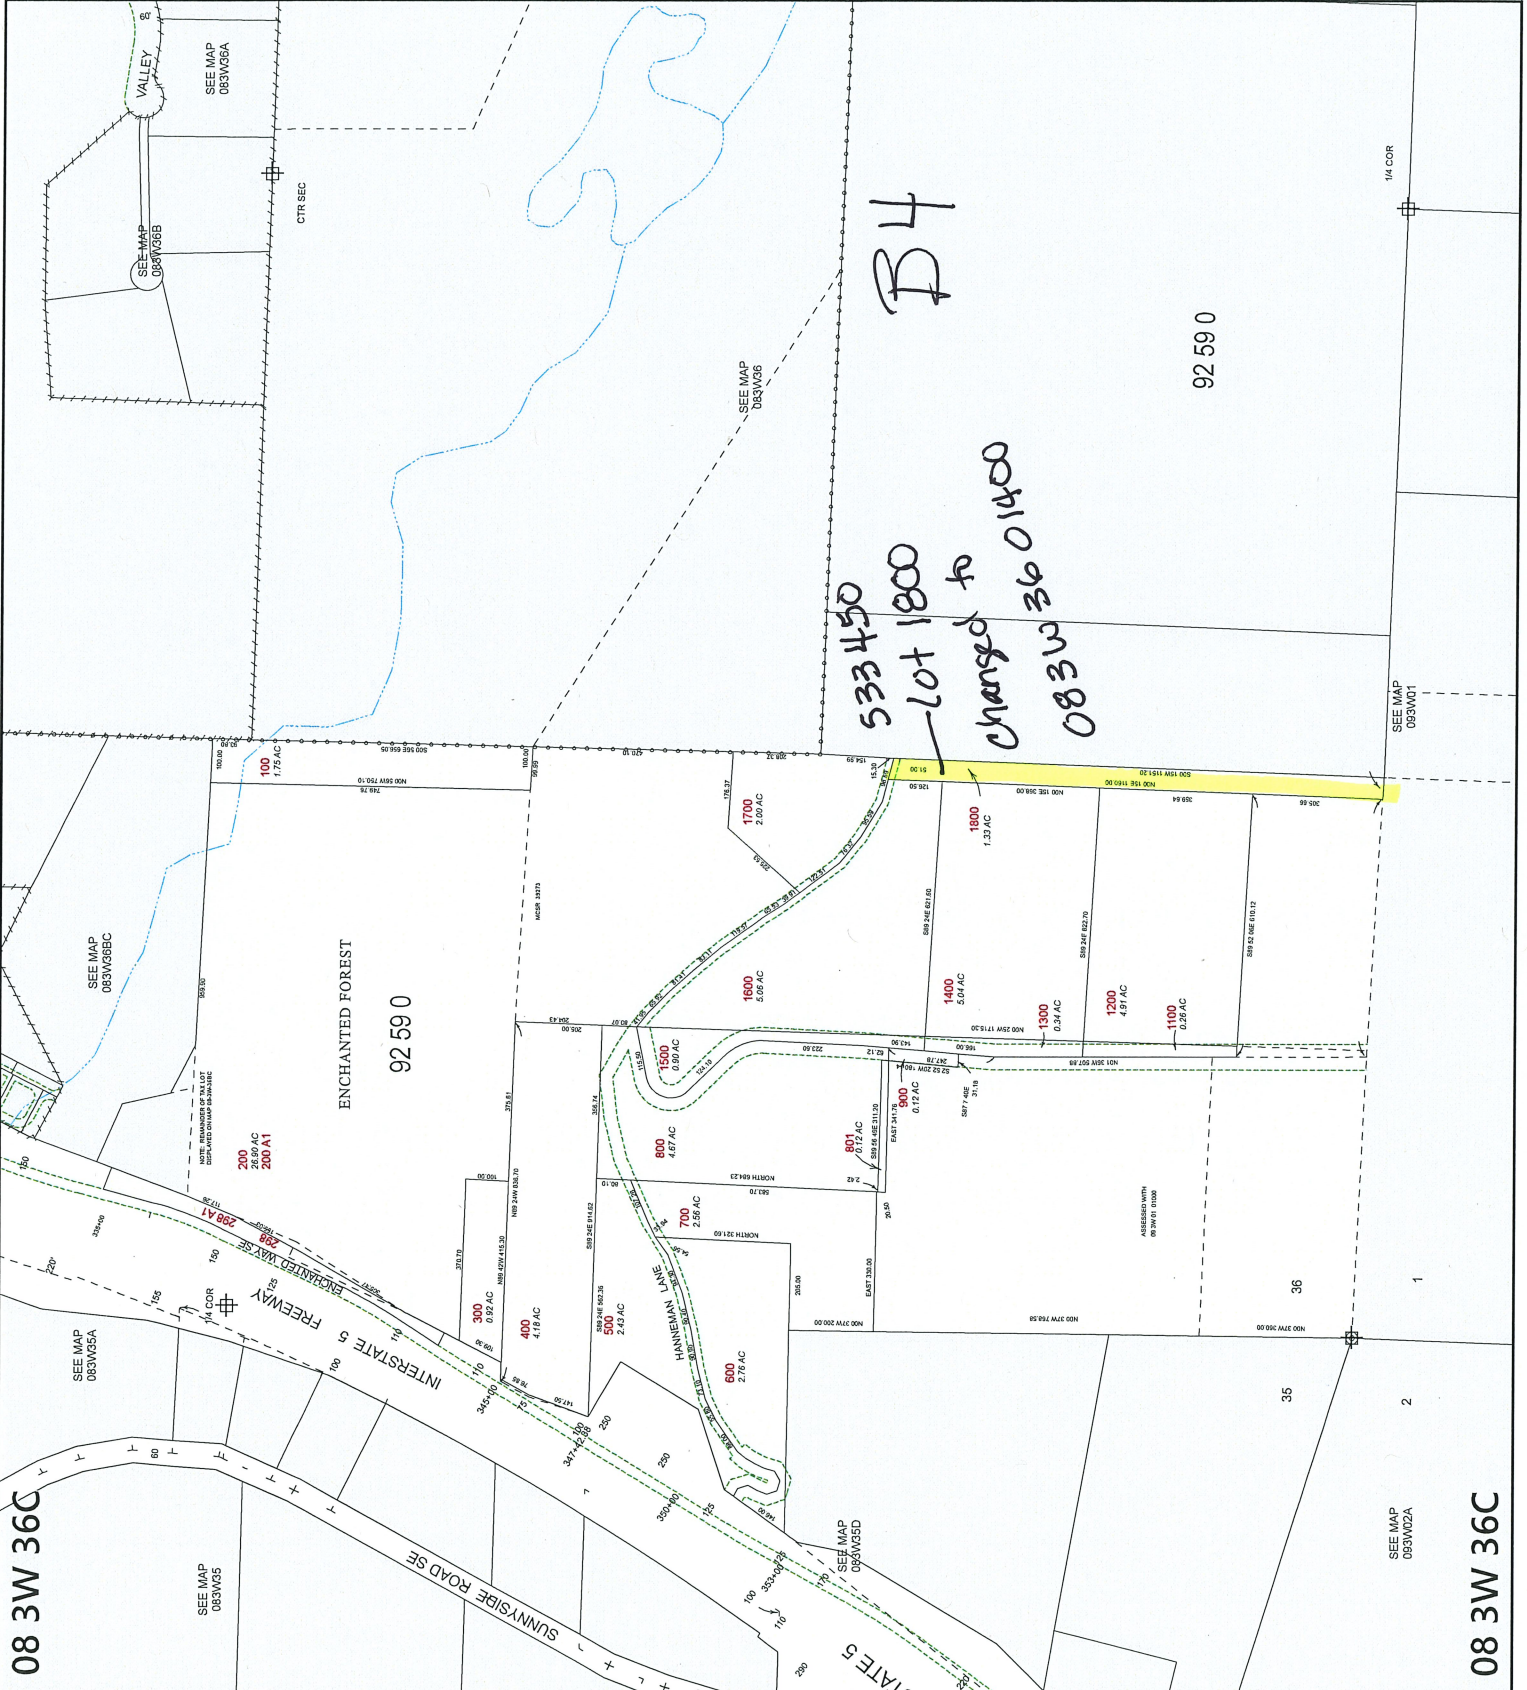

SEE MAP 083W02A

SEE MAP 083W01














SEC 36 T8S R3W W.M.
SCALE 1" = 400'

LEGEND

- LINE TYPES**
- Taxlot Boundary
 - Historical Boundary
 - Road Right-of-Way
 - Railroad Right-of-Way
 - Private Road ROW
 - Subdivision/Plat Boundary
 - Waterline - Taxlot Bndry
 - Waterline - Non Bndry
 - Easement
 - Railroad Centerline
 - Traverse Line
 - Map Boundary
 - Waterline - Non Bndry
- CORNER TYPES**
- + 1/6TH Section Cor.
 - ⊕ 1/4 Section Cor.
 - ⊙ D/C Corner
 - ⊕ 16.15' Section Corner
 - ⊕ 21.22' Section Corner
- NUMBERS**
- Tax Code Number
 - 00 000
- Acreage
0.25 AC
- NOTES**
- Tick Marks: A tick mark in the road indicates that the labeled dimension extends into the public ROW

CANCELLED NUMBERS	
303	
401	
700	

DISCLAIMER: THIS MAP WAS PREPARED FOR ASSESSMENT PURPOSES ONLY



FOR ADDITIONAL MAPS VISIT OUR WEBSITE AT www.co.marion.or.us

PLOT DATE: 7/2/2024

