

# Rural Work Order Cover Sheet

RAM Transaction #: 613367

Year: 24 - 25

Account Numbers Involved: 537769 609706

Sequence #1: ACREAGE CORRECTION OF -0.01 ACRE ON 537769 PER PLAT

Sequence #2: PARTITION PLAT PER MARION COUNY PARTIITON CASE 23-024. 609706 SEGREGATED OUT OF 537769

Sequence #3: PARTITION PLAT PER MARION COUNY PARTIITON CASE 23-024. 609706 SEGREGATED OUT OF 537769

	Check For:				Forms Included:	
	Yes	No		Yes	No	✓
Move Building Permits	<input type="checkbox"/>	<input checked="" type="checkbox"/>	Fire Patrol (Email Supervisor)	<input checked="" type="checkbox"/>	<input type="checkbox"/>	RAM Report <input checked="" type="checkbox"/>
Move Photos	<input type="checkbox"/>	<input checked="" type="checkbox"/>	Multi-Section	<input type="checkbox"/>	<input checked="" type="checkbox"/>	Processing Forms <input checked="" type="checkbox"/>
Update Apex	<input type="checkbox"/>	<input checked="" type="checkbox"/>	Tagged for 2 <sup>nd</sup> year Reset	<input type="checkbox"/>	<input checked="" type="checkbox"/>	Before and After Maps <input checked="" type="checkbox"/>
Update Account Notes	<input checked="" type="checkbox"/>	<input type="checkbox"/>	Exemptions	<input type="checkbox"/>	<input checked="" type="checkbox"/>	Multi-Section Processing Form <input type="checkbox"/>
PAT LIAB	<input type="checkbox"/>	<input checked="" type="checkbox"/>	Update Tracker	<input checked="" type="checkbox"/>	<input type="checkbox"/>	Calculation Form(s) <input type="checkbox"/>

Miscellaneous Notes: Not enough acres for STF

Appraiser: MLH Date: 6/18/24

Appraisal Review: WW Date: 6/18/24

Data Entry: Chris Date: 6/28/24

Size ID	Tax Year	Account ID	MTL	Transaction	Vouc	Recorded Date	Transaction Comment	Operation	Voucher Notes	Code	+/- Size	Size
554407	2024	537769	061E280001000	613367	1	5/13/2024 16:08	PARTITION PLAT CGV	SIZE CHANGE	ACREAGE CORRECTION PER PLAT	4500	-0.01	A
554408	2024	537769	061E280001000	613367	2	5/13/2024 16:08	PARTITION PLAT CGV	PARTITION PLAT - FROM	PARTITION PLAT PER MARION COUNTY PARTITION CASE 23-024. 609706 SEGREGATED OUT OF 537769	4500	-2.99	A
554409	2024	609706	061E280001001	613367	3	5/13/2024 16:08	PARTITION PLAT CGV	PARTITION PLAT - TO	PARTITION PLAT PER MARION COUNTY PARTITION CASE 23-024. 609706 SEGREGATED OUT OF 537769	4500	2.99	A

# Rural Work Order Processing Form

One Page Per Account

Sequence #: 1 of 3 Account Number: 537769 MTL: 061E280001000 RAM Transaction ID: 613367

Type:  COM  LLA  PPT  SEG  SUB  AC  R of W  Vacate  Map Maintenance

## Account Details

Ma Sa Nh: 03 06 002 Prop Class: 660 RMV Class: 400

Assigned Appraiser: MLH Part of Unit: Yes  or No  Fire Patrol: Yes  or No

## Land Fragment

Account From	Code Area	Liab Yr	Land Class	LUC	Value Source	# of Acres	Zone	Land Adjustments
537769	04500	1971	STFC	004	Small Tract Forest Land	1.47	NREST	GSOIL
537769	04500	1971	STFF	004	Small Tract Forest Land	3.40	NREST	FSOIL

Total Acres: 4.87

## Improvements

Account From	Code Area	Imp ID	Stat Class	Description	Account From	Code Area	Imp ID	Stat Class	Description
NONE									

Adjustments: \_\_\_\_\_

## Exception

New MAV: \_\_\_\_\_  Sys Calc  No Change to MAV

# Rural Work Order Processing Form

One Page Per Account

Sequence #: 2 of 3 Account Number: 537769 MTL: 061E280001000 RAM Transaction ID: 613367

Type:  COM  LLA  PPT  SEG  SUB  AC  R of W  Vacate  Map Maintenance

## Account Details

Ma Sa Nh: 03 06 002 Prop Class: 660 RMV Class: 400

Assigned Appraiser: MLH Part of Unit: Yes  or No  Fire Patrol: Yes  or No

## Land Fragment

Account From	Code Area	Liab Yr	Land Class	LUC	Value Source	# of Acres	Zone	Land Adjustments
537769	04500	1971	STFF	004	Small Tract Forest Land	1.88	NREST	FSOIL

Total Acres: 1.88

## Improvements

Account From	Code Area	Imp ID	Stat Class	Description	Account From	Code Area	Imp ID	Stat Class	Description
NONE									

Adjustments: \_\_\_\_\_

## Exception

New MAV: \_\_\_\_\_  Sys Calc  No Change to MAV



# Rural Work Order Processing Form

One Page Per Account

Sequence #: 3 of 3 Account Number: 609706 MTL: 061E280001001 RAM Transaction ID: 613367

Type:  COM  LLA  PPT  SEG  SUB  AC  R of W  Vacate  Map Maintenance

## Account Details

Ma Sa Nh: 03 06 002 Prop Class: 660 RMV Class: 400

Assigned Appraiser: MLH Part of Unit: Yes  or No  Fire Patrol: Yes  or No

## Land Fragment

Account From	Code Area	Liab Yr	Land Class	LUC	Value Source	# of Acres	Zone	Land Adjustments
537769	04500	1971	STFC	004	Small Tract Forest Land	1.47	NREST	GSOIL
537769	04500	1971	STFF	004	Small Tract Forest Land	1.52	NREST	FSOIL

Total Acres: 2.99

## Improvements

Account From	Code Area	Imp ID	Stat Class	Description	Account From	Code Area	Imp ID	Stat Class	Description
NONE									

Adjustments: \_\_\_\_\_

## Exception

New MAV: \_\_\_\_\_  Sys Calc  No Change to MAV

06 1E 28

06 1E 28



**MARION COUNTY, OREGON**  
SEC 28 T6S R1E W.M.  
SCALE 1" = 400'

**LEGEND**

**LINE TYPES**

- Taxlot Boundary - - - - -
- Road Right-of-Way - - - - -
- Railroad Right-of-Way - - - - -
- Private Road ROW - - - - -
- Subdivision/Plat Boundary - - - - -
- Waterline - Taxlot Boundary - - - - -
- Waterline - Non Bindry - - - - -
- Historical Boundary - - - - -
- Easement - - - - -
- Railroad Centerline - - - - -
- Tweeds Line - - - - -
- Map Boundary - - - - -

**CORNER TYPES**

- + 1/16TH Section Cor.
- ⊕ 1/4 Section Cor.
- ⊙ D/C Corner
- ⊕ 16', 15" Section Corner
- ⊕ 21', 22" Section Corner

**NUMBERS**

Tax Code Number  
**00 00 0**

All acres listed are Net Acres, excluding any portions of the taxlot within public ROWs.

**NOTES**  
Tick Marks: A tick mark in the road indicates that the labeled dimension extends into the public ROW.

CANCELLED NUMBERS
401

DISCLAIMER: THIS MAP WAS PREPARED FOR ASSESSMENT PURPOSES ONLY




Assessors Office  
Cartography Dept

FOR ADDITIONAL MAPS VISIT OUR WEBSITE AT [www.co.marion.or.us](http://www.co.marion.or.us)

PLOT DATE: 6/12/2024

06 1E 28

06 1E 28

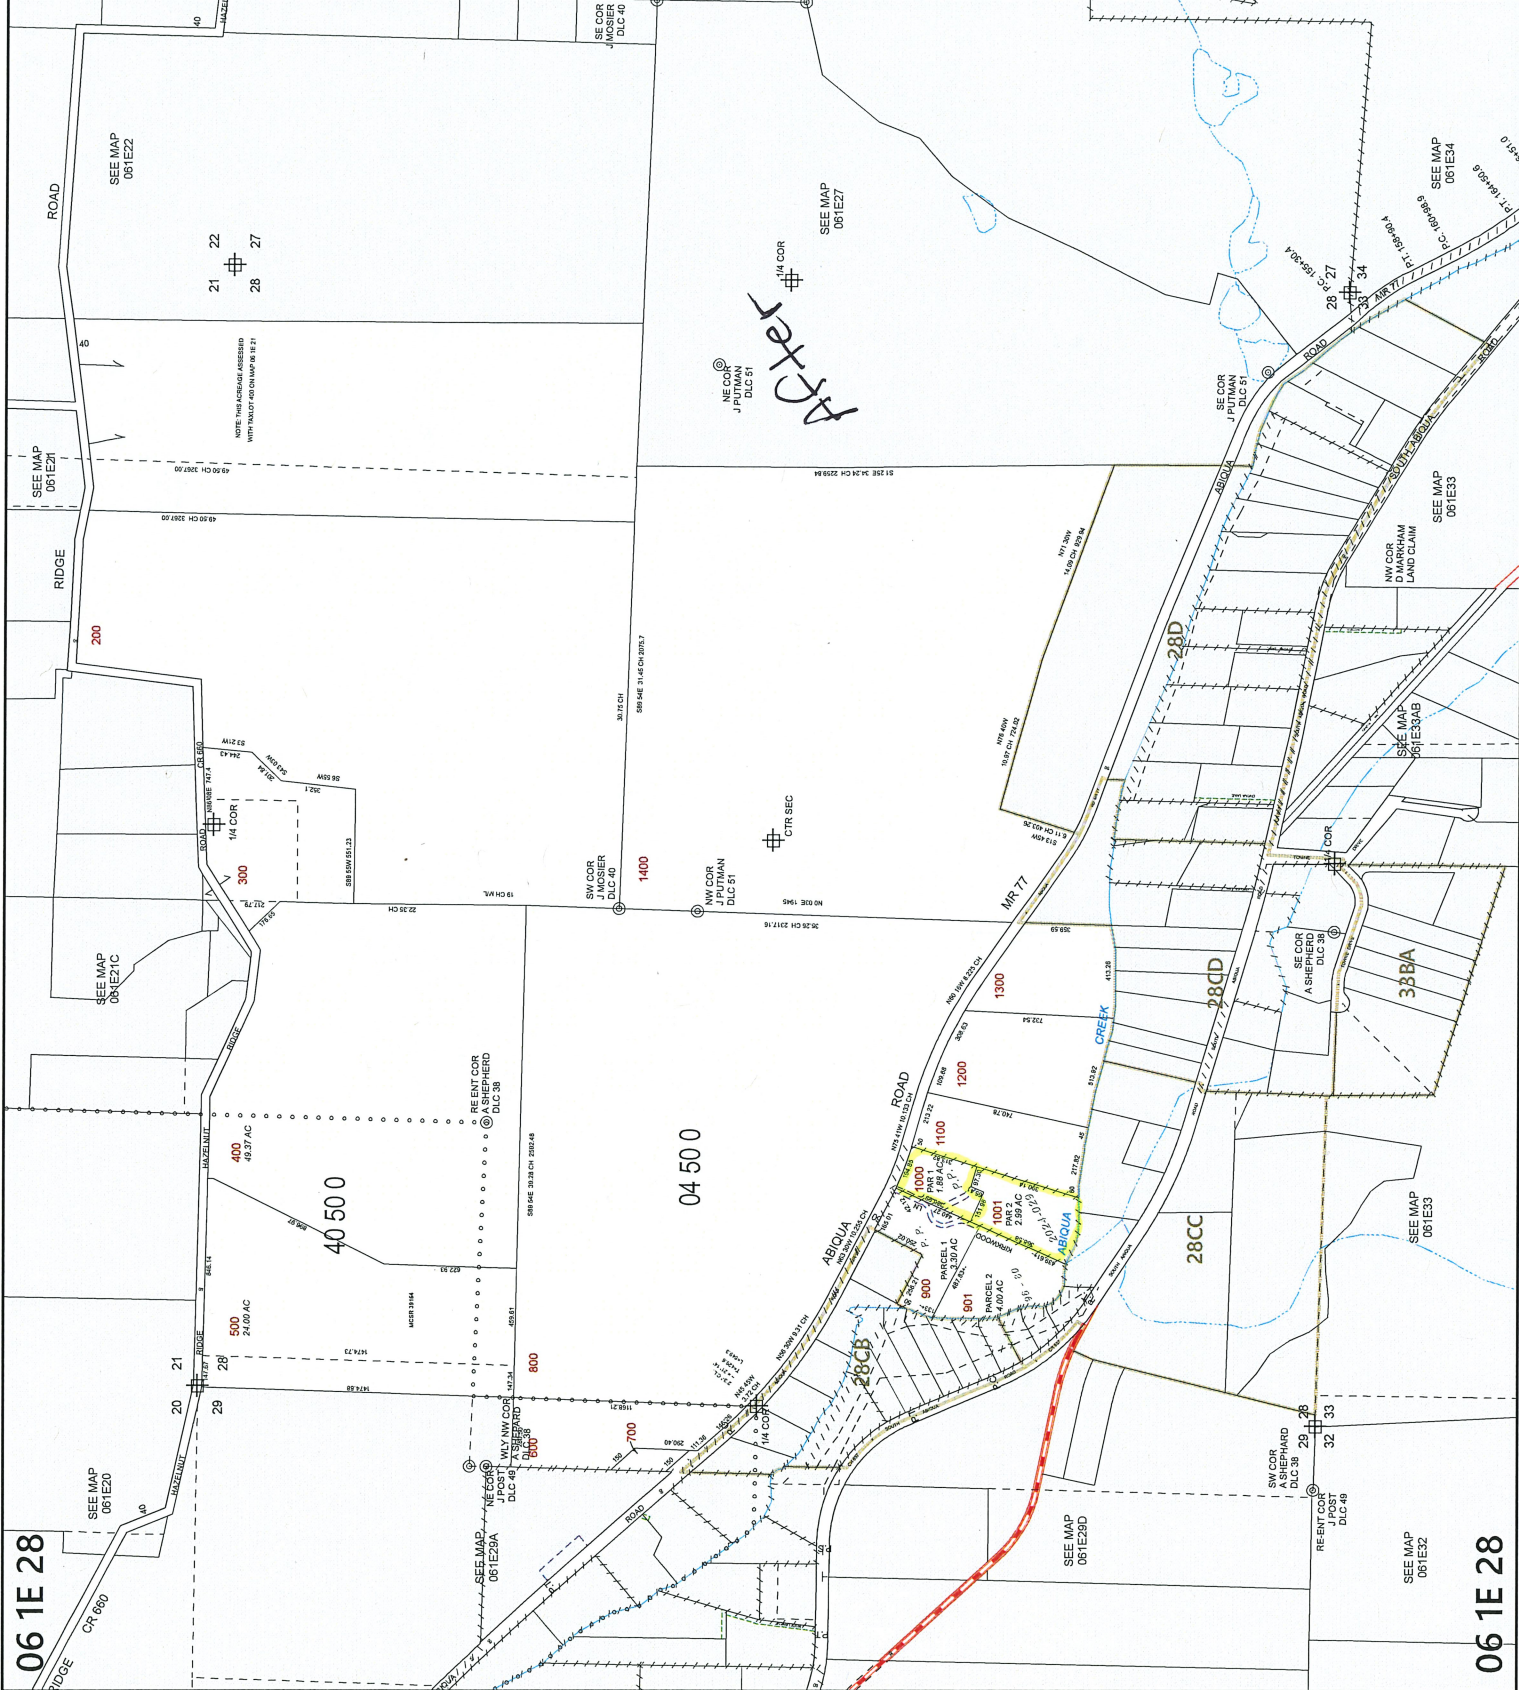



06 1E 28

06 1E 28



**MARION COUNTY, OREGON**  
SEC 28 T6S R1E W.M.  
SCALE 1" = 400'

**LEGEND**

- LINE TYPES**
- Taxlot Boundary
  - Historical Boundary
  - Road Right-of-Way
  - Right-of-Way
  - Railroad Right-of-Way
  - Private Road ROW
  - Subdivision/Plat Boundary
  - Waterline - Taxlot Boundary
  - Waterline - Non Boundary
- CORNER TYPES**
- + 1/16TH Section Cor.
  - ⊕ 1/4 Section Cor.
  - ⊙ DLC Corner
  - ⊕ 16' 1" Section Corner
  - ⊕ 21' 2" Section Corner
- NUMBERS**
- Tax Code Number  
**00 00 0**
- Acres  
0.25 AC

**NOTES**

Tick Marks: A tick mark in the road indicates that the labeled dimension extends into the public ROW

All acres listed are Net Acres, excluding any portions of the taxlot within public ROWs



CANCELLED NUMBERS
401

DISCLAIMER: THIS MAP WAS PREPARED FOR ASSESSMENT PURPOSES ONLY



FOR ADDITIONAL MAPS VISIT OUR WEBSITE AT [www.co.marion.or.us](http://www.co.marion.or.us)

PLOT DATE: 5/2/2022

06 1E 28

06 1E 28

