

Rural Work Order Cover Sheet

RAM Transaction #: 620026

Year: 24 - 25

Account Numbers Involved: 516934 516953

Sequence #1: DEDICATION TO TORVEND RD

Sequence #2: DEDICATION TO TORVEND RD

	Check For:				Forms Included:	
	Yes	No		Yes	No	✓
Move Building Permits	<input type="checkbox"/>	<input checked="" type="checkbox"/>	Fire Patrol (Email Supervisor)	<input type="checkbox"/>	<input checked="" type="checkbox"/>	<input checked="" type="checkbox"/>
Move Photos	<input type="checkbox"/>	<input checked="" type="checkbox"/>	Multi-Section	<input type="checkbox"/>	<input checked="" type="checkbox"/>	<input checked="" type="checkbox"/>
Update Apex	<input type="checkbox"/>	<input checked="" type="checkbox"/>	Tagged for 2 nd year Reset	<input type="checkbox"/>	<input checked="" type="checkbox"/>	<input checked="" type="checkbox"/>
Update Account Notes	<input checked="" type="checkbox"/>	<input type="checkbox"/>	Exemptions	<input type="checkbox"/>	<input checked="" type="checkbox"/>	<input type="checkbox"/>
PAT LIAB	<input type="checkbox"/>	<input checked="" type="checkbox"/>	Update Tracker	<input checked="" type="checkbox"/>	<input type="checkbox"/>	<input type="checkbox"/>
						<input checked="" type="checkbox"/>
						<input checked="" type="checkbox"/>
						<input checked="" type="checkbox"/>
						<input type="checkbox"/>
						<input type="checkbox"/>

Miscellaneous Notes: Needs soils corrected after work order

Appraiser: MLH

Date: 7/9/24

Appraisal Review: WW

Date: 7/10/24

Data Entry: Chris

Date: 7/15/24

Tax Year	Account ID	MTL	Transaction	Vouc	Recorded Date	Transaction Comment	Operation	Voucher Notes	Code	+/- Size	Size
2024	516934	061W3200	620026	1	8/25/2023 11:51	R/W DEDICATION - SDB	DEDICATION	DEDICATION TO TORVEND RD	04500	-1.14	A
2024	516953	061W3200	620026	2	8/25/2023 11:51	R/W DEDICATION - SDB	DEDICATION	DEDICATION TO TORVEND RD	04500	-0.26	A

Rural Work Order Processing Form

One Page Per Account

Sequence #: 1 of 2 Account Number: 516934 MTL: 061W320000600 RAM Transaction ID: 620026

Type: COM LLA PPT SEG SUB AC R of W Vacate Map Maintenance

Account Details

Ma Sa Nh: 03 06 000 Prop Class: 559 RMV Class: 509

Assigned Appraiser: MLH Part of Unit: Yes or No Fire Patrol: Yes or No

Land Fragment

Account From	Code Area	Liab Yr	Land Class	LUC	Value Source	# of Acres	Zone	Land Adjustments
516934	04500	2009		005	Farm Homesite	1.00	REST	
516934	04500	1974	2BI	005	Farm Use EFU	44.79	REST	GSOIL IRR
516934	04500	1974	4BI	005	Farm Use EFU	5.60	REST	IRR

Total Acres: 51.39

Improvements

Account From	Code Area	Imp ID	Stat Class	Description	Account From	Code Area	Imp ID	Stat Class	Description
NO CHANGE									

Adjustments: _____

Exception

New MAV: _____ Sys Calc No Change to MAV

Rural Work Order Processing Form

One Page Per Account

Sequence #: 2 of 2 Account Number: 516953 MTL: 061W320000700 RAM Transaction ID: 620026

Type: COM LLA PPT SEG SUB AC R of W Vacate Map Maintenance

Account Details

Ma Sa Nh: 03 06 000 Prop Class: 550 RMV Class: 450

Assigned Appraiser: MLH Part of Unit: Yes or No Fire Patrol: Yes or No

Land Fragment

Account From	Code Area	Liab Yr	Land Class	LUC	Value Source	# of Acres	Zone	Land Adjustments
516953	04500	1974	2BI	005	Farm Use EFU	0.02	REST	GSOIL IRR

Total Acres: 0.02


Improvements

Account From	Code Area	Imp ID	Stat Class	Description	Account From	Code Area	Imp ID	Stat Class	Description
NONE									

Adjustments: _____

Exception

New MAV: _____ Sys Calc No Change to MAV

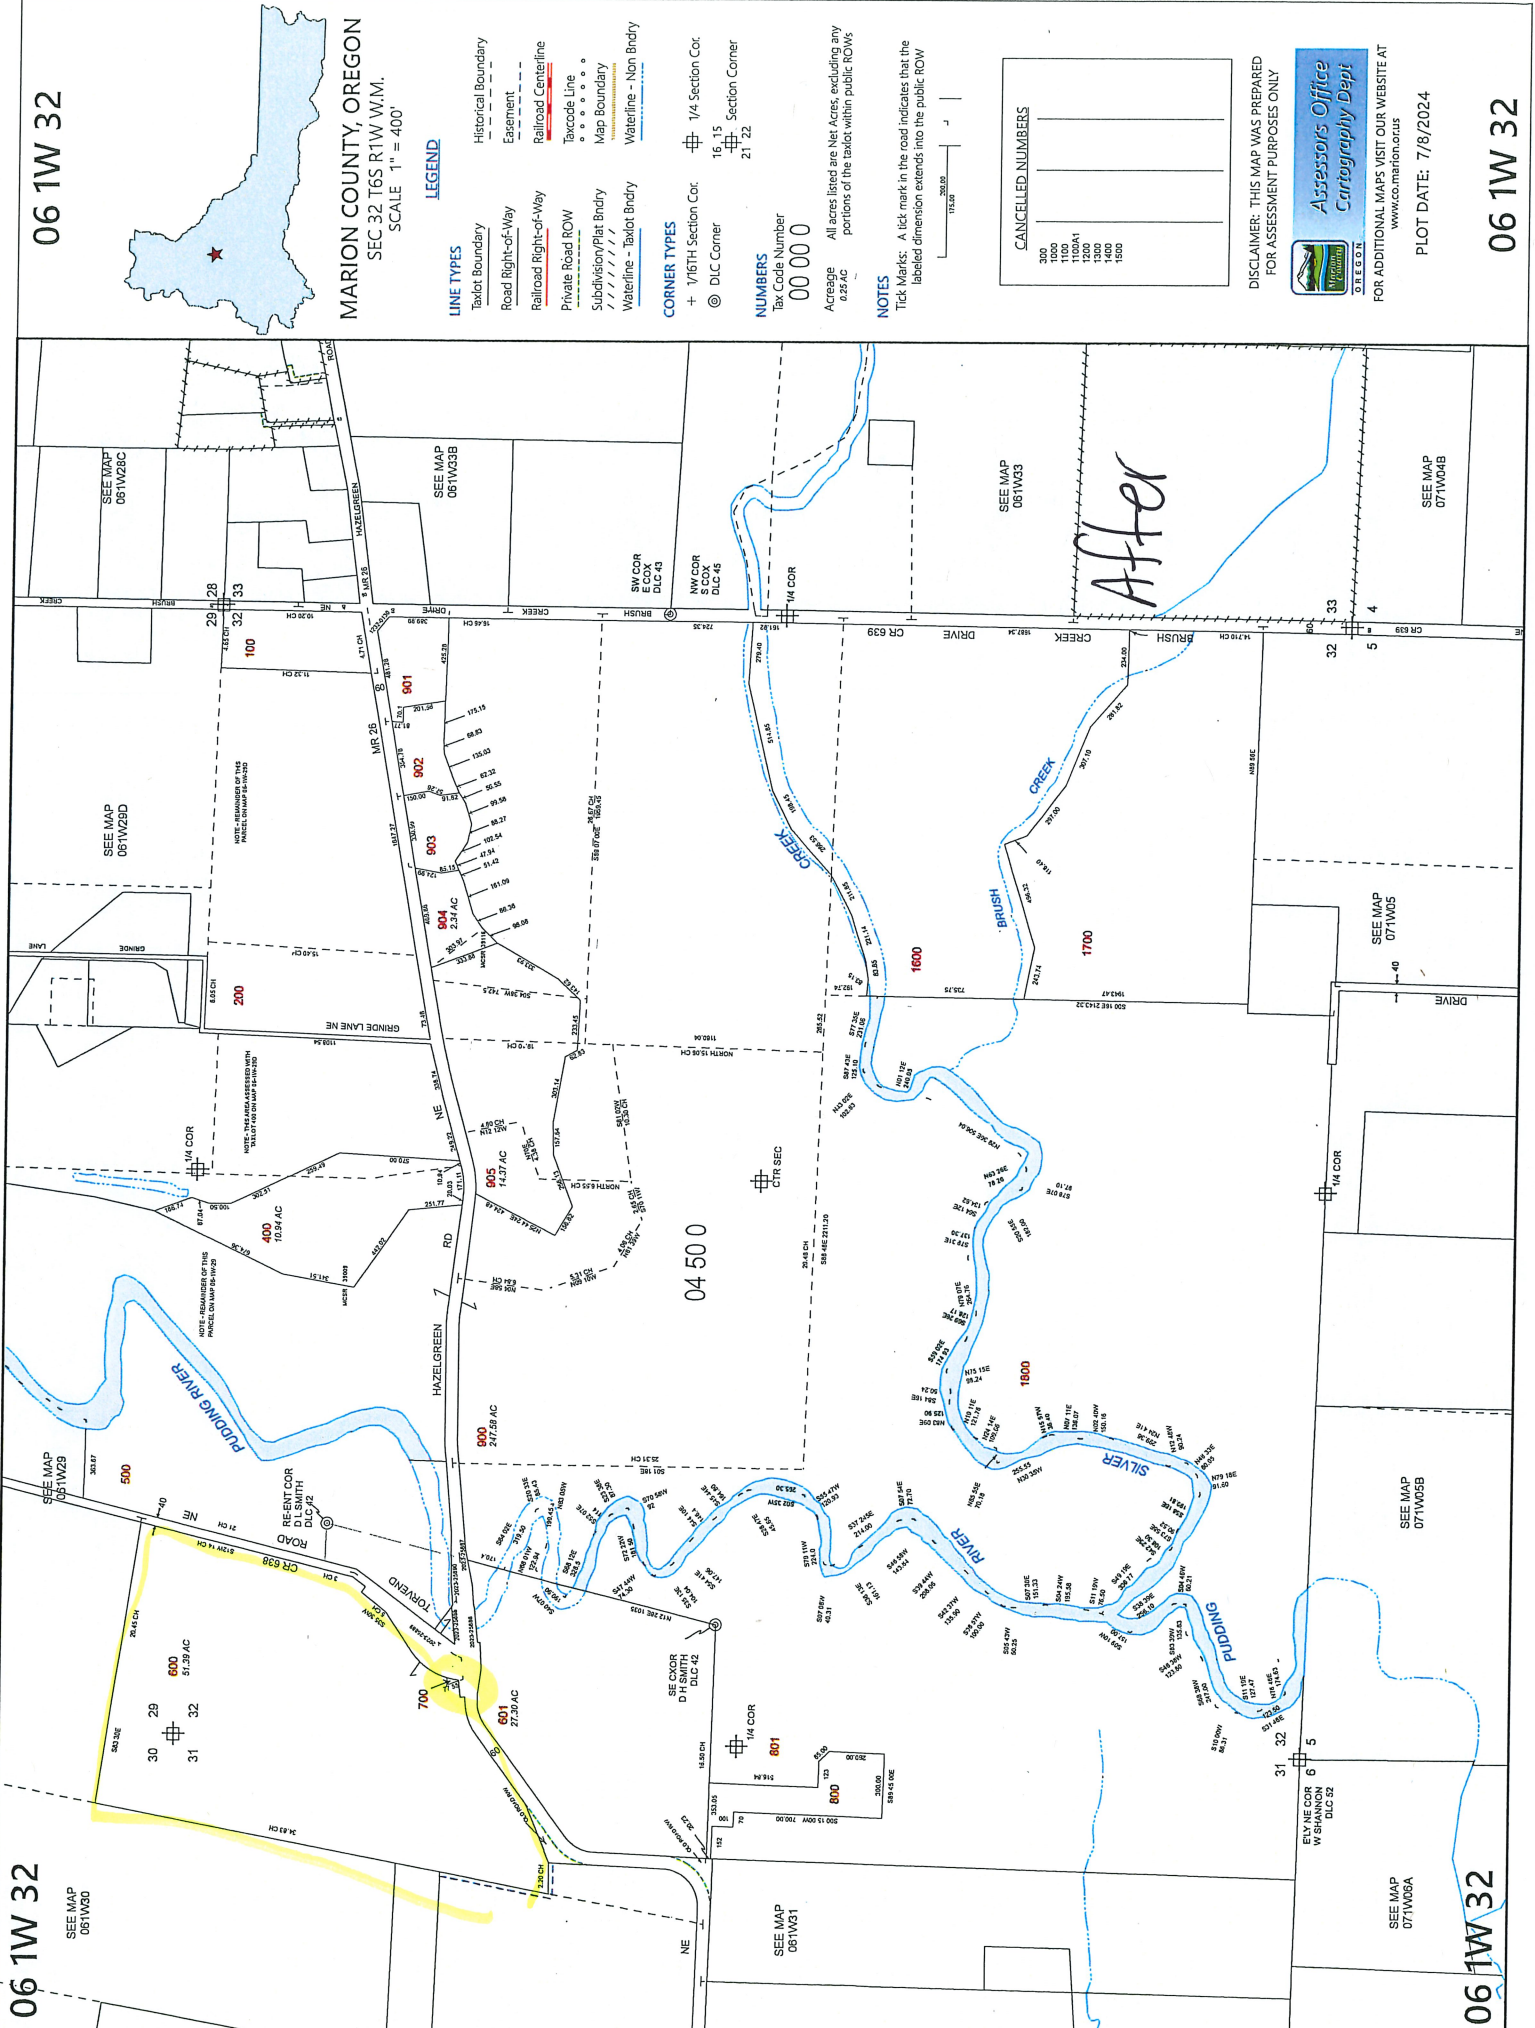

06 1W 32



MARION COUNTY, OREGON
 SEC 32 T6S R1W W.M.
 SCALE 1" = 400'

LEGEND

- LINE TYPES**
- Taxlot Boundary
 - Road Right-of-Way
 - Private Road ROW
 - Subdivision/Plat Bndry
 - Waterline - Taxlot Bndry
 - Waterline - Non Bndry
- CORNER TYPES**
- + 1/16TH Section Cor.
 - ⊕ 1/4 Section Cor.
 - ⊙ D/L Corner
 - ⊕ 16, 15 Section Corner
 - ⊕ 21, 22 Section Corner
- NUMBERS**
- Tax Code Number
 - 00 00 0
 - 00 00 0
 - 00 00 0
- NOTES**
- Tick Marks: A tick mark in the road indicates that the labeled dimension extends into the public ROW

CANCELLED NUMBERS

300
1000
1100A1
1200
1400
1500

DISCLAIMER: THIS MAP WAS PREPARED FOR ASSESSMENT PURPOSES ONLY



PLOT DATE: 7/8/2024

06 1W 32

06 1W 32

06 1W 32

06 1W 32



MARION COUNTY, OREGON
SEC 32 T6S R1W W1M.
SCALE 1" = 400'

LEGEND

LINE TYPES

- Taxlot Boundary
- Road Right-of-Way
- Railroad Right-of-Way
- Private Road ROW
- Subdivision/Plat Bndry
- Waterline - Taxlot Bndry
- Waterline - Non Bndry
- Historical Boundary
- Easement
- Railroad Centerline
- Taxcode Line
- Map Boundary

CORNER TYPES

- + 1/16TH Section Cor.
- ⊕ 1/4 Section Cor.
- ⊙ DIC Corner
- ⊕ 16, 15 Section Corner
- ⊕ 21, 22 Section Corner

NUMBERS

Tax Code Number

00 00 0

00 00 0

06 1W 32









06 1W 32

Assessors Office
Cartography Dept

DISCLAIMER: THIS MAP WAS PREPARED FOR ASSESSMENT PURPOSES ONLY

FOR ADDITIONAL MAPS VISIT OUR WEBSITE AT www.comarion.us

PLOT DATE: 10/16/2020

CANCELLED NUMBERS

300
1000
1100
1200
1300
1400
1500

NOTES

TICK MARKS: A tick mark in the road indicates that the labeled dimension extends into the public ROW

