

Rural Work Order Cover Sheet

RAM Transaction #: 626872

Year: 24 - 25

Account Numbers Involved: 530676

Sequence #1: DEDICATION TO MILL CREEK RD -0.14

Sequence #2: _____

Sequence #3: _____

Sequence #4: _____

Sequence #5: _____

	Check For:					Forms Included:	
	Yes	No		Yes	No		✓
Move Building Permits	<input type="checkbox"/>	<input checked="" type="checkbox"/>	Fire Patrol (Email Supervisor)	<input type="checkbox"/>	<input checked="" type="checkbox"/>	RAM Report	<input checked="" type="checkbox"/>
Move Photos	<input type="checkbox"/>	<input checked="" type="checkbox"/>	Multi-Section	<input type="checkbox"/>	<input checked="" type="checkbox"/>	Processing Forms	<input checked="" type="checkbox"/>
Update Apex	<input type="checkbox"/>	<input checked="" type="checkbox"/>	Tagged for 2 nd year Reset	<input type="checkbox"/>	<input checked="" type="checkbox"/>	Before and After Maps	<input checked="" type="checkbox"/>
Update Account Notes	<input checked="" type="checkbox"/>	<input type="checkbox"/>	Exemptions	<input type="checkbox"/>	<input checked="" type="checkbox"/>	Multi-Section Processing Form	<input type="checkbox"/>
PAT LIAB	<input type="checkbox"/>	<input checked="" type="checkbox"/>	Update Tracker	<input checked="" type="checkbox"/>	<input type="checkbox"/>	Calculation Form(s)	<input type="checkbox"/>

Miscellaneous Notes: _____

Appraiser: WW Date: 7/18/24

Appraisal Review: WW Date: 7/18/24

Data Entry: Chris Date: 7/23/24

Tax Year	Account ID	MTL	Transaction	Vou	Recorded Date	Transaction Comment	Operation	Voucher Notes	Code	+/- Size	Size
2024	530676	082W270002200	626872	1	2/29/2024 12:44	R/W DEDICATION - SDB	DEDICATION	DEDICATION TO MILL CREEK RD	05558	-0.14	A

Rural Work Order Processing Form

One Page Per Account

Sequence #: 1 of 1 Account Number: 530676 MTL: 082W270002200 RAM Transaction ID: 626872

Type: COM LLA PPT SEG SUB AC R of W Vacate Map Maintenance

Account Details

Ma Sa Nh: 0706000 Prop Class: 550 RMV Class: 500

Assigned Appraiser: MLORD Part of Unit: Yes or No Fire Patrol: Yes or No

Land Fragment

Account From	Code Area	Liab Yr	Land Class	LUC	Value Source	# of Acres	Zone	Land Adjustments
536076	05558	1976	4BISS	005	FARM USE – EFU	53.22	REST	IRR

Total Acres: 53.22

Improvements

Account From	Code Area	Imp ID	Stat Class	Description	Account From	Code Area	Imp ID	Stat Class	Description

Adjustments: _____

Exception

New MAV: _____ Sys Calc No Change to MAV

08 2W 27

08 2W 27

08 2W 27

08 2W 27



MARION COUNTY, OREGON
SEC 27 T8S R2W W.M.
SCALE 1" = 400'


LEGEND

- LINE TYPES**
- Taxlot Boundary
 - Road Right-of-Way
 - Railroad Right-of-Way
 - Private Road ROW
 - Subdivision/Plat Boundary
 - Waterline - Taxlot Boundary
 - Waterline - Non Boundary
 - Historical Boundary
 - Easement
 - Railroad Centerline
 - Traverse Line
 - Map Boundary
 - Waterline - Non Boundary
- CORNER TYPES**
- + 1/16TH Section Cor
 - ⊙ D/C Corner
 - ⊕ 1/4 Section Cor
 - ⊕ 1/15 Section Corner
 - ⊕ 21 22
- NUMBERS**
- Tax Code Number
00 00 0
- Acres
All acres listed are Net Acres, excluding any portions of the taxlot within public ROWs
- NOTES**
- Tick Marks: A tick mark in the road indicates that the labeled dimension extends into the public ROW

CANCELLED NUMBERS

1000
1100
2100

DISCLAIMER: THIS MAP WAS PREPARED FOR ASSESSMENT PURPOSES ONLY

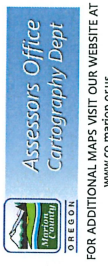

PLOT DATE: 10/16/2020

SEE MAP 082W26B

SEE MAP 082W26C
















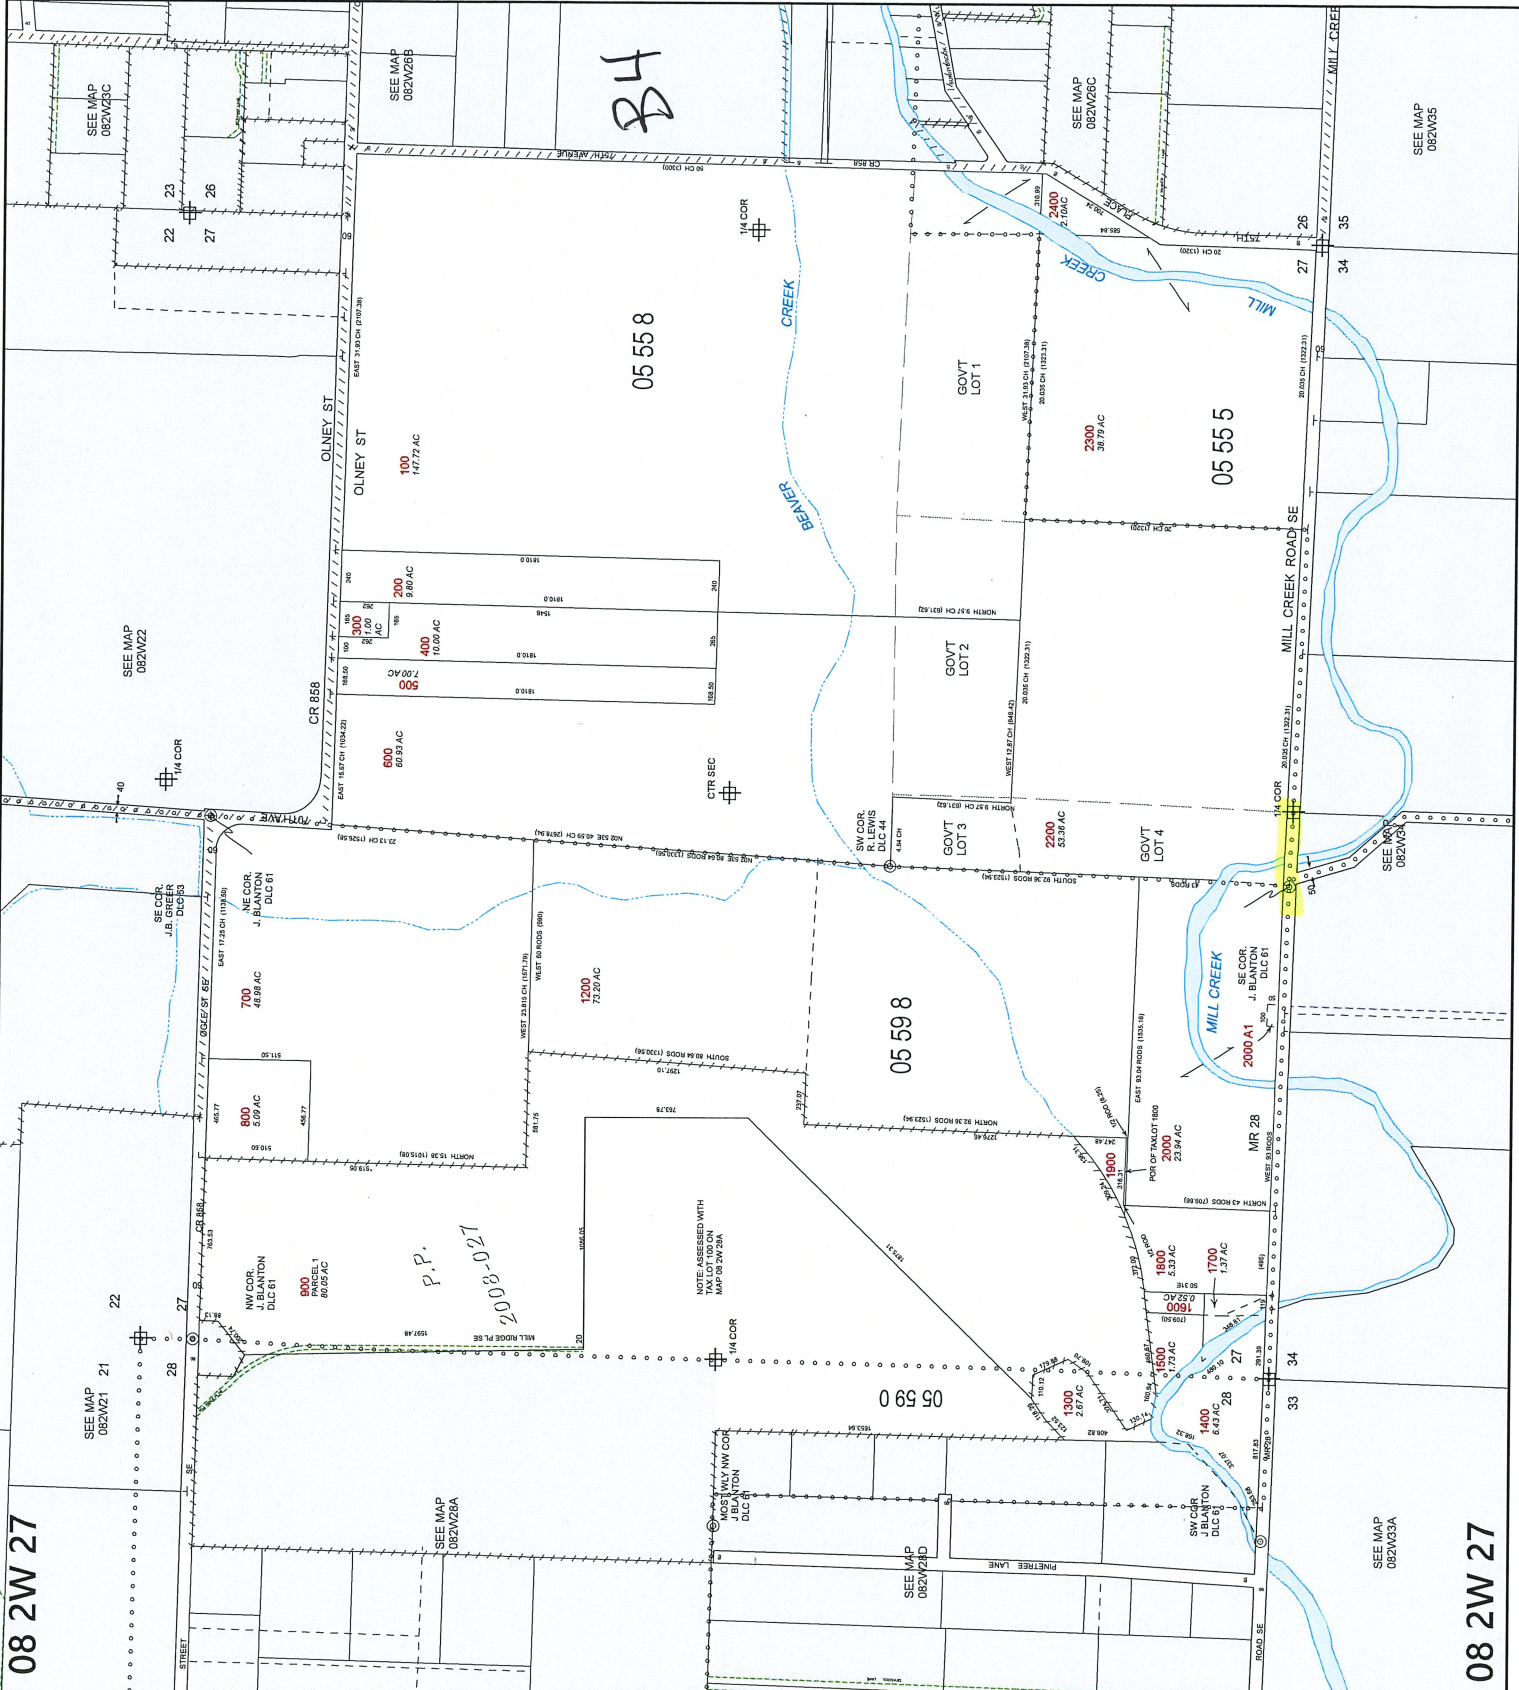

B4

05 55 8

05 55 5

05 59 8

05 59 0

P.P.
2008-021

