

Rural Work Order Cover Sheet

RAM Transaction #: 626873

Year: 24 - 25

Account Numbers Involved: 531142

Sequence #1: DEDICATION TO 70TH AVE -0.38

Sequence #2: _____

Sequence #3: _____

Sequence #4: _____

Sequence #5: _____

	Check For:				Forms Included:	
	Yes	No		Yes	No	✓
Move Building Permits	<input type="checkbox"/>	<input checked="" type="checkbox"/>	Fire Patrol (Email Supervisor)	<input type="checkbox"/>	<input checked="" type="checkbox"/>	RAM Report <input checked="" type="checkbox"/>
Move Photos	<input type="checkbox"/>	<input checked="" type="checkbox"/>	Multi-Section	<input type="checkbox"/>	<input checked="" type="checkbox"/>	Processing Forms <input checked="" type="checkbox"/>
Update Apex	<input type="checkbox"/>	<input checked="" type="checkbox"/>	Tagged for 2 nd year Reset	<input type="checkbox"/>	<input checked="" type="checkbox"/>	Before and After Maps <input checked="" type="checkbox"/>
Update Account Notes	<input checked="" type="checkbox"/>	<input type="checkbox"/>	Exemptions	<input type="checkbox"/>	<input checked="" type="checkbox"/>	Multi-Section Processing Form <input type="checkbox"/>
PAT LIAB	<input type="checkbox"/>	<input checked="" type="checkbox"/>	Update Tracker	<input checked="" type="checkbox"/>	<input type="checkbox"/>	Calculation Form(s) <input type="checkbox"/>

Miscellaneous Notes: _____

Appraiser: WW Date: 7/18/2024

Appraisal Review: WW Date: 7/18/2024

Data Entry: Chris Date: 7/23/24

Tax Year	Account ID	MTL	Transaction	Vou	Recorded Date	Transaction Comment	Operation	Voucher Notes	Code	+/- Size	Size
2024	531142	082W340000500	626873	1	2/29/2024 12:45	R/W DEDICATI ON - SDB	DEDICATI ON	DEDICATI ON TO 70TH AVE	05595	-0.38	A

Rural Work Order Processing Form

One Page Per Account

Sequence #: 1 of 1 Account Number: 531142 MTL: 082W340000500 RAM Transaction ID: 626873

Type: COM LLA PPT SEG SUB AC R of W Vacate Map Maintenance

Account Details

Ma Sa Nh: 0706000 Prop Class: 550 RMV Class: 500
 Assigned Appraiser: MLORD Part of Unit: Yes or No Fire Patrol: Yes or No

Land Fragment

Account From	Code Area	Liab Yr	Land Class	LUC	Value Source	# of Acres	Zone	Land Adjustments
531142	05595	1980	2BDSS	005	FARM USE – EFU	4.42	REST	GSOIL
531142	05595	1974	4BDSS	005	FARM USE – EFU	37.88	REST	

Total Acres: 42.30

Improvements

Account From	Code Area	Imp ID	Stat Class	Description	Account From	Code Area	Imp ID	Stat Class	Description

Adjustments: _____

Exception

New MAV: _____ Sys Calc No Change to MAV

08 2W 34

SEE MAP 082W26D
SW COR. J. BLANTON D.L.C. 91

08 2W 34



MARION COUNTY, OREGON

SEC 34, T8S R2W W.M.
SCALE 1" = 400'

LEGEND

LINE TYPES

- Taxlot Boundary
- Road Right-of-Way
- Railroad Right-of-Way
- Private Road ROW
- Subdivision/Plat Bndry
- Waterline - Taxlot Bndry
- Waterline - Non Bndry
- Historical Boundary
- Easement
- Railroad Centerline
- Tapcode Line
- Map Boundary
- Waterline - Non Bndry

CORNER TYPES


- + 1/16TH Section Cor.
- ⊕ 1/4 Section Cor.
- ⊙ D.L.C. Corner
- 16, 15
- ⊕ Section Corner
- 21, 22

NUMBERS

Tax Code Number
00 00 0
Acreage
All acres listed are Net Acres, excluding any portions of the taxlot within public ROWs.

NOTES

Tick Marks: A tick mark in the road indicates that the labeled dimension extends into the public ROW.

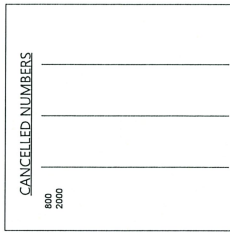

DISCLAIMER: THIS MAP WAS PREPARED FOR ASSESSMENT PURPOSES ONLY




FOR ADDITIONAL MAPS VISIT OUR WEBSITE AT www.co.marion.or.us

PLOT DATE: 7/11/2024

08 2W 34

08 2W 34

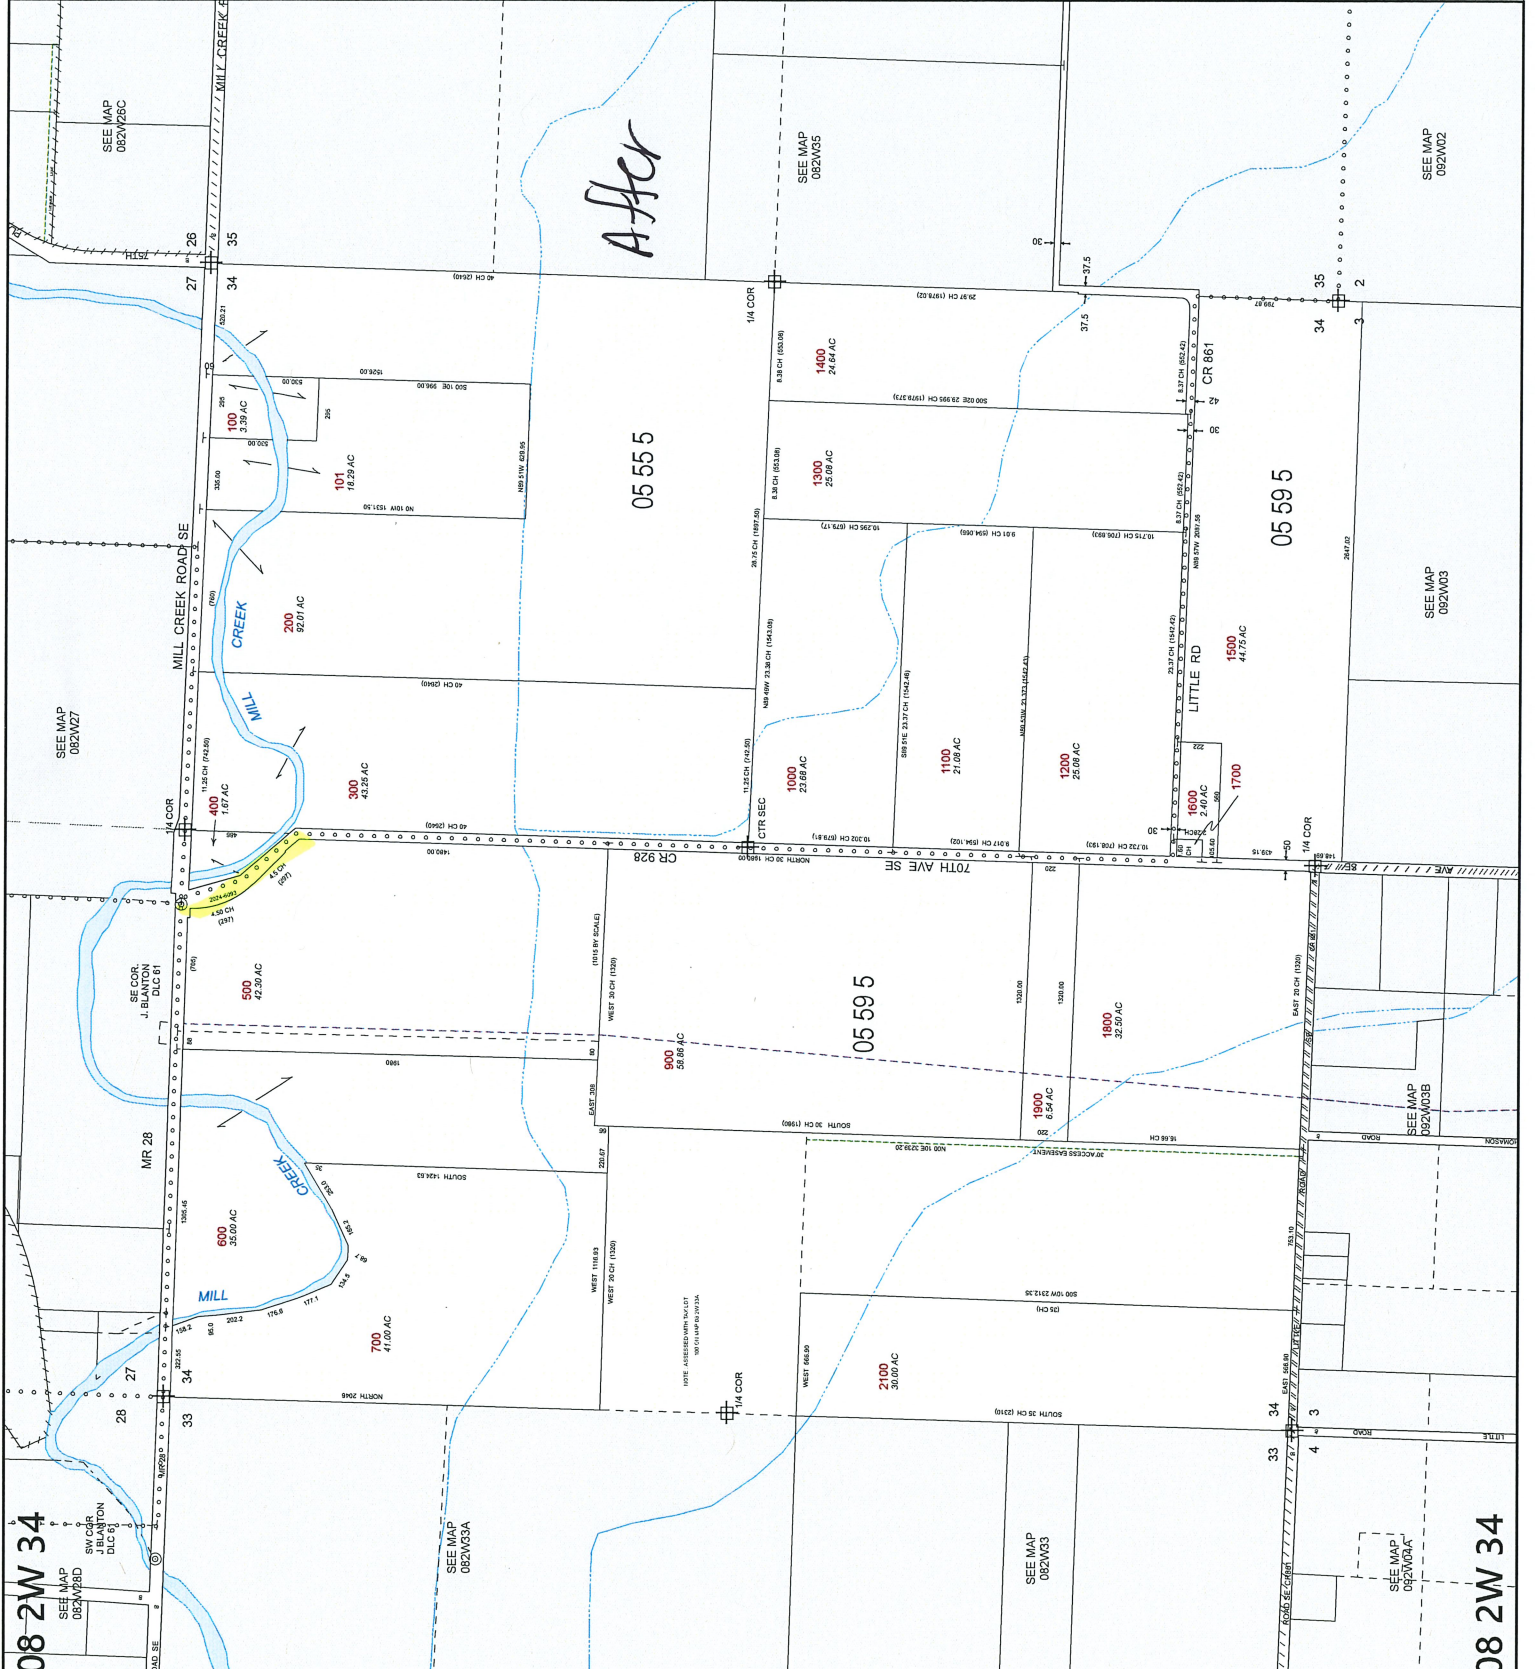

08 2W 34



MARION COUNTY, OREGON

SEC 34 T8S R2W W.M.
SCALE 1" = 400'

LEGEND

- LINE TYPES**
- Taxlot Boundary
 - Road Right-of-Way
 - Railroad Right-of-Way
 - Private Road ROW
 - Subdivision/Plat Boundary
 - Waterline - Taxlot Boundary
 - Waterline - Non Boundary
 - Historical Boundary
 - Easement
 - Railroad Centerline
 - Taxcode Line
 - Map Boundary
 - Waterline - Non Boundary

CORNER TYPES

- + 1/16TH Section Cor.
- ⊙ D/LC Corner
- ⊕ 1/4 Section Cor.
- 16 15 Section Corner
- 21 22 Section Corner

NUMBERS

- Tax Code Number
- 00000
- 0.25 AC
- All acres listed are Net Acres, excluding any portions of the taxlot within public ROWs

NOTES

Tick Marks: A tick mark in the road indicates that the labeled dimension extends into the public ROW

CANCELLED NUMBERS
800
2000

DISCLAIMER: THIS MAP WAS PREPARED FOR ASSESSMENT PURPOSES ONLY



PLOT DATE: 10/16/2020

08 2W 34

