


SKETCH/AREA TABLE ADDENDUM

SUBJECT INFO			
File No.: 604989	Parcel No.: 052W13AA14500		
Property Address: 1790 RITA DR			
City: Woodburn	County:	State: OR	ZipCode: 97071
Owner:			
Client:	Client Address:		
Appraiser Name:	Inspection Date:		

SKETCH

604989
052W13AA14500

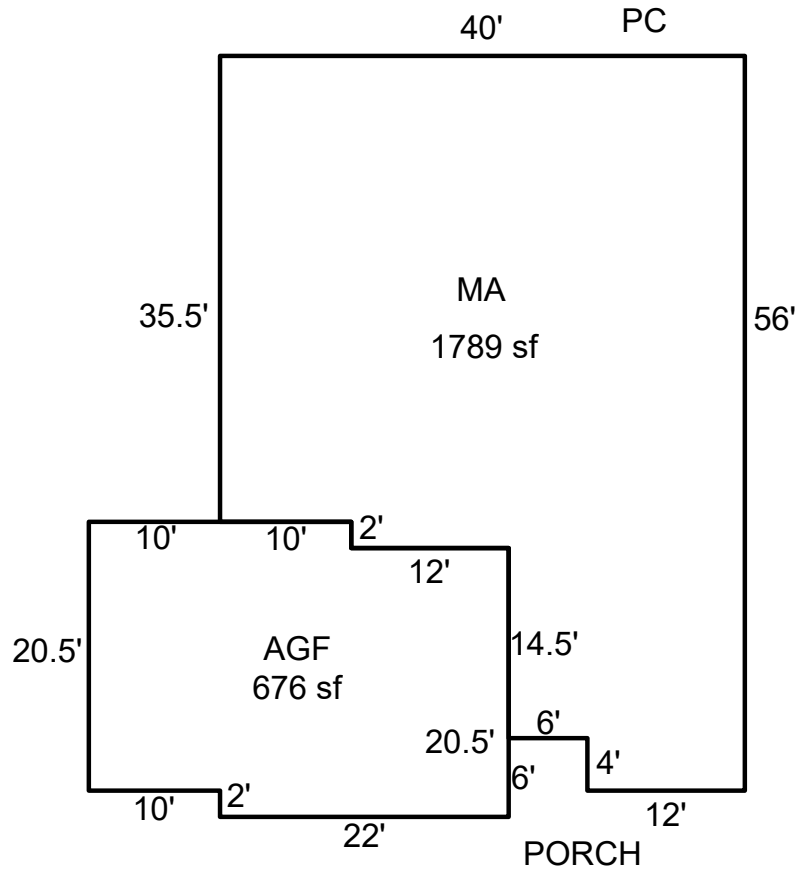

Sketch by ApexSketch

AREA CALCULATIONS SUMMARY						COMMENT TABLE 1		
Code	Description	Factor	Net Size	Perimeter	Net Totals	DRAWN BY JT 2/7/24 Updated by AE 8.19.24		
GLA	MA	1.0	1789.0	192.0	1789.0			
GAR	AGF	1.0	676.0	109.0	676.0			
						COMMENT TABLE 2	COMMENT TABLE 3	
						VER 7/24/24 AG		
Net LIVABLE		cnt	1	(rounded)	1,789			