


SKETCH/AREA TABLE ADDENDUM

SUBJECT INFO

File No.: 106586 Parcel No.: 051W07CD05300
 Property Address: 529 N SETTLEMIER AVE
 City: WOODBURN County: State: OR ZipCode: 97071
 Owner:
 Client: Client Address:
 Appraiser Name: Inspection Date:

SKETCH

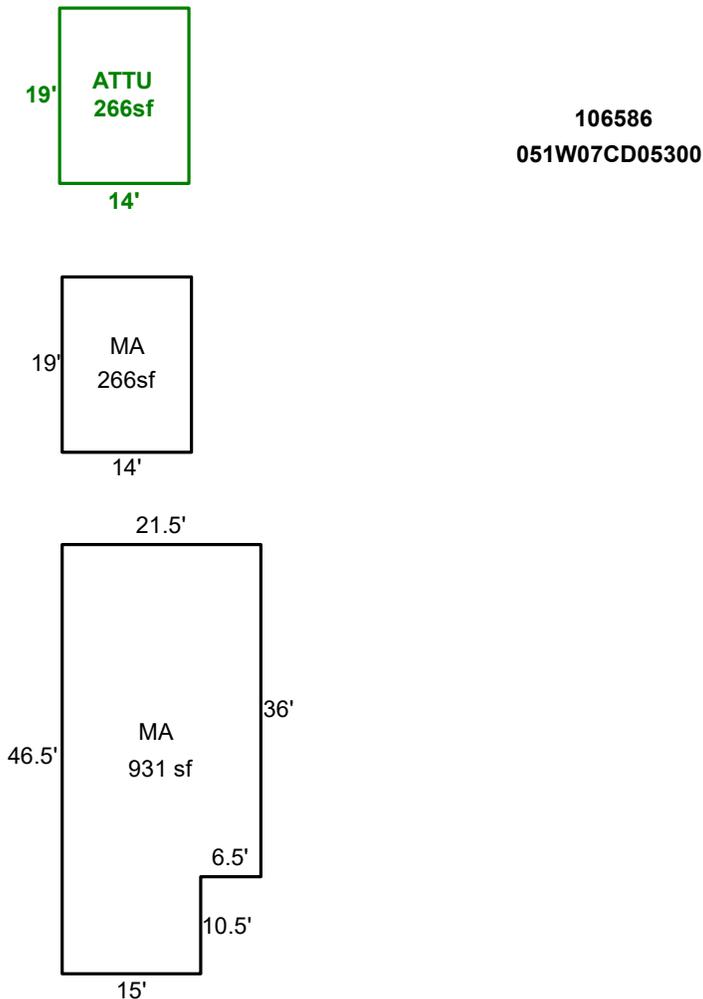

Sketch by ApexSketch

AREA CALCULATIONS SUMMARY						COMMENT TABLE 1	
Code	Description	Factor	Net Size	Perimeter	Net Totals		
GLA	MA	1.0	266.0	66.0		DRAWN BY PST 10/29/09 UPDATED BY SRAGSDALE 9/2/14 UPDATED BY LK 9.18.24	
	MA	1.0	931.5	136.0	1197.5		
GLA2	ATTU	1.0	266.0	66.0	266.0		
Net LIVABLE cnt 3 (rounded) 1,464						COMMENT TABLE 2	COMMENT TABLE 3
						8/14/14 #42, CYCLE, NV 8-28-24 TAG AG	