


SKETCH/AREA TABLE ADDENDUM

SUBJECT INFO			
File No.: 610017	Parcel No.: 052W13DB09000		
Property Address: 2544 Sawtelle Dr			
City: Woodburn	County: Marion	State: OR	ZipCode: 97071
Owner:			
Client:	Client Address:		
Appraiser Name:		Inspection Date:	

SKETCH

610017

052W13DB09000

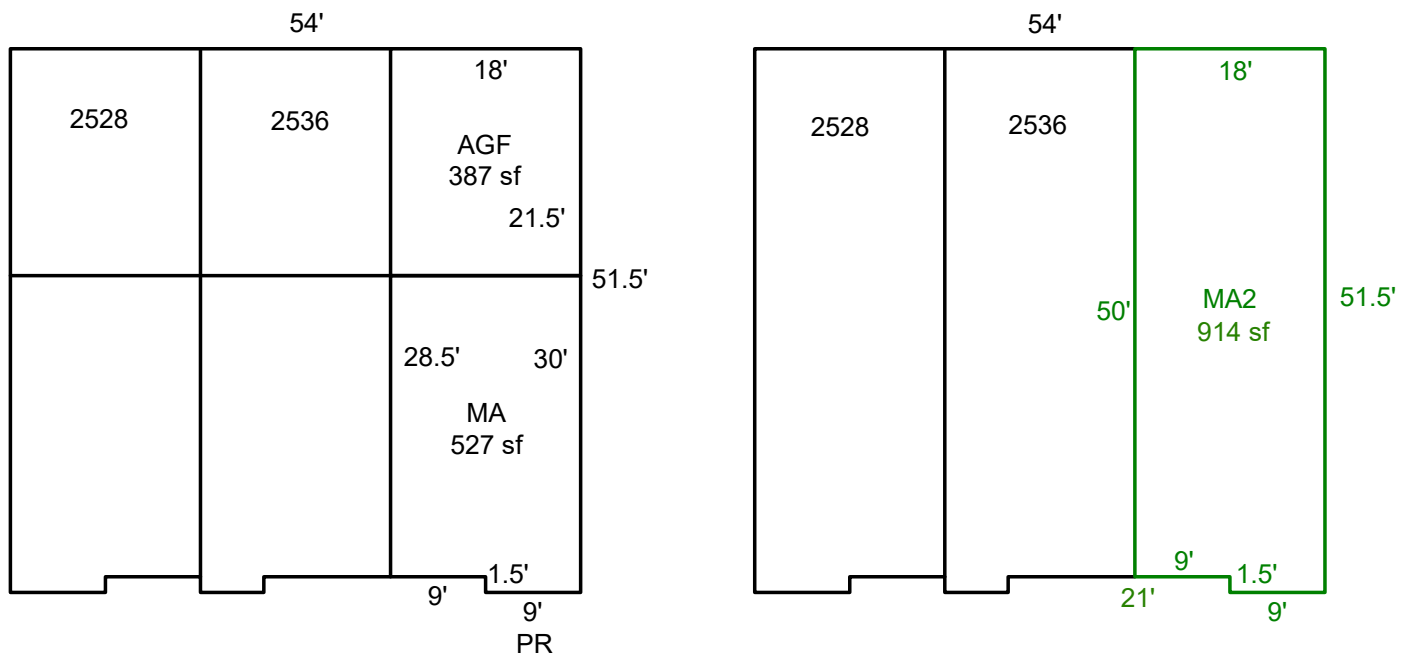

Sketch by ApexSketch

[illegible]