

# SKETCH/AREA TABLE ADDENDUM

## SUBJECT INFO


File No.: 328498 Parcel No.: 082W02C 06000  
 Property Address: 7527 HARLEY WAY SE  
 City: Salem County: State: OR ZipCode: 97317  
 Owner:  
 Client: Client Address:  
 Appraiser Name: Inspection Date:

## SKETCH

**328498**  
**082W02C 06000**



See Page 2 for Res Dimensions

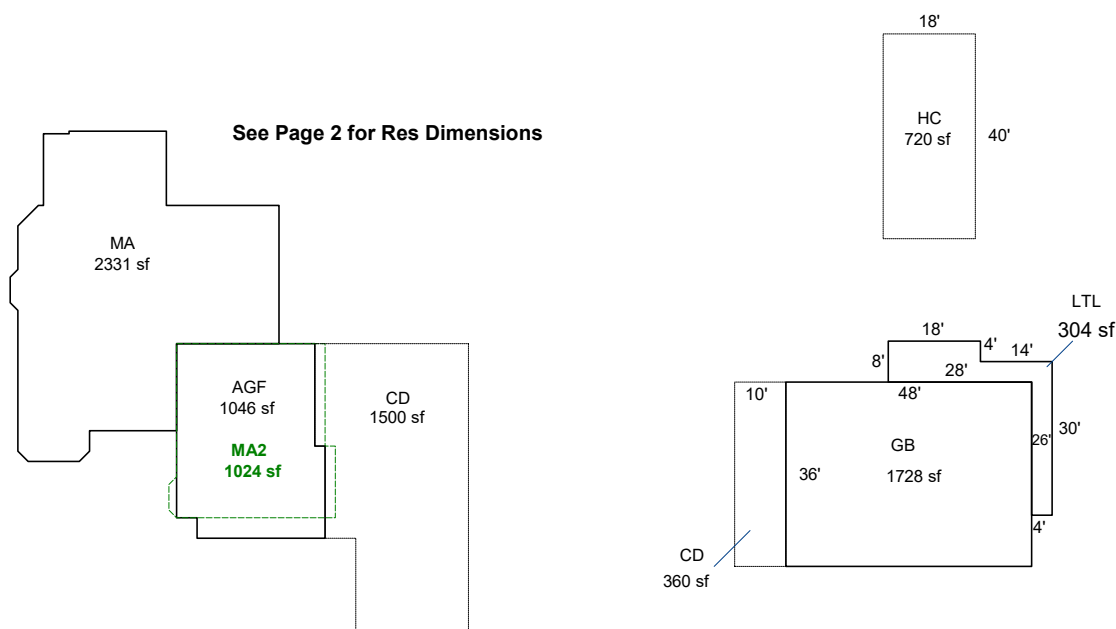

Sketch by ApexSketch

AREA CALCULATIONS SUMMARY						COMMENT TABLE 1	
Code	Description	Factor	Net Size	Perimeter	Net Totals		
GBA1	GB	1.0	1728.0	168.0		Apex by CW 2/13/14 UPDATED BY CLOBERG 10/28/24	
	LTL	1.0	304.0	132.0	2032.0		
GLA1	MA	1.0	2331.3	227.6	2331.3		
GLA2	MA2	1.0	1023.8	131.2	1023.8		
AGF	AGF	1.0	1046.0	134.0	1046.0		
P/P	CD	1.0	360.0	92.0			
	CD	1.0	1500.0	172.0	1860.0		
	Net LIVABLE	cnt	2 (rounded)		3,355		
	Net BUILDING	cnt	2 (rounded)		2,032		


COMMENT TABLE 2	COMMENT TABLE 3
CLUKE 09/26/24	TAGS SOLAR L4

# SKETCH/AREA TABLE ADDENDUM

## SUBJECT INFO

File No.: 328498 Parcel No.: 082W02C 06000  
 Property Address: 7527 HARLEY WAY SE  
 City: Salem County: State: OR ZipCode: 97317  
 Owner:  
 Client: Client Address:  
 Appraiser Name: Inspection Date:

## SKETCH

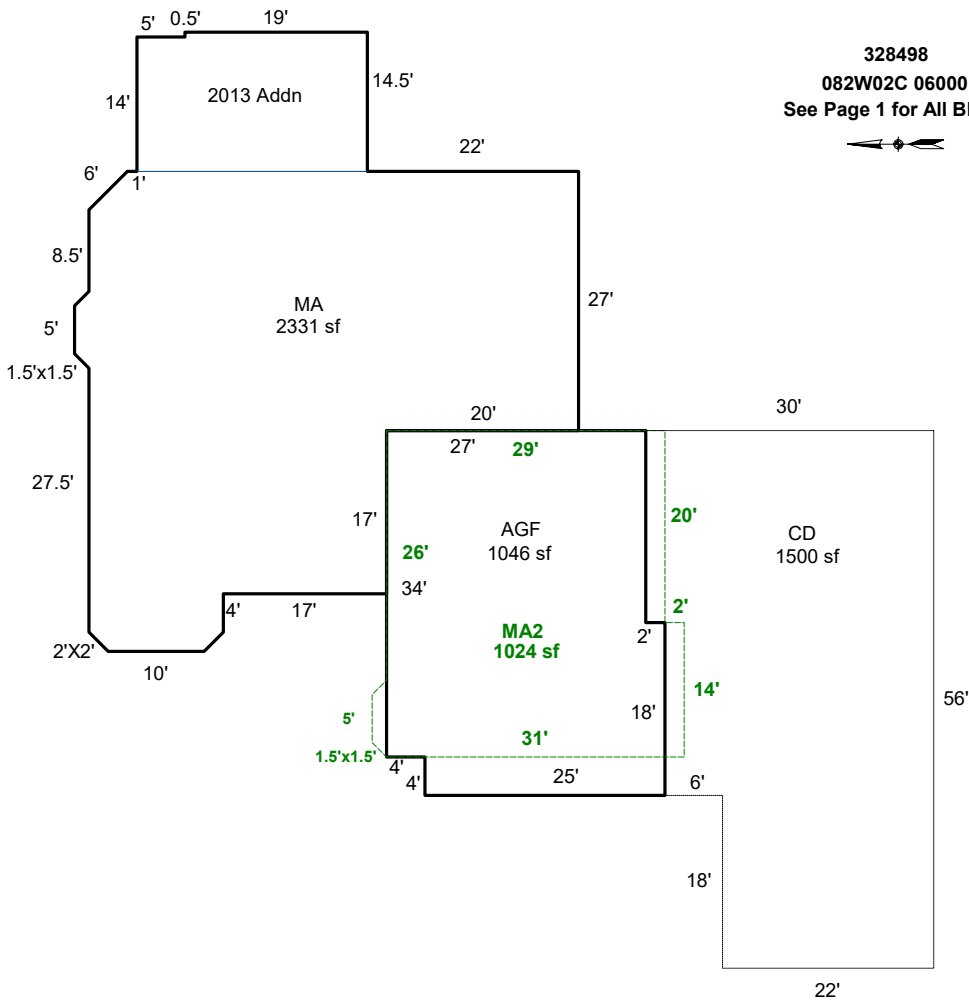

### AREA CALCULATIONS SUMMARY

Code	Description	Factor	Net Size	Perimeter	Net Totals
GLA1	MA	1.0	2331.3	227.6	2331.3
GLA2	MA2	1.0	1023.8	131.2	1023.8
AGF	AGF	1.0	1046.0	134.0	1046.0
P/P	CD	1.0	1500.0	172.0	1500.0

### COMMENT TABLE 1

Apex by CW 2/13/14  
 UPDATED BY CLOBERG 10/28/24

### COMMENT TABLE 2

CLUKE 09/26/24

### COMMENT TABLE 3

TAGS SOLAR L4

Net LIVABLE                      cnt                      2                      (rounded)                      3,355