


## SKETCH/AREA TABLE ADDENDUM

| SUBJECT INFO                       |                 |                           |                |
|------------------------------------|-----------------|---------------------------|----------------|
| File No.: 100673                   |                 | Parcel No.: 103W11DA00900 |                |
| Property Address: 147 GREENWOOD DR |                 |                           |                |
| City: JEFFERSON                    | County: Marion  | State: OR                 | ZipCode: 97352 |
| Owner:                             |                 |                           |                |
| Client:                            | Client Address: |                           |                |
| Appraiser Name:                    |                 | Inspection Date:          |                |

## SKETCH

**100673**  
**103W11DA00900**

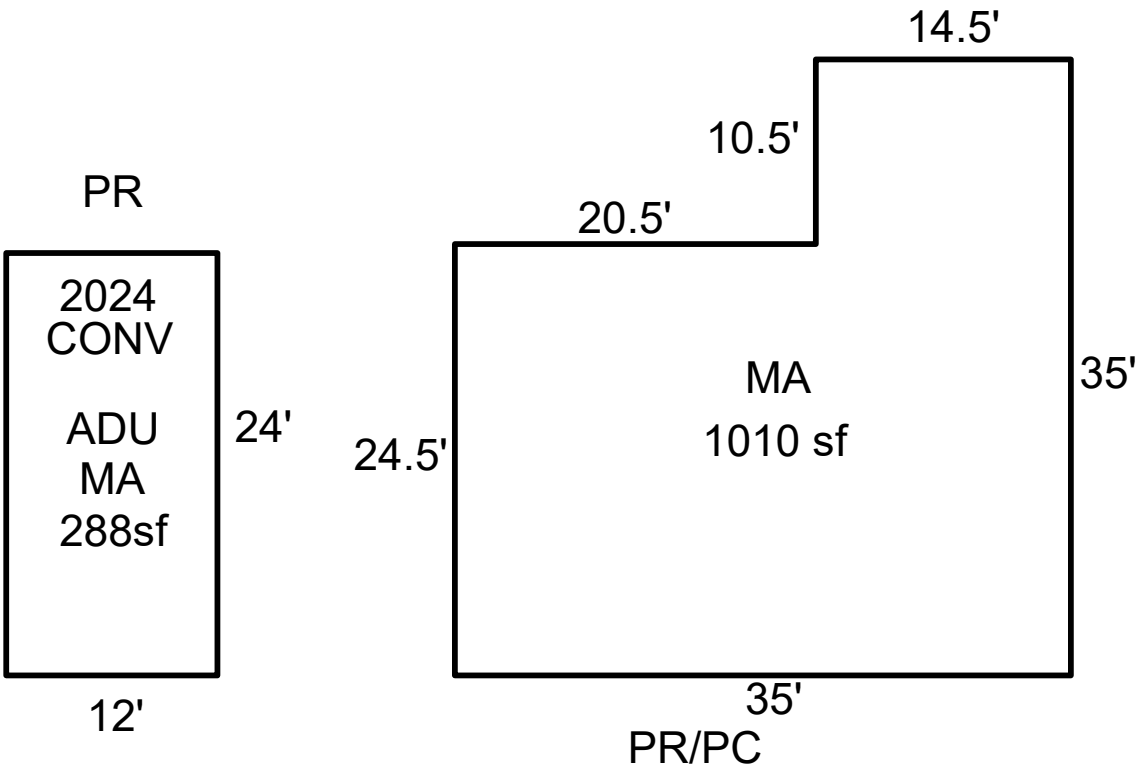

Sketch by ApexSketch

| AREA CALCULATIONS SUMMARY |             |        |          |           |            | COMMENT TABLE 1                               |                 |  |
|---------------------------|-------------|--------|----------|-----------|------------|-----------------------------------------------|-----------------|--|
| Code                      | Description | Factor | Net Size | Perimeter | Net Totals | DRAWN BY TB 12/10/08<br>Updated by AE 11.7.24 |                 |  |
| GLA                       | MA          | 1.0    | 288.0    | 72.0      | 288.0      |                                               |                 |  |
| GLA1                      | MA          | 1.0    | 1009.8   | 140.0     | 1009.8     |                                               |                 |  |
|                           |             |        |          |           |            | COMMENT TABLE 2                               | COMMENT TABLE 3 |  |
|                           |             |        |          |           |            |                                               |                 |  |
|                           |             |        |          |           |            |                                               |                 |  |
| Net LIVABLE               |             | cnt    | 2        | (rounded) | 1,298      |                                               |                 |  |