


# SKETCH/AREA TABLE ADDENDUM

## SUBJECT INFO

File No.: 103810 Parcel No.: 091W10AC12700  
 Property Address: 1035-1077 6TH AV  
 City: STAYTON County: MARION State: OR ZipCode: 97383  
 Owner:  
 Client: Client Address:  
 Appraiser Name: Inspection Date:

## SKETCH

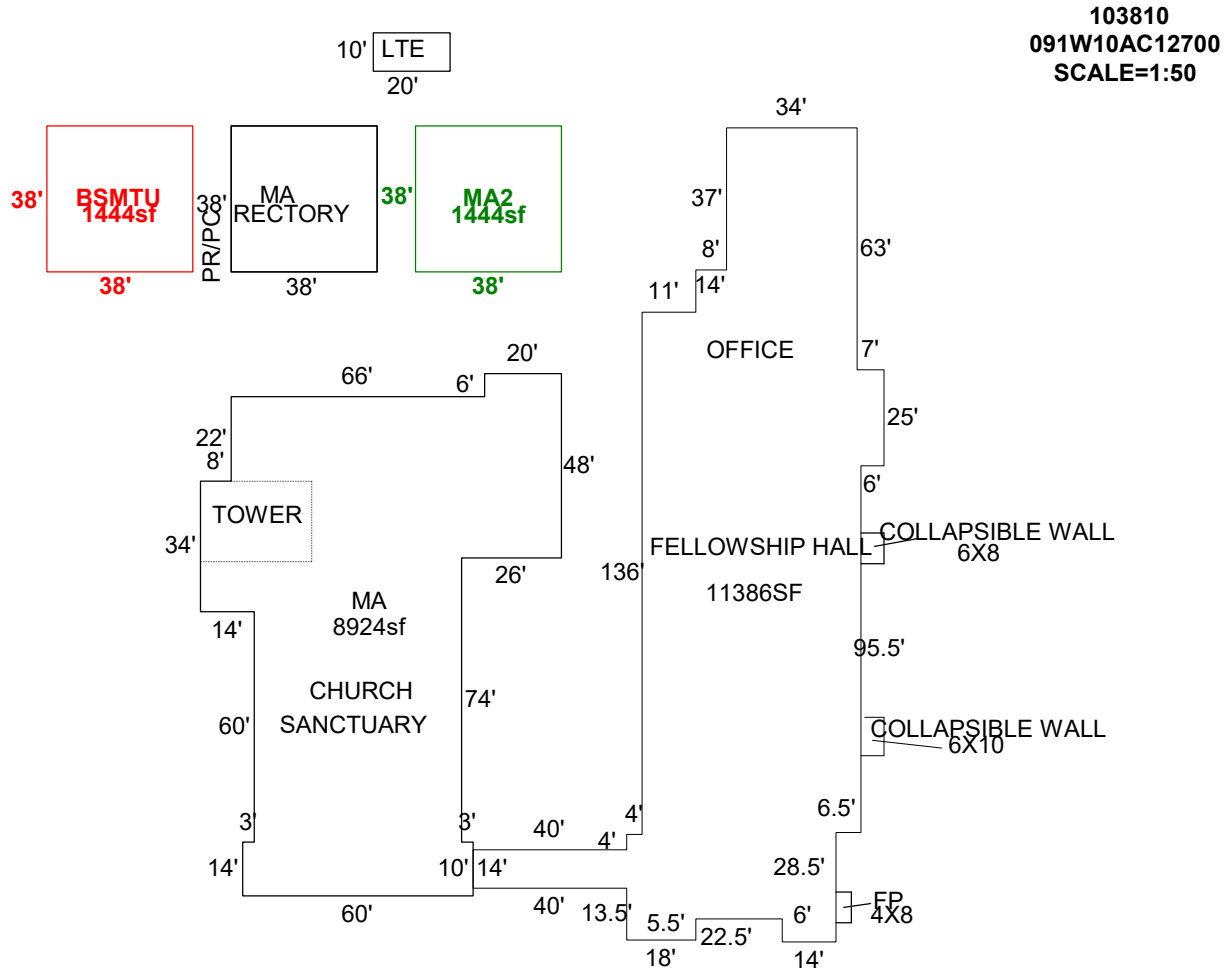

### AREA CALCULATIONS SUMMARY

| Code | Description | Factor | Net Size | Perimeter | Net Totals |
|------|-------------|--------|----------|-----------|------------|
| GBA1 | LTE         | 1.0    | 200.0    | 60.0      | 200.0      |
| GLA0 | BSMTU       | 1.0    | 1444.0   | 152.0     | 1444.0     |
| GLA1 | RECTORY     | 1.0    | 1444.0   | 152.0     |            |
|      | MA          | 1.0    | 8924.0   | 472.0     |            |
|      | FELLOWSHIP  | 1.0    | 11385.8  | 649.0     |            |
|      | MA          | 1.0    | 1444.0   | 152.0     | 23197.8    |
| GLA2 | MA2         | 1.0    | 1444.0   | 152.0     | 1444.0     |

### COMMENT TABLE 1

DRAWN BY JRONDEMA 3/9/17  
 UPDATED BY LK 9-28-2020  
 UPDATED BY LK 12.19.24

### COMMENT TABLE 2

TAG 12.3.24 GM

### COMMENT TABLE 3

Net LIVABLE cnt 1 (rounded) 26,086  
 Net BUILDING cnt 0 (rounded) 200