


SKETCH/AREA TABLE ADDENDUM

SUBJECT INFO			
File No.: 610020	Parcel No.: 052W13DB09300		
Property Address: 2520 Sawtelle Dr			
City: Woodburn	County: Marion	State: OR	ZipCode: 97071
Owner:			
Client:	Client Address:		
Appraiser Name:	Inspection Date:		

SKETCH

610020

052W13DB09300

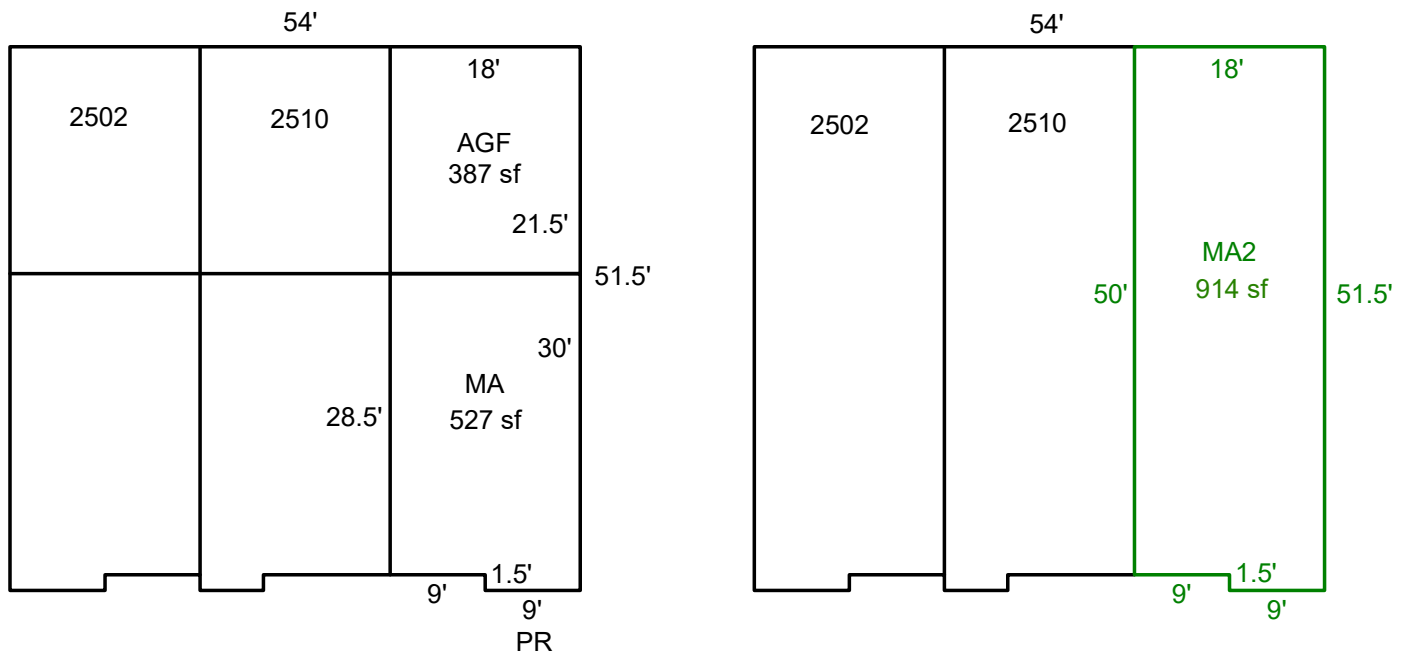

Sketch by ApexSketch

[illegible]