


SKETCH/AREA TABLE ADDENDUM

SUBJECT INFO

File No.: 325861 Parcel No.: 082W26C 02701
 Property Address: 7922 Cargile Lane SE
 City: Aumsville County: State: OR ZipCode: 97325
 Owner:
 Client: Client Address:
 Appraiser Name: Inspection Date:

SKETCH

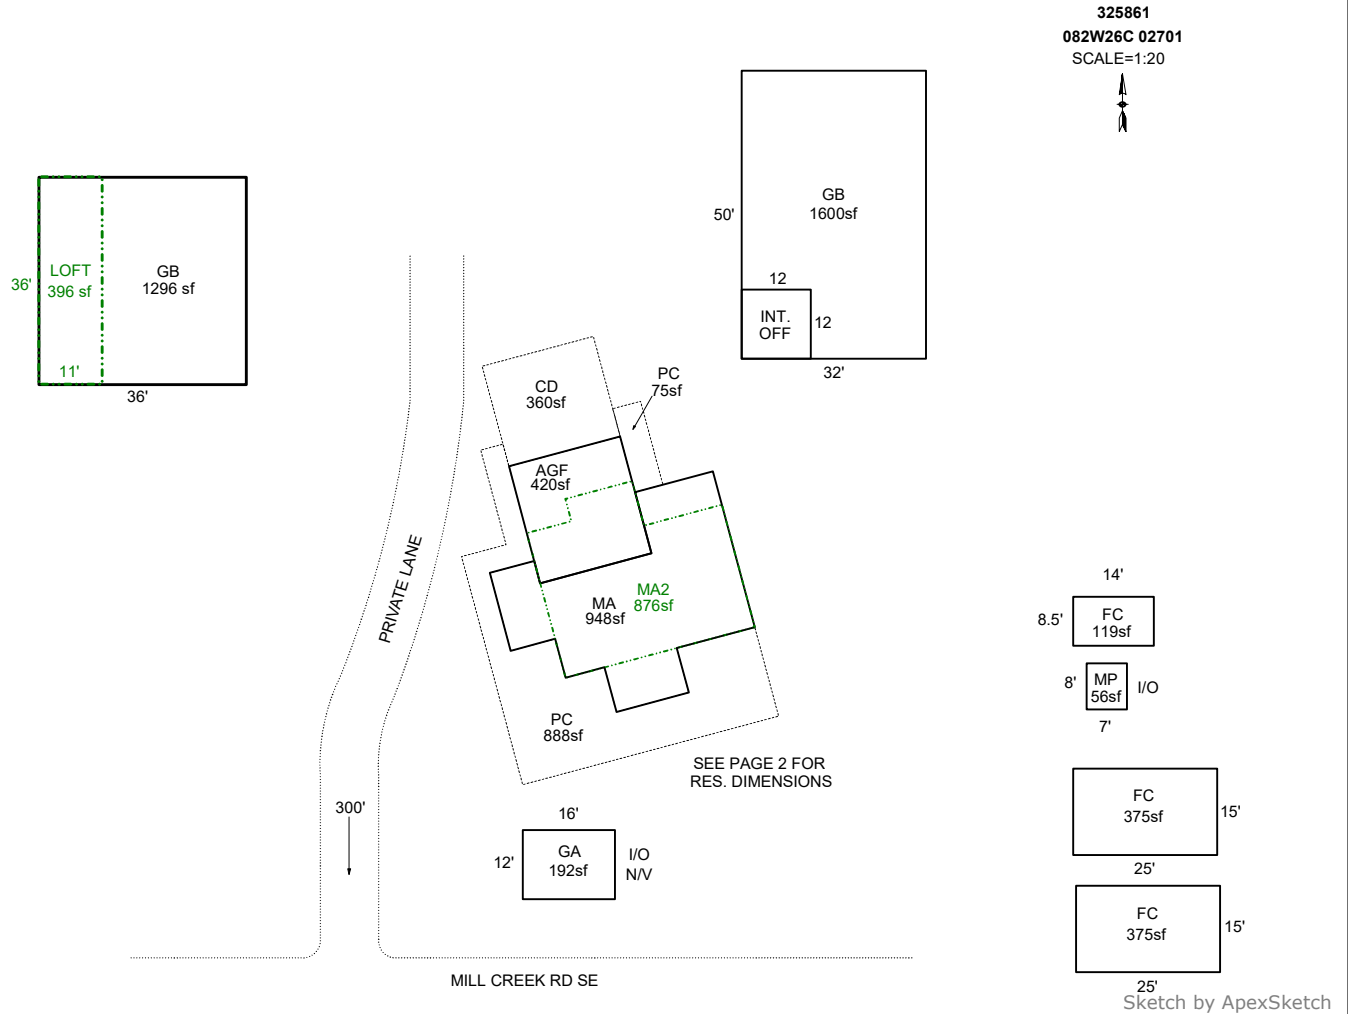

AREA CALCULATIONS SUMMARY

Code	Description	Factor	Net Size	Perimeter	Net Totals
GBA1	GB	1.0	1296.0	144.0	
	GB	1.0	1600.0	164.0	
	GA	1.0	192.0	56.0	
	FC	1.0	119.0	45.0	
	MP	1.0	56.0	30.0	
	FC	1.0	375.0	80.0	
	FC	1.0	375.0	80.0	4013.0
GBA2	LOFT	1.0	396.0	94.0	396.0
GLA1	MA	1.0	948.0	164.0	948.0
GLA2	MA2	1.0	876.0	128.0	876.0
GAR	AGF	1.0	420.0	82.0	420.0
P/P	PC	1.0	75.0	40.0	
	CD	1.0	360.0	76.0	
	PC	1.0	888.0	240.0	1323.0
	Net LIVABLE	cnt	0	(rounded)	1,824
	Net BUILDING	cnt	8	(rounded)	4,409

COMMENT TABLE 1

UPDATED BY JRONDEMA 2/27/17
 UPD BY PHU 12.15.20: 555-20-003661
 UPDATED BY CJURAN 04/22/2021
 UPDATED BY CLOBERG 02/12/25

COMMENT TABLE 2

#10 CL 01/28/2021
 MDL 01/08/25

COMMENT TABLE 3

TAGS L2
 TAGS L4

SKETCH/AREA TABLE ADDENDUM

SUBJECT INFO

File No.: 325861 Parcel No.: 082W26C 02701
 Property Address: 7922 Cargile Lane SE
 City: Aumsville County: State: OR ZipCode: 97325
 Owner:
 Client: Client Address:
 Appraiser Name: Inspection Date:

SKETCH


R325861

082W26C 02701

SCALE=1:20



SEE PAGE 1 FOR
ALL BLDGS

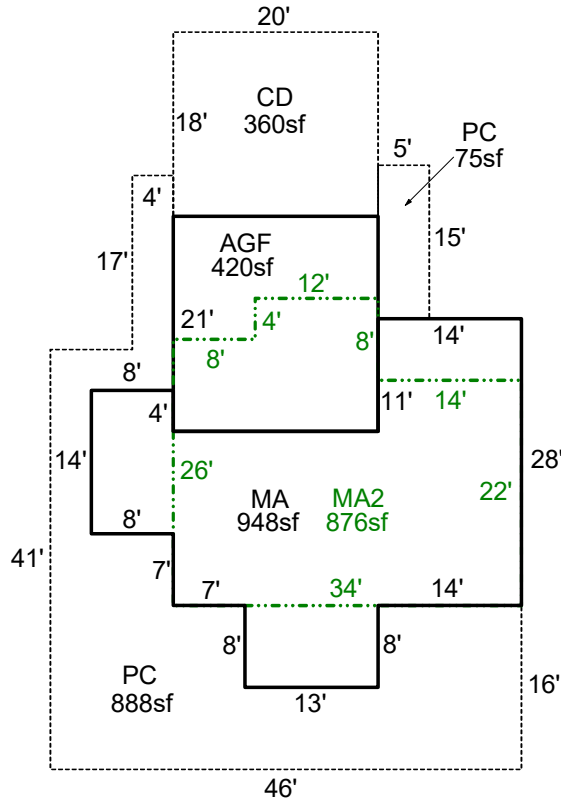

Sketch by ApexSketch

AREA CALCULATIONS SUMMARY

COMMENT TABLE 1

Code	Description	Factor	Net Size	Perimeter	Net Totals
GLA1	MA	1.0	948.0	164.0	948.0
GLA2	MA2	1.0	876.0	128.0	876.0
GAR	AGF	1.0	420.0	82.0	420.0
P/P	CD	1.0	360.0	76.0	
	PC	1.0	888.0	240.0	
	PC	1.0	75.0	40.0	1323.0

UPDATED BY JRONDEMA 2/27/17
 UPD BY PHU 12.15.20: 555-20-003661
 UPDATED BY CJURAN 04/22/2021
 UPDATED BY CLOBERG 02/12/25

COMMENT TABLE 2

COMMENT TABLE 3

#10 CL 01/28/2021
 MDL 01/08/25

TAGS L2
 TAGS L4


Net LIVABLE cnt 0 (rounded) 1,824

SKETCH/AREA TABLE ADDENDUM

SUBJECT INFO

File No.: R325861 Parcel No.: 082W26C 02701
 Property Address: 7922 Cargile Lane SE
 City: Aumsville County: State: OR ZipCode: 97325
 Owner:
 Client: Client Address:
 Appraiser Name: Inspection Date:

SKETCH

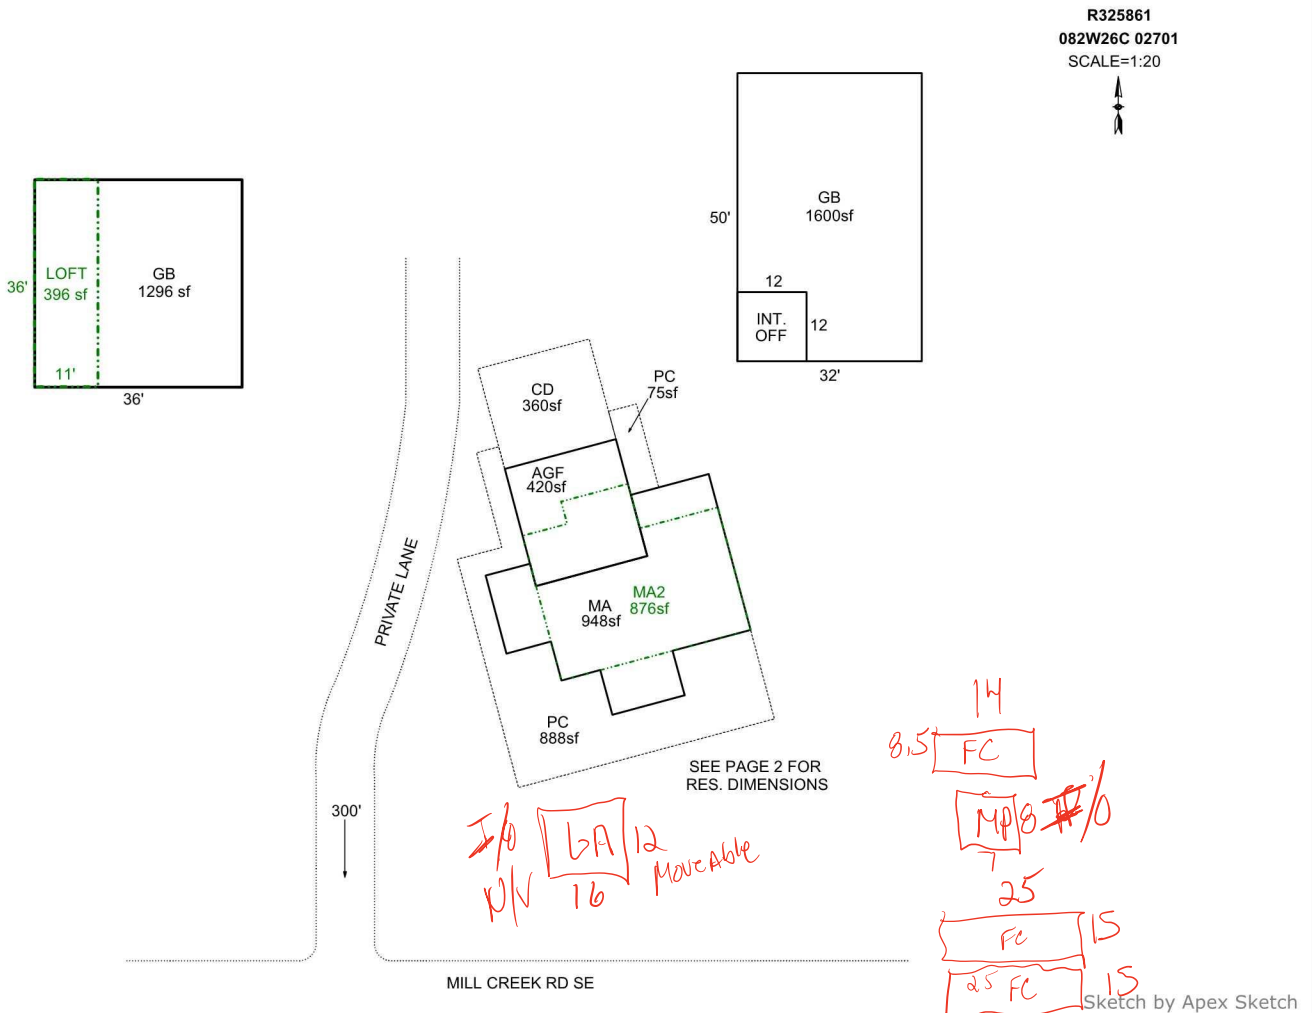

AREA CALCULATIONS SUMMARY

Code	Description	Factor	Net Size	Perimeter	Net Totals
GBA1	GB	1.0	1296.0	144.0	
	GB	1.0	1600.0	164.0	2896.0
GBA2	LOFT	1.0	396.0	94.0	396.0
GLA1	MA	1.0	948.0	164.0	948.0
GLA2	MA2	1.0	876.0	128.0	876.0
GAR	AGF	1.0	420.0	82.0	420.0
P/P	PC	1.0	75.0	40.0	
	CD	1.0	360.0	76.0	
	PC	1.0	888.0	240.0	1323.0

COMMENT TABLE 1

UPDATED BY JRONDEMA 2/27/17
 UPD BY PHU 12.15.20: 555-20-003661
 UPDATED BY CJURAN 04/22/2021

COMMENT TABLE 2

#10 CL 01/28/2021

COMMENT TABLE 3

TAGS L2

Net LIVABLE cnt 2 (rounded) 1,824
 Net BUILDING cnt 3 (rounded) 3,292

SKETCH/AREA TABLE ADDENDUM

SUBJECT INFO

File No.: R325861

Parcel No.: 082W26C 02701

Property Address: 7922 Cargile Lane SE

City: Aumsville

County:

State: OR

ZipCode: 97325

Owner:

Client:

Client Address:

Appraiser Name:

Inspection Date:

SKETCH


R325861

082W26C 02701

SCALE=1:20



SEE PAGE 1 FOR
ALL BLDGS

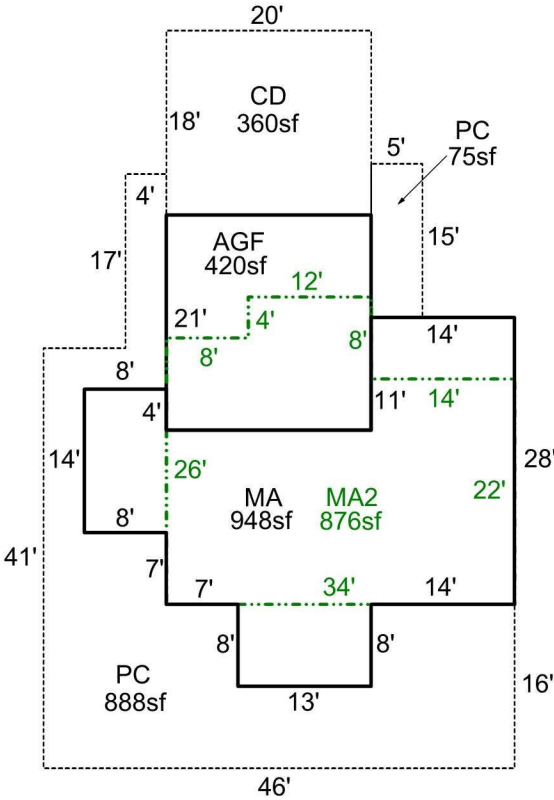

Sketch by Apex Sketch

AREA CALCULATIONS SUMMARY

Code	Description	Factor	Net Size	Perimeter	Net Totals
GLA1	MA	1.0	948.0	164.0	948.0
GLA2	MA2	1.0	876.0	128.0	876.0
GAR	AGF	1.0	420.0	82.0	420.0
P/P	CD	1.0	360.0	76.0	
	PC	1.0	888.0	240.0	
	PC	1.0	75.0	40.0	1323.0

COMMENT TABLE 1

UPDATED BY JRONDEMA 2/27/17
UPD BY PHU 12.15.20: 555-20-003661
UPDATED BY CJURAN 04/22/2021

COMMENT TABLE 2

#10 CL 01/28/2021

COMMENT TABLE 3

TAGS L2

Net LIVABLE	cnt	2	(rounded)	1,824
-------------	-----	---	-----------	-------















R325861 32x50 GB
2021-01-28 L2



R32561 36x36 GB
2021-01-28 L2

