

Acct ID: 538282 MTL: 071E020000600 Date: 1/9/25 Appr: MLH Prop Class: 451 RMV Prop Class: 451
 Situs: 19837 ABIQUA RD NE SCOTTS MILLS OR 97375 MaSaNh: 03 06 000 Unit: 55428 Year: 2025
 Last Date Appraised: 05/21/2024 Appraiser: MATTHEW HAMILTON Retag: Y N Tag info: 2025 - Tags/Permit (Alt Energy System)
 Owner: SHADRIN, GEORGE Roll Type: R
 Cycle Tag Sales Verification Other: _____ Inspection level: 1 2 3 4 LCB TTO INSP AV: 210990
 RMV Land: 400950 RMV Imp: 272331 RMV Total: 673281 MAV: 210990 MSAV: 0 SAV: 0
 Comment: 24-25: L2 5.21.24 MLH

*NEW Solar @100% update inventory
close Tag
Input MLH 2/7/25*

Notations

No notation data available.

OSDs

Count	Code	Description	RMV	Code Area	Exception
1	MKTA	OSD - AVERAGE	50000	04500	0

Land

Site: 1	Code Area: 04500	Size: 5.29 Acres	Use Code: 005	Zone: REST	SAV Use:	Exception: 0
Class: 2BD	Value Source: Rural Restrictive	Description: TWO BENCH DRY	RMV: 295920	Exception: Y	N	
Adjustment(s):	H2OAR, GSOIL, FSOIL		Fire Patrol:	Description:		
Comments:	22-23 CHANGED WATER ADJUSTMENT TO AVERAGE					
05-06: RECALC SETUP: APPR DB 36; 05-13-04. 07-08: PER #31 ON WATER FRONTAGE PROJECT, ADD WATER ADJ						
Site: 2	Code Area: 04500	Size: 1.20 Acres	Use Code: 005	Zone: REST	SAV Use:	Exception: 0
Class: 6B	Value Source: Rural Restrictive	Description: SIX BENCH	RMV: 55030	Exception: Y	N	
Adjustment(s):	H2OAR, GSOIL, FSOIL		Fire Patrol:	Description:		
Comments:						

Improvements - Residence / Manufactured Structures

Bldg: 1	Code Area: 04500	Stat Class: 122 +	Year Blt: 1973	Eff Year Blt: 1973	Sq.Ft: 3210	% Complete: 100
Desc: Multi Story above grade			Dimensions:	RMV: 227960		
Func Obsc: 100	Econ %: 100	Other %: 100	Exception: 0	Adjust:	Adjust RMV: 0	<i>n/c</i>

Floors

Type	Class	Display Group	Floor Size	Beds	Baths	Yr Blt	Eff Yr Blt	Inventory	Exception: Y N
First Floor	2 +	Finished	2040	1	FB-1	1973	1973	HVAC, ROOF, KIT-, BATH - 1	Y N
Attic	2 +	Low Cost	1170	4	0	1973	1973	HVAC	Y N
Carport Attached	2 +	Unfinished	300	0	0	1973	1973	ROOF	Y N

Accessories

Description	Class	Size SqFt	Eff Yr Blt	RMV	Quantity	Exception: Y N
YARD IMPROVEMENTS AVERAGE	2	0	1973	8025	1	Y N

Improvements - Accessory Buildings

Bldg: 3	Code Area: 04500	Stat Class: 357	Year Blt: 1999	Eff Year Blt: 1999	Sq.Ft: 256	% Complete: 100
Desc: Frost Control			Dimensions: 16x16	RMV: 411		
Func Obsc: 100	Econ %: 100	Other %: 100	Exception: 0	Adjust:	Adjust RMV: 0	<i>I/O</i>

Floors

Type	Class	Display Group	Floor Size	Beds	Baths	Yr Blt	Eff Yr Blt	Inventory	Exception: Y N
Frost Control	4	Finished	256	0	0	1999	1999		Y N

Accessories

Description	Class	Size SqFt	Eff Yr Blt	RMV	Quantity	Exception: Y N
No accessory data available						

Bldg: 4	Code Area: 04500	Stat Class: 341	Year Blt: 1984	Eff Year Blt: 1984	Sq.Ft: 256	% Complete: 100
Desc: Multi Purpose Shed (MP)			Dimensions: 16x16	RMV: 1110		
Func Obsc: 100	Econ %: 100	Other %: 100	Exception: 0	Adjust:	Adjust RMV: 0	<i>n/c</i>

Floors

Type	Class	Display Group	Floor Size	Beds	Baths	Yr Blt	Eff Yr Blt	Inventory	Exception: Y N
Multi-Purpose Bldg	4	Finished	256	0	0	1984	1984	FAIR	Y N

Accessories

Description	Class	Size SqFt	Eff Yr Blt	RMV	Quantity
No accessory data available					

Bldg: 5 Code Area: 04500 Stat Class: 354 Year Blt: 1999 Eff Year Blt: 1999 Sq.Ft: 240 % Complete: 100
 Desc: Lean-to Light (LTL) Dimensions: 20x12 RMV: 490
 Func Obsc: 100 Econ %: 100 Other %: 100 Exception: 0 Adjust: Adjust RMV: 0

N/C

Floors

Type	Class	Display Group	Floor Size	Beds	Baths	Yr Blt	Eff Yr Blt	Inventory
Lean-to Light Duty	4	Finished	240	0	0	0	0	Exception: Y N

Accessories

Description	Class	Size SqFt	Eff Yr Blt	RMV	Quantity
No accessory data available					

Bldg: 6 Code Area: 04500 Stat Class: 351 Year Blt: 2013 Eff Year Blt: 2013 Sq.Ft: 1920 % Complete: 100
 Desc: General Purpose Building (GB) Dimensions: 48x40 RMV: 35260
 Func Obsc: 100 Econ %: 100 Other %: 100 Exception: 0 Adjust: Adjust RMV: 0

N/C

Floors

Type	Class	Display Group	Floor Size	Beds	Baths	Yr Blt	Eff Yr Blt	Inventory
General Purpose Bldg	5	Finished	1920	0	0	2013	2013	AVG Exception: Y N

Accessories

Description	Class	Size SqFt	Eff Yr Blt	RMV	Quantity
No accessory data available					

Bldg: 7 Code Area: 04500 Stat Class: 341 Year Blt: 2013 Eff Year Blt: 2013 Sq.Ft: 432 % Complete: 100
 Desc: Multi Purpose Shed (MP) Dimensions: 36x12 RMV: 6650
 Func Obsc: 100 Econ %: 100 Other %: 100 Exception: 0 Adjust: Adjust RMV: 0

N/C

Floors

Type	Class	Display Group	Floor Size	Beds	Baths	Yr Blt	Eff Yr Blt	Inventory
Multi-Purpose Bldg	4	Finished	432	0	0	2013	2013	FAIR Exception: Y N

Accessories

Description	Class	Size SqFt	Eff Yr Blt	RMV	Quantity
No accessory data available					

Bldg: 9 Code Area: 04500 Stat Class: 341 Year Blt: Eff Year Blt: 1983 Sq.Ft: 100 % Complete: 100
 Desc: Multi Purpose Shed (MP) Dimensions: RMV: 410
 Func Obsc: 100 Econ %: 100 Other %: 100 Exception: 0 Adjust: Adjust RMV: 0

P/O

Floors

Type	Class	Display Group	Floor Size	Beds	Baths	Yr Blt	Eff Yr Blt	Inventory
Multi-Purpose Bldg	4	Finished	100	0	0	0	0	FAIR Exception: Y N

Accessories

Description	Class	Size SqFt	Eff Yr Blt	RMV	Quantity
No accessory data available					

Bldg: 10 Code Area: 04500 Stat Class: 354 Year Blt: Eff Year Blt: 1984 Sq.Ft: 48 % Complete: 100
 Desc: Lean-to Light (LTL) Dimensions: 8x6 RMV: 40
 Func Obsc: 100 Econ %: 100 Other %: 100 Exception: 0 Adjust: Adjust RMV: 0

N/C

Floors

Type	Class	Display Group	Floor Size	Beds	Baths	Yr Blt	Eff Yr Blt	Inventory
Lean-to Light Duty	4	Finished	48	0	0	0	1984	Exception: Y N

Accessories

Description	Class	Size SqFt	Eff Yr Blt	RMV	Quantity
No accessory data available					

905 SO 2024 20,000 EXEMPT




SKETCH/AREA TABLE ADDENDUM

SUBJECT INFO

File No.: 538282 Parcel No.: 071E02 00600
 Property Address: 19837 ABIQUA ROAD NE
 City: SCOTTS MILLS County: State: OR ZipCode: 97375
 Owner:
 Client: Client Address:
 Appraiser Name: Inspection Date:

SKETCH

538282
071E02 00600
 SCALE = 1:60

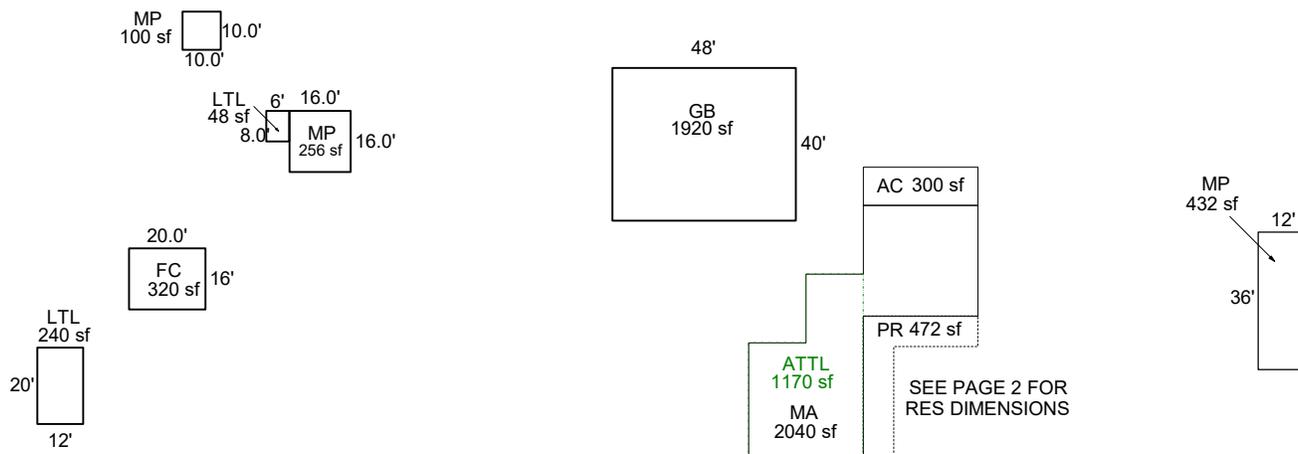

Sketch by ApexSketch

AREA CALCULATIONS SUMMARY						COMMENT TABLE 1	
Code	Description	Factor	Net Size	Perimeter	Net Totals		
GBA1	MP	1.0	256.0	64.0		Apex 5/18/2011 Jane Updated CW 1/6/14 UPDATED BY CJURAN 05/21/2024 UPD BY WW 5.28.24 UPDATED BY CLOBERG 02/07/25	
	FC	1.0	320.0	72.0			
	MP	1.0	100.0	40.0			
	LTL	1.0	48.0	28.0			
	LTL	1.0	240.0	64.0			
	MP	1.0	432.0	96.0			
	AC	1.0	300.0	80.0	1696.0		
GLA1	MA	1.0	2040.0	252.0	2040.0		
GLA2	ATTL	1.0	1170.0	156.0	1170.0		
GB	GB	1.0	1920.0	176.0	1920.0		
P/P	PR	1.0	472.0	134.0	472.0		
	Net LIVABLE	cnt	0 (rounded)		3,210		
	Net BUILDING	cnt	7 (rounded)		1,696		
						COMMENT TABLE 2	COMMENT TABLE 3
						MLH 5.21.24 MLH 01/09/25	SV L2 TAGS L3

SKETCH/AREA TABLE ADDENDUM

SUBJECT INFO


File No.: 538282 Parcel No.: 071E02 00600
 Property Address: 19837 ABIQUA ROAD NE
 City: SCOTTS MILLS County: State: OR ZipCode: 97375
 Owner:
 Client: Client Address:
 Appraiser Name: Inspection Date:

SKETCH

538282
071E02 00600
 SCALE = 1:20



SEE PAGE 1 FOR
ALL BLDGS

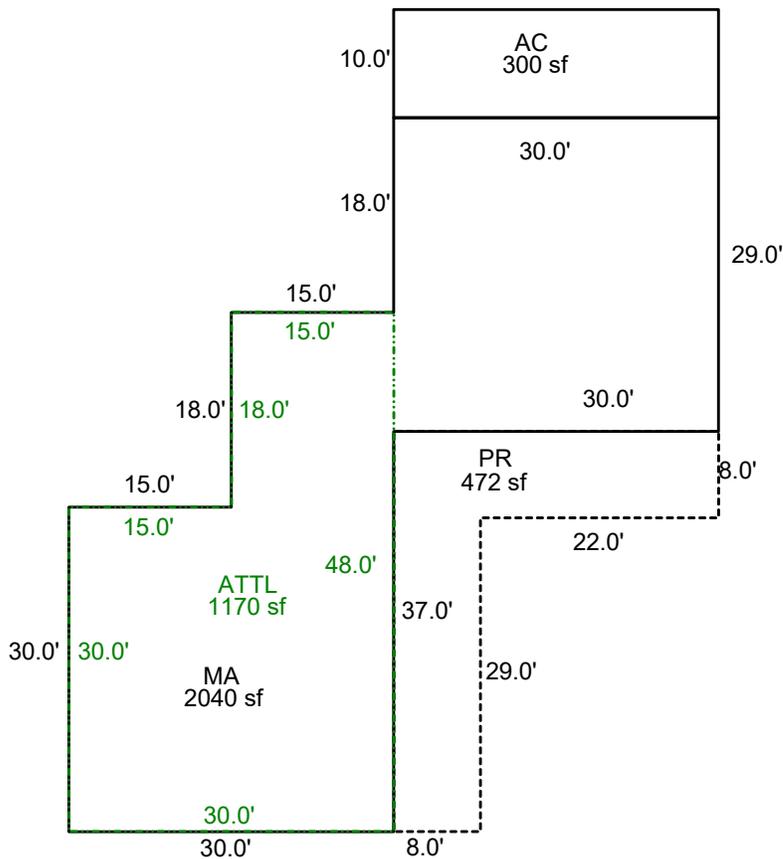

Sketch by ApexSketch

AREA CALCULATIONS SUMMARY

Code	Description	Factor	Net Size	Perimeter	Net Totals
GBA1	AC	1.0	300.0	80.0	300.0
GLA1	MA	1.0	2040.0	252.0	2040.0
GLA2	ATTL	1.0	1170.0	156.0	1170.0
P/P	PR	1.0	472.0	134.0	472.0

COMMENT TABLE 1

Apex 5/18/2011 Jane
 Updated CW 1/6/14
 UPDATED BY CJURAN 05/21/2024
 UPD BY WW 5.28.24
 UPDATED BY CLOBERG 02/07/25

COMMENT TABLE 2

MLH 5.21.24
 MLH 01/09/25

COMMENT TABLE 3

SV L2
 TAGS L3

Net LIVABLE	cnt	0	(rounded)		3,210
Net BUILDING	cnt	1	(rounded)		300


SKETCH/AREA TABLE ADDENDUM

SUBJECT INFO

File No.: 538282 Parcel No.: 071E02 00600
 Property Address: 19837 ABIQUA ROAD NE
 City: SCOTTS MILLS County: State: OR ZipCode: 97375
 Owner:
 Client: Client Address:
 Appraiser Name: Inspection Date:

SKETCH

538282
071E02 00600
 SCALE = 1:60

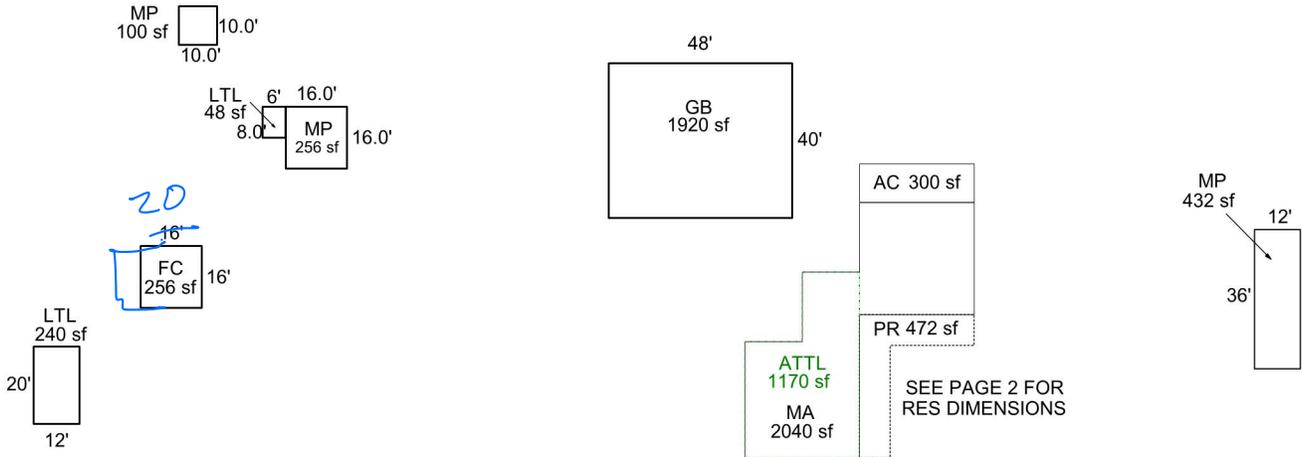

Sketch by ApexSketch

AREA CALCULATIONS SUMMARY

Code	Description	Factor	Net Size	Perimeter	Net Totals
GBA1	MP	1.0	256.0	64.0	
	FC	1.0	256.0	64.0	
	MP	1.0	100.0	40.0	
	LTL	1.0	48.0	28.0	
	LTL	1.0	240.0	64.0	
GLA1	MP	1.0	432.0	96.0	
	AC	1.0	300.0	80.0	1632.0
GLA1	MA	1.0	2040.0	252.0	2040.0
GLA2	ATTL	1.0	1170.0	156.0	1170.0
GB	GB	1.0	1920.0	176.0	1920.0
P/P	PR	1.0	472.0	134.0	472.0
	Net LIVABLE	cnt	2 (rounded)		3,210
	Net BUILDING	cnt	7 (rounded)		1,632

COMMENT TABLE 1

Apex 5/18/2011 Jane
 Updated CW 1/6/14
 UPDATED BY CJURAN 05/21/2024
 UPD BY WW 5.28.24

COMMENT TABLE 2

MLH 5.21.24








1/9/25 MLH

COMMENT TABLE 3

SV L2

TABLES L3

R38282
071E 02 00600
Scale 1:50

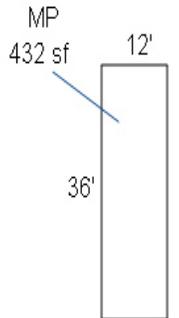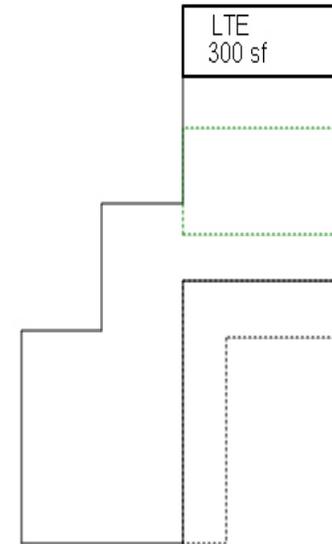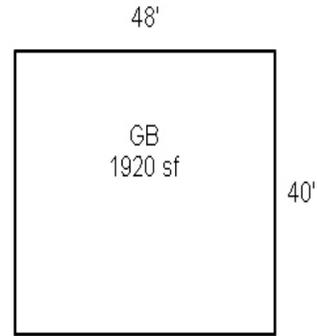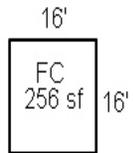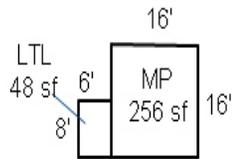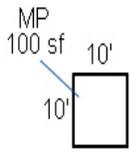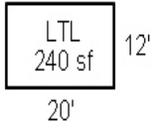


See Page 2 for Res Dimensions

R38282

071E02 00600

See Page 1 for All Bldgs

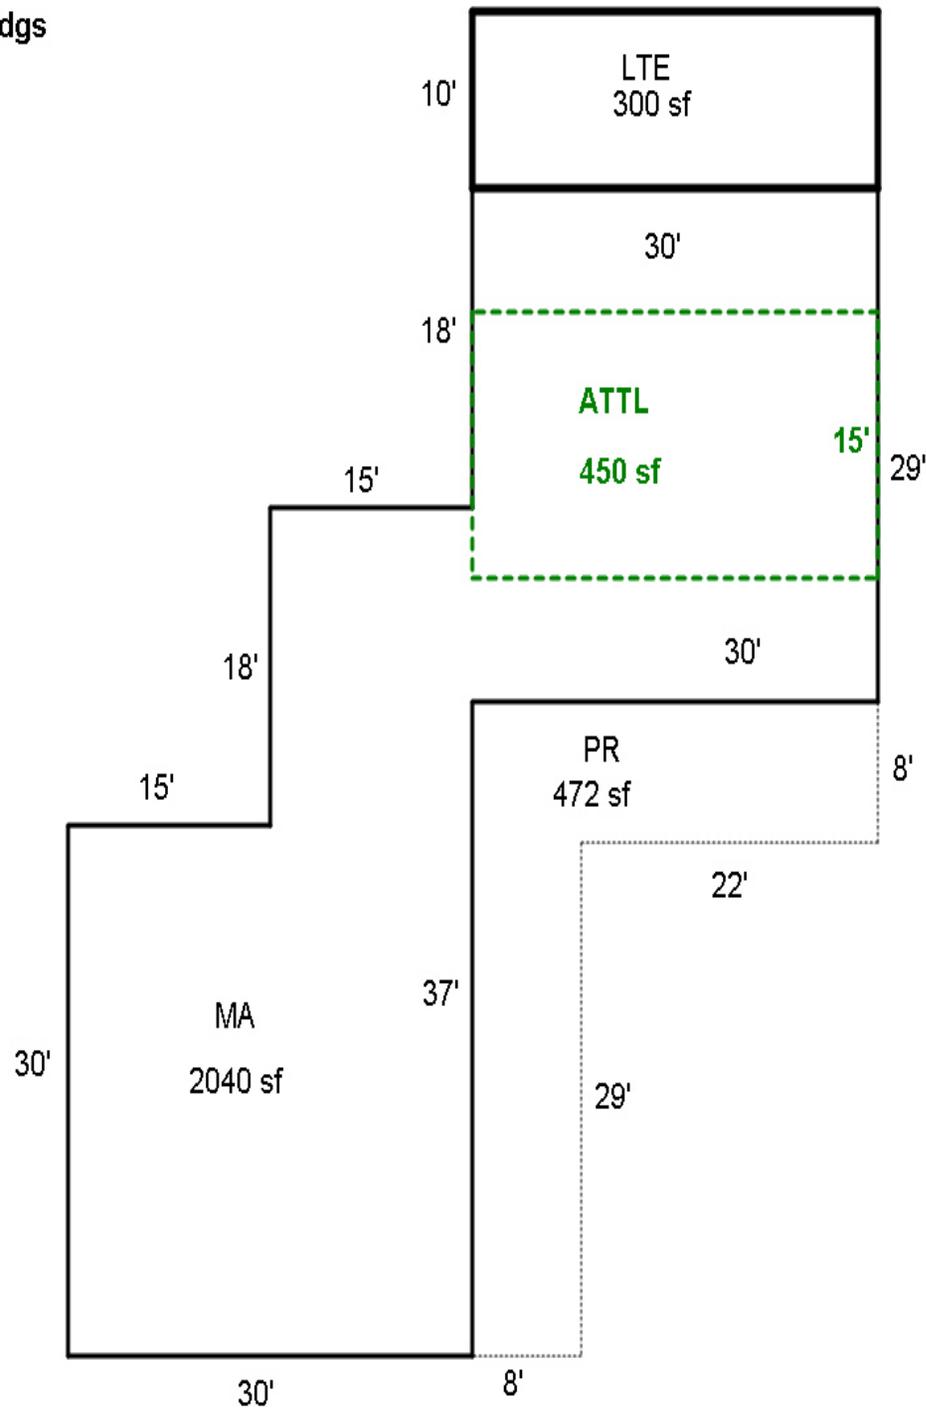

SKETCH/AREA TABLE ADDENDUM

SUBJECT INFO


File No.: 538282 Parcel No.: 071E02 00600
 Property Address: 19837 ABIQUA ROAD NE
 City: SCOTTS MILLS County: State: OR ZipCode: 97375
 Owner:
 Client: Client Address:
 Appraiser Name: Inspection Date:

SKETCH

538282
071E02 00600
 SCALE = 1:20



SEE PAGE 1 FOR
ALL BLDGS

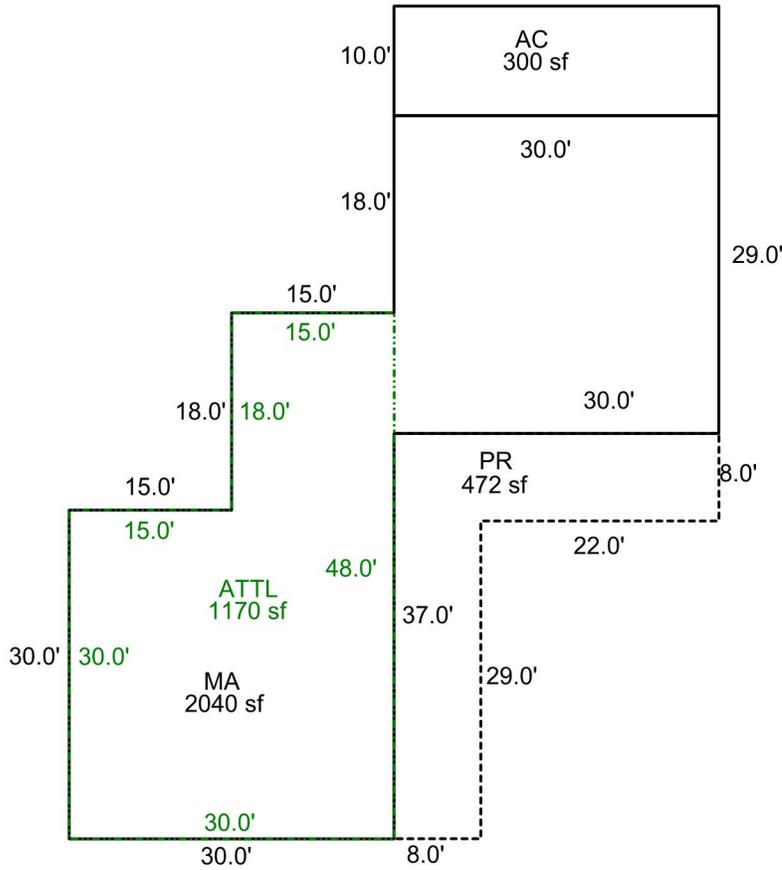

Sketch by ApexSketch

AREA CALCULATIONS SUMMARY

Code	Description	Factor	Net Size	Perimeter	Net Totals
GBA1	AC	1.0	300.0	80.0	300.0
GLA1	MA	1.0	2040.0	252.0	2040.0
GLA2	ATTL	1.0	1170.0	156.0	1170.0
P/P	PR	1.0	472.0	134.0	472.0

COMMENT TABLE 1

Apex 5/18/2011 Jane
 Updated CW 1/6/14
 UPDATED BY CJURAN 05/21/2024
 UPD BY WW 5.28.24

COMMENT TABLE 2

MLH 5.21.24

COMMENT TABLE 3

SV L2

Net LIVABLE	cnt	2	(rounded)		3,210
Net BUILDING	cnt	1	(rounded)		300













Acct ID: 538282 MTL: 071E02000600 Date: **5/21/24** Appr: **MLH** Prop Class: 451 RMV Prop Class: 451
 Situs: 19837 ABIQUA RD NE SCOTTS MILLS OR 97375 MaSaNh: 03 06 000 Unit: 55428 Year: 2024

Last Date Appraised: 12/04/2013 Appraiser: MATTHEW HAMILTON Retag: Y N Tag info: _____

Owner: SHADRIN, GEORGE Roll Type: R
 Cycle Tag **Sales Verification** Other: _____ Inspection level: 1 **2** 3 4 LCB **TTO** INSP AV: 205530

RMV Land: 399910 RMV Imp: 192137 RMV Total: 592047 MAV: 205530 MSAV: 0 SAV: 0

Comment: **MLS 809813 Sales code 33**
180 DOM
15,000 seller credit
update inventory
update apex

Notations No notation data available.

OSDs

Count	Code	Description	RMV	Code Area	Exception
1	MKTA	OSD - AVERAGE	45000	04500	0

Land

Site: 1 Code Area: 04500 Size: 6.49 Acres Use Code: 005 Zone: REST SAV Use: _____ Exception: 0
 Class: Value Source: Rural Restrictive Description: _____ RMV: 354910 Exception: Y N
 Adjustment(s): H2OAR Fire Patrol: _____ Description: _____
 Comments: 22-23 CHANGED WATER ADJUSTMENT TO AVERAGE
 05-06: RECALC SETUP: APPR DB 36; 05-13-04. 07-08: PER #31 ON WATER FRONTAGE PROJECT, ADD WATER ADJ

Improvements - Residence / Manufactured Structures

Bldg: 1 Code Area: 04500 Stat Class: 122 Year Blt: 1973 Eff Year Blt: 1973 Sq.Ft: 2490 % Complete: 100
 Desc: Multi Story above grade Dimensions: _____ RMV: 151090
 Func Obsc: 100 Econ %: 100 Other %: 100 Exception: 0 Adjust: _____ Adjust RMV: 0

Floors

Type	Class	Display Group	Floor Size	Beds	Baths	Yr Blt	Eff Yr Blt	Inventory	Exception
First Floor	2	Finished	2040	1	FB-1	1973	1973	HVAC, BATH - 1, KIT-, ROOF	Y N
Attic	2	Low Cost	450	40	0	1973	1973	HVAC	Y N

Accessories

Description	Class	Size SqFt	Eff Yr Blt	RMV	Quantity	Exception
ROOF EXTENSION OR PATIO COVER	2	472	1973	10266	0	Y N

Improvements - Accessory Buildings

Bldg: 3 Code Area: 04500 Stat Class: 357 Year Blt: 1999 Eff Year Blt: 1999 Sq.Ft: 256 % Complete: 100
 Desc: Frost Control Dimensions: 16x16 RMV: 427
 Func Obsc: 100 Econ %: 100 Other %: 100 Exception: 0 Adjust: _____ Adjust RMV: 0

Floors

Type	Class	Display Group	Floor Size	Beds	Baths	Yr Blt	Eff Yr Blt	Inventory	Exception
Frost Control	4	Finished	256	0	0	1999	1999		Y N

Accessories

Description	Class	Size SqFt	Eff Yr Blt	RMV	Quantity	Exception
No accessory data available						

Bldg: 4 Code Area: 04500 Stat Class: 341 Year Blt: 1984 Eff Year Blt: 1984 Sq.Ft: 256 % Complete: 100
 Desc: Multi Purpose Shed (MP) Dimensions: 16x16 RMV: 990
 Func Obsc: 100 Econ %: 100 Other %: 100 Exception: 0 Adjust: _____ Adjust RMV: 0

Floors

Type	Class	Display Group	Floor Size	Beds	Baths	Yr Blt	Eff Yr Blt	Inventory	Exception
Multi-Purpose Bldg	4	Finished	256	0	0	1984	1984	Fair pldy	Y N

Accessories

Description	Class	Size SqFt	Eff Yr Blt	RMV	Quantity	Exception
No accessory data available						

Bldg: 5 Code Area: 04500 Stat Class: 354 Year Blt: 1999 Eff Year Blt: 1999 Sq.Ft: 240 % Complete: 100
 Desc: Lean-to Light (LTL) Dimensions: 20x12 RMV: 510
 Func Obsc: 100 Econ %: 100 Other %: 100 Exception: 0 Adjust: _____ Adjust RMV: 0

Floors

Type	Class	Display Group	Floor Size	Beds	Baths	Yr Blt	Eff Yr Blt	Inventory	
Lean-to Light Duty	4	Finished	240	0	0	0	0		Exception: Y N

Accessories

Description	Class	Size SqFt	Eff Yr Blt	RMV	Quantity
No accessory data available					

Bldg: 6 Code Area: 04500 Stat Class: 351 Year Blt: 2013 Eff Year Blt: 2013 Sq.Ft: 1920 % Complete: 100
 Desc: General Purpose Building (GB) Dimensions: 48x40 RMV: 32020
 Func Obsc: 100 Econ %: 100 Other %: 100 Exception: 0 Adjust: Adjust RMV: 0

I/O

Type	Class	Display Group	Floor Size	Beds	Baths	Yr Blt	Eff Yr Blt	Inventory	
General Purpose Bldg	5	Finished	1920	0	0	2013	2013	<i>FAIR AOE</i>	Exception: Y N

Accessories

Description	Class	Size SqFt	Eff Yr Blt	RMV	Quantity
No accessory data available					

Bldg: 7 Code Area: 04500 Stat Class: 341 Year Blt: 2013 Eff Year Blt: 2013 Sq.Ft: 432 % Complete: 100
 Desc: Multi Purpose Shed (MP) Dimensions: 36x12 RMV: 5420
 Func Obsc: 100 Econ %: 100 Other %: 100 Exception: 0 Adjust: Adjust RMV: 0

I/O

Type	Class	Display Group	Floor Size	Beds	Baths	Yr Blt	Eff Yr Blt	Inventory	
Multi-Purpose Bldg	4	Finished	432	0	0	2013	2013	<i>Fair plaq</i>	Exception: Y N

Accessories

Description	Class	Size SqFt	Eff Yr Blt	RMV	Quantity
No accessory data available					

Bldg: 8 Code Area: 04500 Stat Class: 356 Year Blt: 1999 Eff Year Blt: 1999 Sq.Ft: 300 % Complete: 100
 Desc: Lean-to Excellent (LTE) *Change to AC* Dimensions: RMV: 1680
 Func Obsc: 100 Econ %: 100 Other %: 100 Exception: 0 Adjust: Adjust RMV: 0

I/O

Type	Class	Display Group	Floor Size	Beds	Baths	Yr Blt	Eff Yr Blt	Inventory	
Lean-to Excellent	4	Finished	300	0	0	1999	1999	<i>Roof</i>	Exception: Y N

Accessories

Description	Class	Size SqFt	Eff Yr Blt	RMV	Quantity
No accessory data available					

Bldg: 9 Code Area: 04500 Stat Class: 341 Year Blt: Eff Year Blt: Sq.Ft: 100 % Complete: 100
 Desc: Multi Purpose Shed (MP) Dimensions: RMV: 0
 Func Obsc: 100 Econ %: 100 Other %: 100 Exception: 0 Adjust: Adjust RMV: 0

N/2

Type	Class	Display Group	Floor Size	Beds	Baths	Yr Blt	Eff Yr Blt	Inventory	
Multi-Purpose Bldg	4	Finished	100	0	0	0	0		Exception: Y N

Accessories

Description	Class	Size SqFt	Eff Yr Blt	RMV	Quantity
No accessory data available					

354 LTZ 6x8 E4B 1984 Match MP I/O

SKETCH/AREA TABLE ADDENDUM

SUBJECT INFO

File No.: 538282 Parcel No.: 071E02 00600
 Property Address: 19837 ABIQUA ROAD NE
 City: SCOTTS MILLS County: State: OR ZipCode: 97375
 Owner:
 Client: Client Address:
 Appraiser Name: Inspection Date:








SKETCH

APEX UPDATED

538282
071E02 00600
 SCALE = 1:60



MP 100
8' 12'

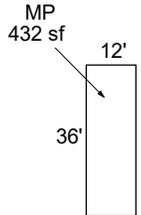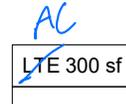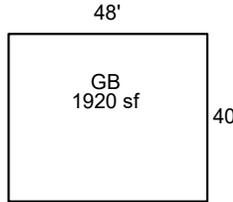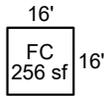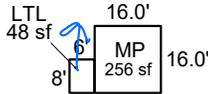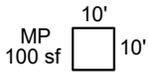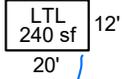

SEE PAGE 2 FOR RES DIMENSIONS

Sketch by Apex Sketch

AREA CALCULATIONS SUMMARY

COMMENT TABLE 1

Code	Description	Factor	Net Size	Perimeter	Net Totals
GBA1	MP	1.0	256.0	64.0	
	FC	1.0	256.0	64.0	
	MP	1.0	100.0	40.0	
	LTL	1.0	48.0	28.0	
	LTL	1.0	240.0	64.0	
	MP	1.0	432.0	96.0	
	LTE	1.0	300.0	80.0	1632.0
GLA1	MA	1.0	2040.0	252.0	2040.0
GLA2	ATTL	1.0	1170.0	156.0	1170.0
GB	GB	1.0	1920.0	176.0	1920.0
P/P	PR	1.0	472.0	134.0	472.0

Apex 5/18/2011 Jane
 Updated CW 1/6/14
 UPDATED BY CJURAN 05/21/2024

COMMENT TABLE 2

COMMENT TABLE 3

5/21/24 MLH

SV LZ


Net LIVABLE	cnt	2	(rounded)	3,210
Net BUILDING	cnt	7	(rounded)	1,632

SKETCH/AREA TABLE ADDENDUM

SUBJECT INFO

File No.: 538282 Parcel No.: 071E02 00600
 Property Address: 19837 ABIQUA ROAD NE
 City: SCOTTS MILLS County: State: OR ZipCode: 97375
 Owner:
 Client: Client Address:
 Appraiser Name: Inspection Date:

SKETCH

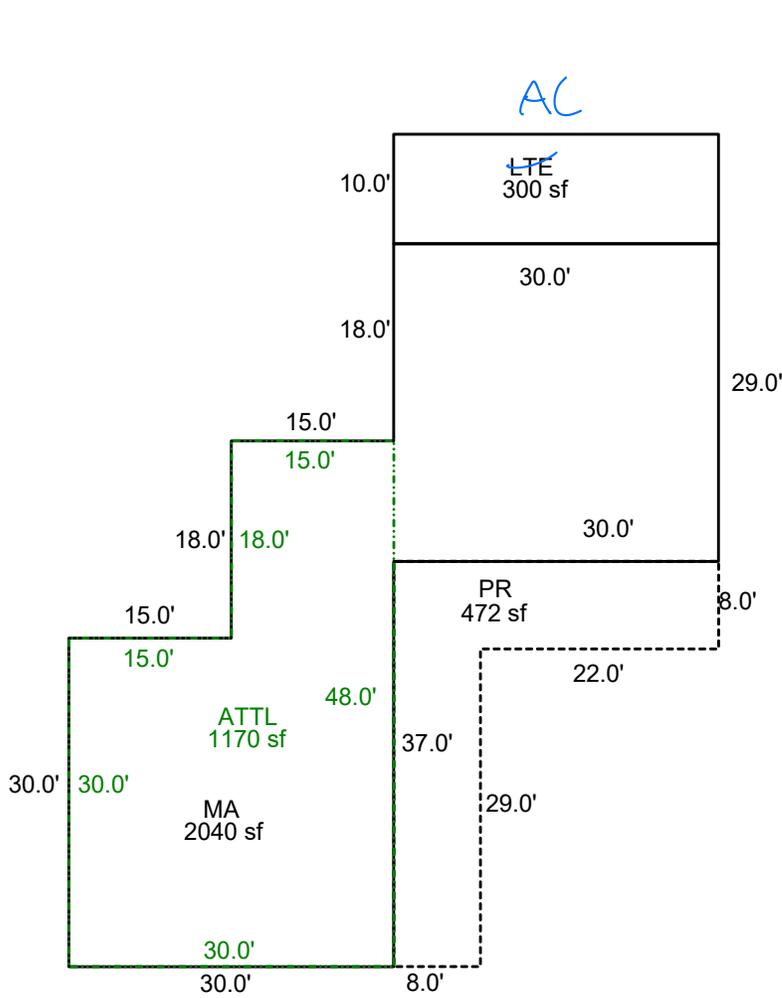

AREA CALCULATIONS SUMMARY

Code	Description	Factor	Net Size	Perimeter	Net Totals
GBA1	LTE	1.0	300.0	80.0	300.0
GLA1	MA	1.0	2040.0	252.0	2040.0
GLA2	ATTL	1.0	1170.0	156.0	1170.0
P/P	PR	1.0	472.0	134.0	472.0

COMMENT TABLE 1








Apex 5/18/2011 Jane
 Updated CW 1/6/14
 UPDATED BY CJURAN 05/21/2024

COMMENT TABLE 2

COMMENT TABLE 3

Net LIVABLE	cnt	2	(rounded)	3,210
Net BUILDING	cnt	1	(rounded)	300

R38282
071E 02 00600
Scale 1:50

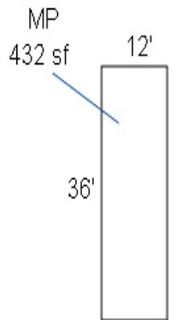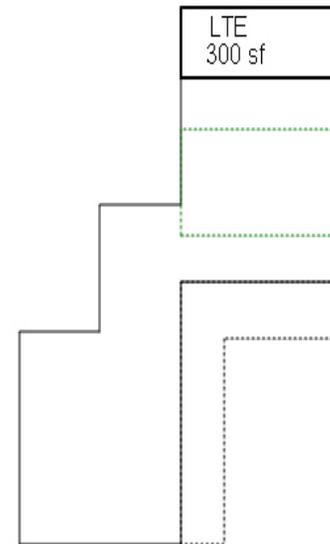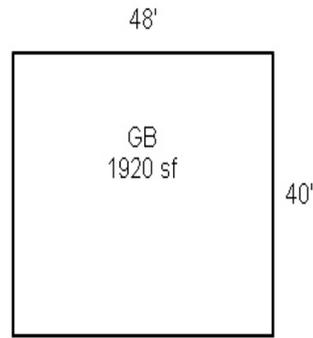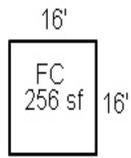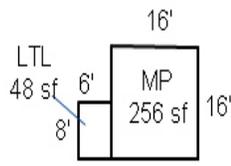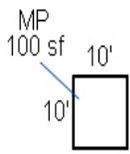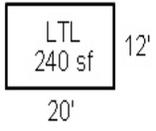

See Page 2 for Res Dimensions

R38282

071E02 00600

See Page 1 for All Bldgs

