

Accessories

Description	Class	Size SqFt	Eff Yr Blt	RMV	Quantity	Exception: Y N
ASPHALT DRIVEWAY <i>VIHA</i>	4	4200	2010 1996	9072	0	

Bldg: 8 Code Area: 05410 Stat Class: 905 Year Blt: 2010 Eff Year Blt: 2010 Sq.Ft: 0 % Complete: 100
Desc: Rural Solar Panel/Array Dimensions: RMV: 2500
Func Obsc: 100 Econ %: 100 Other %: 100 Exception: 0 Adjust: Adjust RMV: 0



Floors

Type	Class	Display Group	Floor Size	Beds	Baths	Yr Blt	Eff Yr Blt	Inventory
No floor data available								

Accessories

Description	Class	Size SqFt	Eff Yr Blt	RMV	Quantity
No accessory data available					

R29898
082W15B 02700

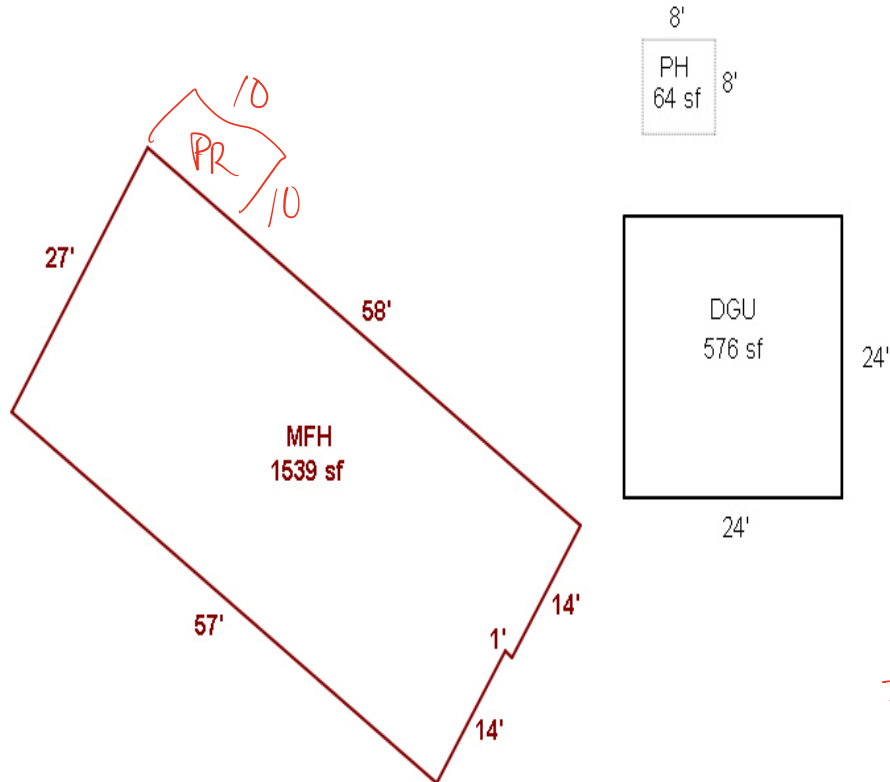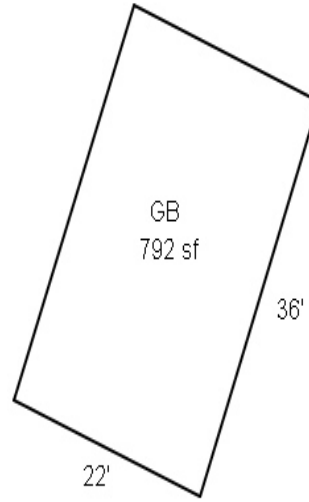

2/26/25
MLK
L4
SV



529898 DGU SE SIDE
2022-02-11 L2

2022. 2.11



529898 DGU S SIDE
2022-02-11 L2

2022. 2.11



529898 PR DW NE SIDE
2022-02-11 L2

2022. 2.11



529898 MA S SIDE
2022-02-11 L2

2022. 2.11



R29898

1/3/11





