


SKETCH/AREA TABLE ADDENDUM

SUBJECT INFO			
File No.: 611404		Parcel No.: 083W16CD17800	
Property Address: 5971 Joynak St S			
City: Salem	County: Marion	State: OR	ZipCode: 97306
Owner:			
Client:	Client Address:		
Appraiser Name:		Inspection Date:	

SKETCH

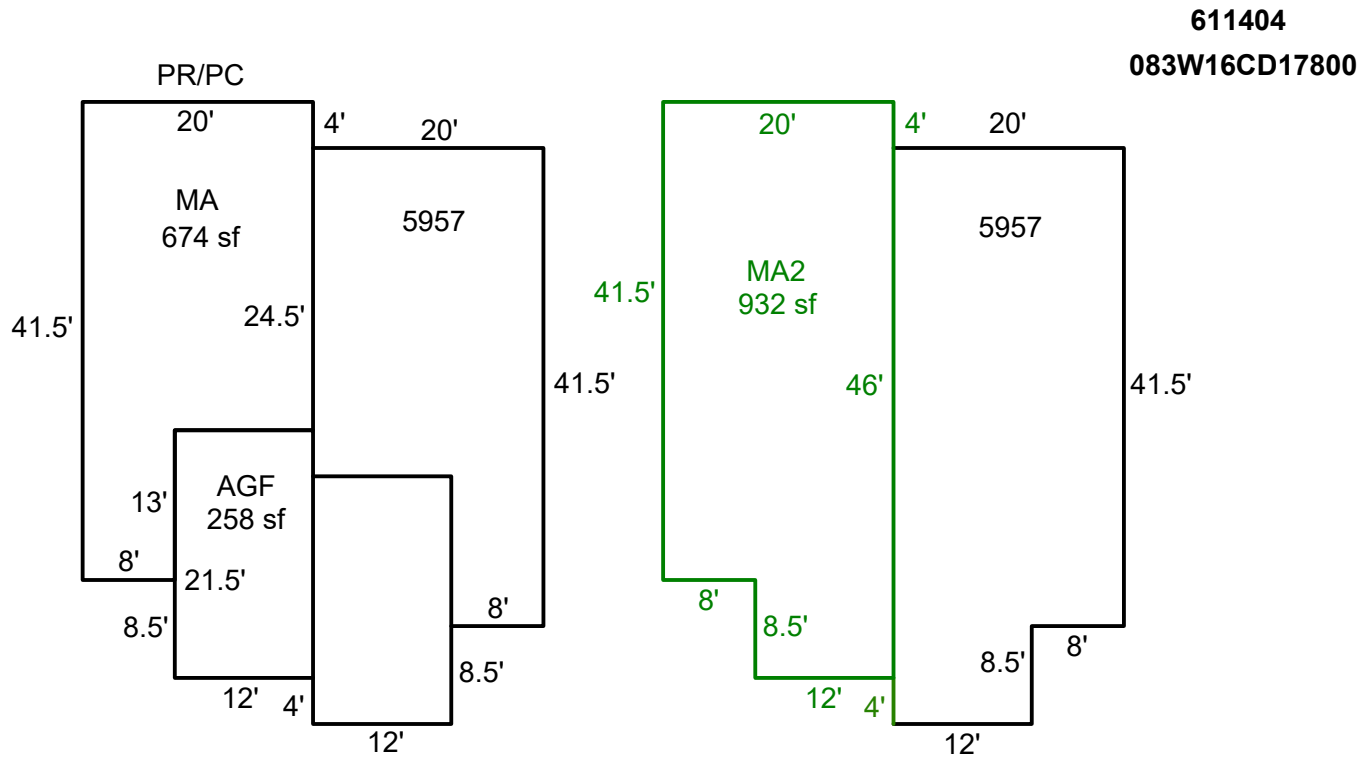

Sketch by ApexSketch

[illegible]