
LAK 4.3.25 Lead Clerk: Summarv Lead Appr:_ Print Date: ts 4-8-25 2/7/2025 Acct ID: 125441 MTL: 083W23DC03800P1 RMV Prop Class: 019 Prop Class: 019 Situs: 6835 20TH AVE SE SALEM, OR 97306 MaSaNh: 16 05 003 Unit: 140377 Year: 2025 Appraiser: THERESA SWEARINGEN Last Date Appraised: 09/30/2024 Retag: Y N Tag info: Owner: LA CROSS, RANDE LEE Roll Type: MS Cycle Tag Sales Verification Other:__ __ Inspection level: 1 2 3 4 CB TTO INSP AV: 33840 RMV Land: 0 MAV: 33840 RMV Imp: 65900 RMV Total: 65900 MSAV: 0 SAV: 0 Comment: 25-26: Cycle; L3 09.30.24 GM 23-24: L2 01.03.23 TS **Notations** No notation data available. **OSDs** No OSD data available. Land No land data available. Improvements - Residence / Manufactured Structures Bldg: 1 Code Area: 24010 Stat Class: 466 Year Blt: 1973 Eff Year Blt: 1993 Sq.Ft: 1344 % Complete: 100 Desc: MANUF STRUCT, CLASS 6, 24' WIDE DOUBLE Dimensions: 56x24 RMV: 65900 Func Obsc: 100 Econ %: 100 Other %: 100 Exception: 0 Adjust: Adjust RMV: 0 Floors Yr Blt Eff Yr Blt Inventory Туре Class Display Floor Beds Baths Group Size SKRT+, ROOF+, HVAC+, KIT+, FP - 1, BATH - 2 First Floor Finished 1344 FB-2 Exception: Y N Accessories Description Class Size SqFt Eff Yr Blt ROOF EXTENSION OR PATIO COVER Exception: Improvements - Accessory Buildings No improvement data available for all other stat class types.



OUTHBROOK M.H. PARK

BUILDER: G.W. Sunny brook

YR BLT: 1773 ADDRESS: 6835 207 AVE

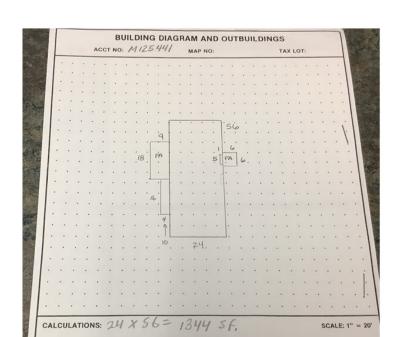

1, w, v 8 - 1, y

New Floors
New CDOKAY
WI Show
Talets
OVALLIE



Situs: 6835 20TH AVE SE SALEM, OR 97306

Date Printed: 2/6/2025

Appraiser Sales Verification From

Primary Acct: 125441

MTL: 083W23DC03800

MaSaNh/P.Class: 1605003/019

Appraiser: THERESA SWEARINGEN

MS Acct: 125441

Grantor: Grantee:

MENDOZA, WALTER

LA CROSS, RANDE LEE

Sale ID: 31940 Tax Statement RMV

Deed: Land & OSD: 0

Accts In Sale: 1 Imp: 91,930

Accts In Sale: 1 Imp: 91,930 Sale Date: 11/15/2024 Total: 91,930

Sale Price: 110,000 Ratio (Cert. Total RMV/Sale Price): 84

Condition Code: 00

Attempt	Date/Time	Reason
1 st	3/11/25 1,00	LOB
2 nd		

Contact:	Phone/email:		
1.	Was the property listed on the open market? Days: MLS: 819779	Υ	N
	Was property other than real estate included in the sale? Describe: Est. \$:	Υ	N
3.	Did the seller pay closing costs or make other concessions? \$	Υ	N
4.	Was the sale between related parties? (business or family)	Υ	N
5.	Was this a distressed sale? E.g. foreclosure, short, court order, etc	Υ	N
6.	Condition at time of sale: Poor Fair Avg. Good Exc. Describe:	Y 	N
7.	Have any improvements been made since the time of sale? If yes, describe:	 	N
Commer	nts:		_

Appraiser: 02 Date: 3/26/05

3325V

12

1/3/21

0

TTO

Improvement Detail

MARION County

For Assessment Year 2023

lak

188918

Account ID 125441

Mailing

Map 083W23DC03800P1

MENDOZA, WALTER MENDOZA, TRINA

6835 20TH AVE SE SALEM OR 97306

Situs 6835 20TH AVE SE SALEM OR 97306

Appraiser THERESA S

THERESA SWEARINGEN

Inspected 10/02/2015

Appraisal Area 06-05-003

Stat Class 466 - MANUF STRUCT, CLASS 6, 24' WIDE DOUBLE

ts 3-31-23

	Code	Year	Eff						Taxable				
Bldg	Area	Built	Year	Comp %	% Good	LCM	Value	RMV	RMV	MAV Exc	eption	AV	Sqft
1	24010	1973	1973	100	20	243	Tabled	30,510	30.510	31,910	0	30.510	1.344

Rooms: 2 - BD, 2 - FB

12/8/2022

Floor Segments

Description	Yr Blt	Eff Yr	% Good	Class	Comp %	OR %	Sqft	RCN
First Floor	1973	1973	20	6	100		1,344	129,796

Improvement inventory

F	Description	Qty/Size	RMV	F	Description	Qty/Size	RMV
1st	BATH - FULL	2	1,458	1st	HOOD & FAN	1	389
1st	COOKTOP -	1	114	1st	ROOF COVER - METAL	1,344	(327)
1st	DISHWASHER	1	433	1st	SINGLE OVEN	1	146
1st	DISPOSAL	1	102	1st	SKIRTING - CINDER BLOCK	160	448
1st	HEARTH, PLAIN 🖊	1	194	1st	WOOD PANELING	1344 ~	0
1st	HEAT PUMP /	1.344	653			•	

Accessories

Description	Eff Yr	Size	Qty	RMV
ALLIMINI IM PATIO COVER	1073	262 /		943

Totals

Description	RMV	Size Breakdown			
First Floor	\$29,569	Finished	1,344		
Inventory	\$0				
Accessories	\$943				
Trend	100.00 %				
Total RMV	\$30,510				

Comments 16-17 CYCLE WORK N.C.// 01-02: REAPPRAISAL

wpdate Fnv & Elb

Page 1 of 1



